IREDELL COUNTY HEALTH DEPARTMENT

→ AUTHORIZATION TO CONSTRUCT

2000-2730

STATESVILLE 704-878-5305 MOORESVILLE 704-664-5281

IMPROVEMENT PERMIT / ~~CERTIFICATE OF COMPLETION~~ / OPERATION PERMIT / EXISTING SYSTEM INSPECTION

PROPERTY DESCRIPTION NO. 24385 DATE 1/30/97 TAX MAP NO. pt of 2CA3

OWNER OR CONTRACTOR JIM BECHTOLD Watershed: ☐ Yes ☐ No

ADDRESS ~~CHARLOTTE~~ 5031 FOXBRIAR TR. CHARLOTTE NC 28269 PHONE: Business Home 596-4891

LOCATION BRAWLEY SCHOOL RD - TR BAY HARBOUR - TR HUNTER'S PT LN. AT END ON LT

SUBDIVISION HARBOUR BLOCK / SECTION V LOT 44 LOT AREA 43,008 FT² SITE CLASS. PS DESIGN FLOW 480 GPD L.T.A.R. .3 GPD/FT²

Septic Tank: ~~1000~~ 1500 Gallons; STB 197 Date 2/14/97

Pump Tank: Gallons; PT Date

Pump Make: Model Serial No.

Nitrification Field: No Fields 1 Square Feet 1230 Linear Feet 410

No Lines 7 Trench Width 36" Max Trench Bottom Depth 36" ~~Gravel Depth~~ SAND

☑ New System ☐ Repair System Type: I, II, (III), IV, V, VI

System Description: GRAVITY CHAMBERED OR SIMILAR

Repair System Description: PUMP CHAMBERED

Maintenance Agreement Required: ☐ Yes ☑ No

☐ Slab ☑ Crawl Space ☐ Basement w/plumbing ☐ Basement wo/plumbing

☑ House/Mod. Home No. Bedrooms 4
☐ Mobile Home No. Bathrooms 4
☐ Business No. Employees
☐ Other


Water Supply:
☐ Individual
☑ Community
☐ Public

Comments:

Comments: 80 60
80 40
80
70

INITIAL SITE SKETCH

AS BUILT SKETCH

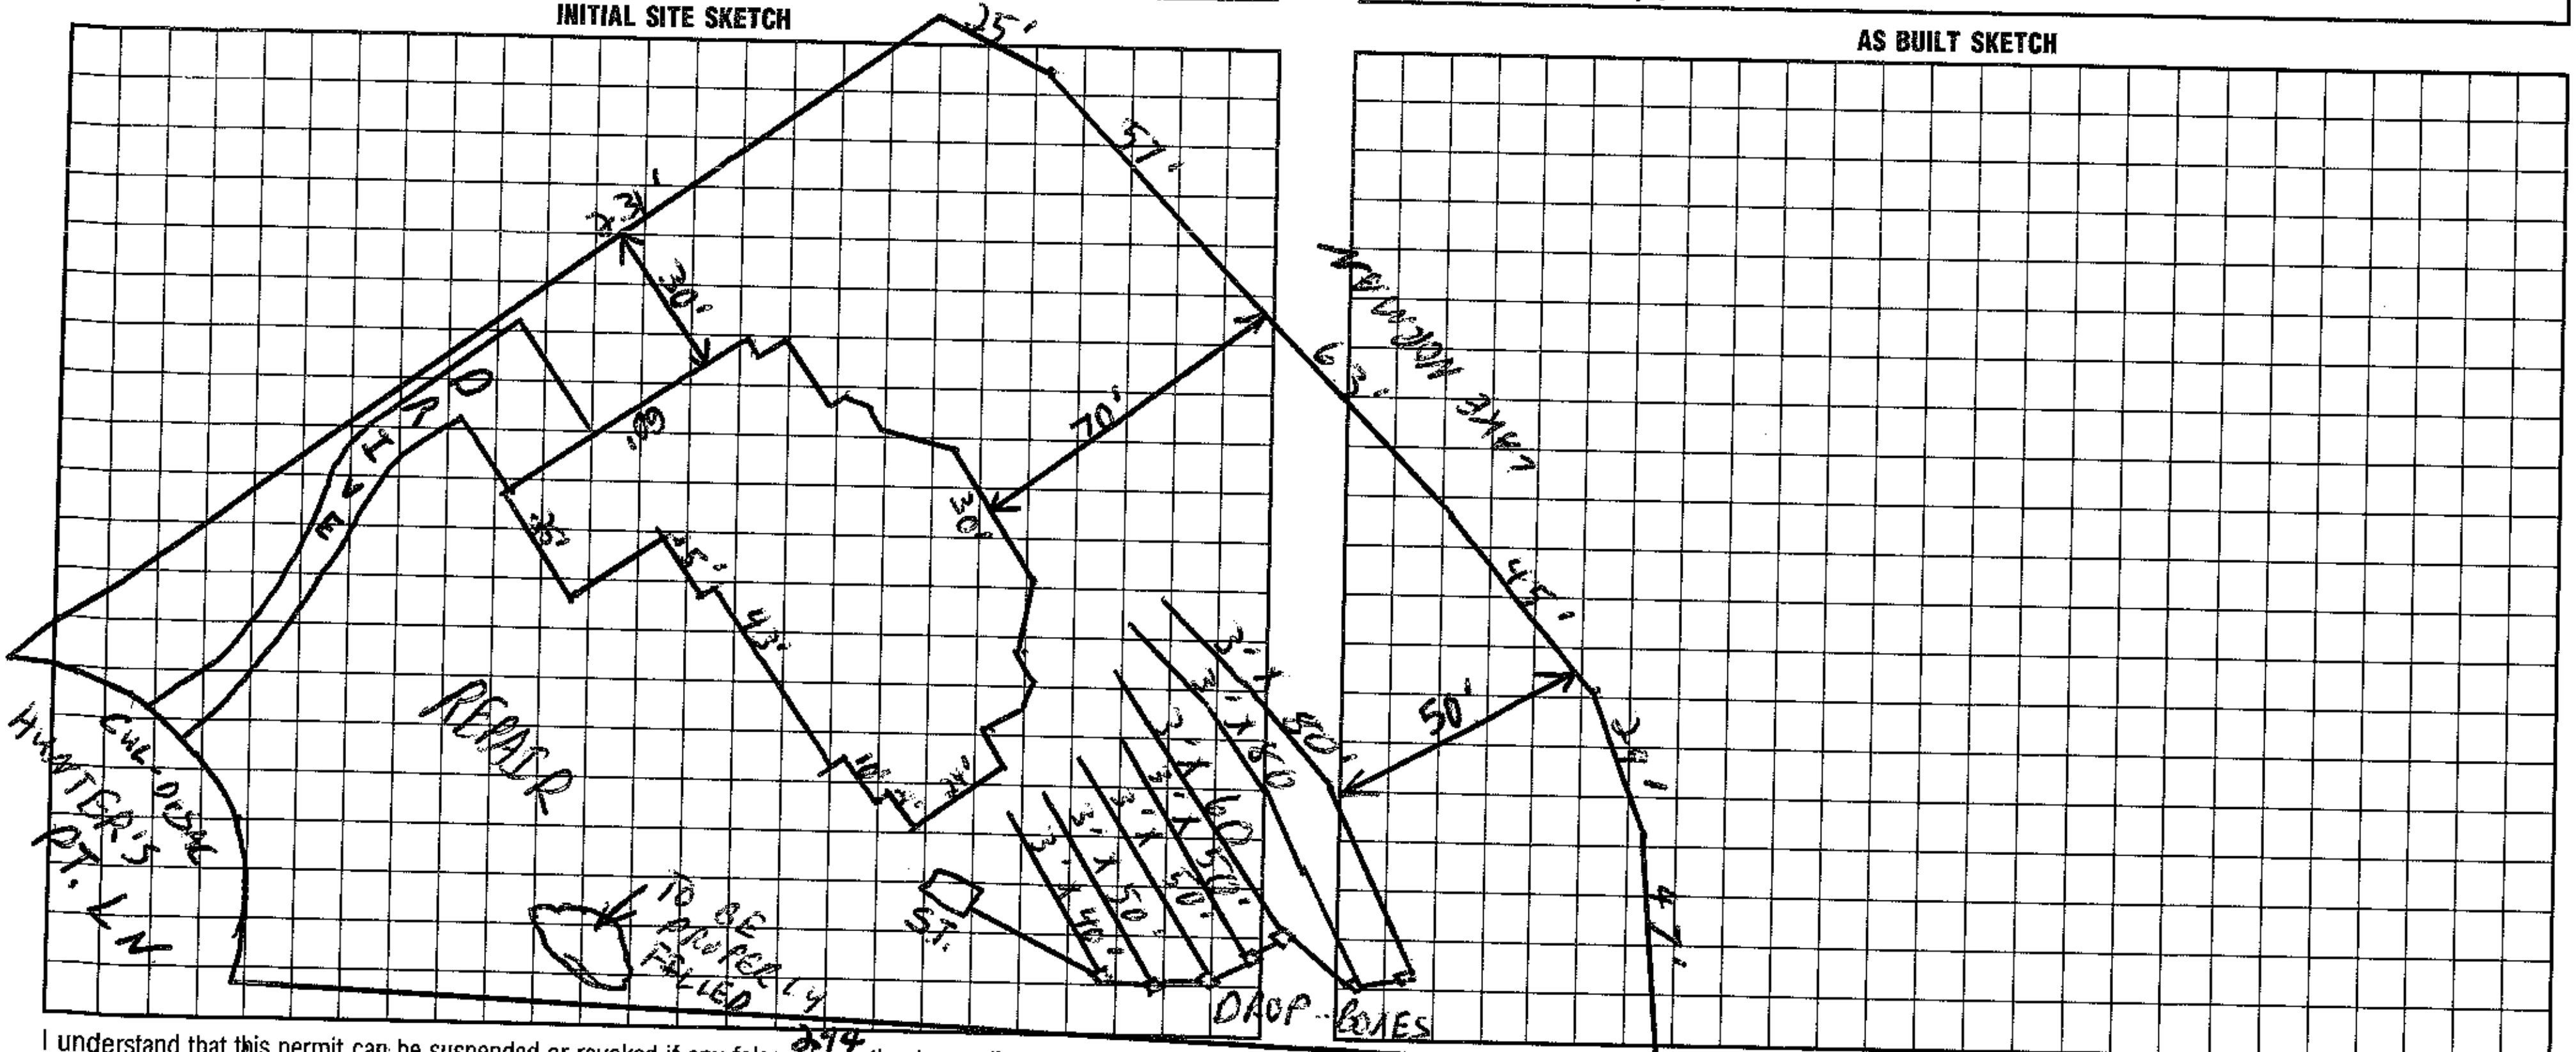

I understand that this permit can be suspended or revoked if any false information is supplied toward securing the permit/any unauthorized changes are made to the site/any unauthorized changes are made in the installation of the system. Improvement Permit is valid for 60 months from date of issuance.

Signed: James Bechtold

Improvement Permit by: C. Bly Kerr EHSI date 1/30/97

AUTHORIZATION TO CONSTRUCT ~~Existing System Inspection~~ by: C. Bly Kerr EHSI date 1/30/97

Installed by: FJ ERVIN

Certificate of Completion by: date

Operation Permit by: date

HEALTH DEPT. COPY: WHITE INSPECTION COPY (FINAL): GREEN