4625-28-1574

IREDELL COUNTY HEALTH DEPARTMENT Const. Auth

STATESVILLE 704-878-5305 MOORESVILLE 704-664-5281

IMPROVEMENT PERMIT / ~~CERTIFICATE OF COMPLETION~~ / OPERATION PERMIT / EXISTING SYSTEM INSPECTION

PROPERTY DESCRIPTION NO. ~~[redacted]~~ 24527 DATE Sept. 9, 96 TAX MAP NO. part of 2CA3 Watershed: ☑ Yes ☐ No

OWNER OR CONTRACTOR Crescent Resources Dev. / Bill Whitley PHONE: Business _____ Home _____

ADDRESS PO Box 10037, Charlotte

LOCATION Brawley Sch. Rd. TR Boathouse TR Hunters Pt. at end

SUBDIVISION The Harbour BLOCK / SECTION 5 LOT 46 LOT AREA > 22,000 ft² SITE CLASS. PS per 1996 DESIGN FLOW 480gpd L.T.A.R. .3

Septic Tank: 1000 Gallons; STB 312 Date 11/4/03

Pump Tank: 1000 Gallons; PT 27 Date 8/25/03

Pump Make: Equal 05 Model WEO-712HV Serial No. _____

Nitrification Field: No Fields 1 Square Feet 1200 Linear Feet 400

No Lines 3 Trench Width 36" Max Trench Bottom Depth ~ 30" Gravel Depth NA

☑ New System ☐ Repair System Type: I, II, III, IV, V, VI

System Description: pumped-pr-chambered

Repair System Description: LP Panel Blocks

Maintenance Agreement Required: ☐ Yes ☑ No

☑ House/Mod. Home No. Bedrooms 4

☐ Mobile Home No. Bathrooms 4

☐ Business No. Employees _____

☐ Other _____


☐ Slab ☐ Crawl Space ☑ Basement w/plumbing ☐ Basement wo/plumbing

Water Supply: ☐ Individual ☐ Community ☑ Public


Comments: Reviewed building plans 4/16/03, essentially in compliance with J.P.

Comments:

INITIAL SITE SKETCH

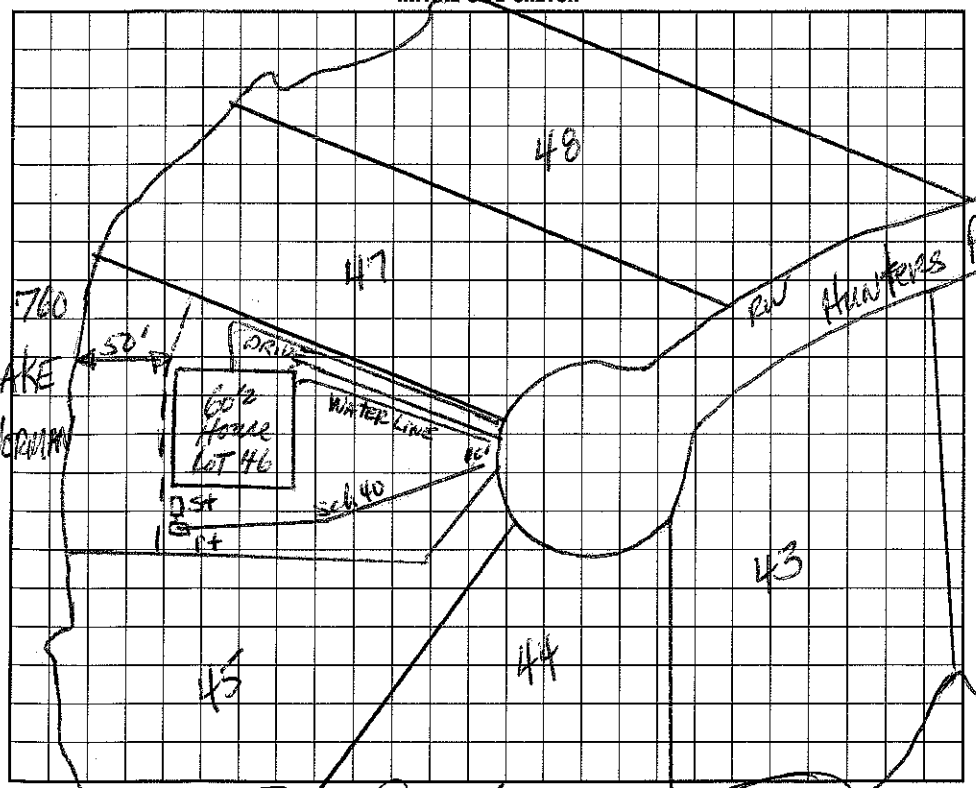

AS BUILT SKETCH

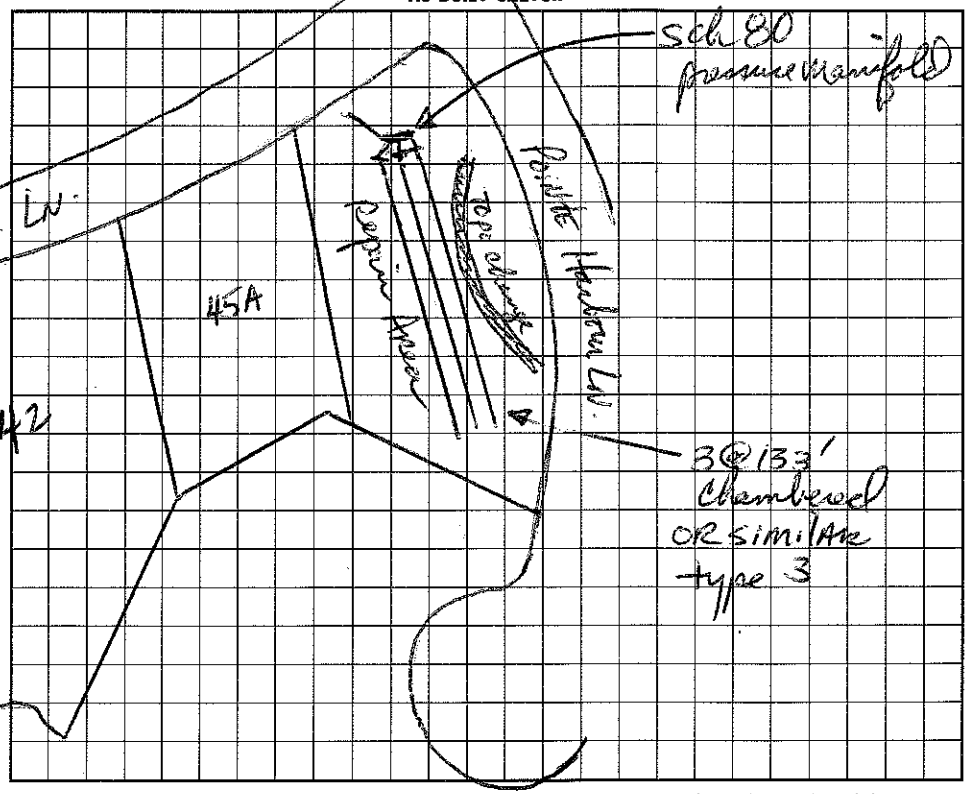

I understand that this permit can be suspended or revoked if any false information is supplied toward securing the permit/any unauthorized changes are made to the site/any unauthorized changes are made in the installation of the system.

Signed: _____ Agent

Improvement Permit by: _____ RS date 9-9-96

~~Existing System Inspection by:~~ Construction Authorization _____ RS date 4/16/03

Installed by: Curt Dunning

Certificate of Completion by: Wesley Sparks RS. date 4/2/04

Operation Permit by: _____ date _____

HEALTH DEPT. COPY: WHITE INSPECTION COPY (FINAL): GREEN OWNER COPY (FINAL): YELLOW INSPECTION COPY (INITIAL): PINK OWNER COPY (INITIAL): GOLD