3,700

IREDELL COUNTY HEALTH DEPARTMENT

Const. Auth. STATESVILLE 704-878-5305 MOORESVILLE 704-664-5281

IMPROVEMENT PERMIT / ~~CERTIFICATE OF COMPLETION~~ / OPERATION PERMIT / EXISTING SYSTEM INSPECTION

PROPERTY DESCRIPTION NO. 24387 DATE Sept. 9, '96 TAX MAP NO. part of 2CA3 46258 4180 Watershed: ☐ Yes ☐ No

OWNER OR CONTRACTOR Crescent Resources Steve Matthews/Kelly PHONE: Business _____ Home _____

ADDRESS PO Box 1023 Charlotte

LOCATION Blaylock Sch Rd. TR Bay Harbour TR Hunters Pt. Ln. TL Pointe Harbour on Right

SUBDIVISION The Harbour BLOCK / SECTION 5 LOT 39 LOT AREA ≥ 20,000 ft² SITE CLASS. PSpn.153 DESIGN FLOW 460gpd L.T.A.R. ~.3

Septic Tank: 1000 Gallons; STB 794 Date 11/4/96

Pump Tank: 1000 Gallons; PT 27 Date 11/4/96

Pump Make: Goulds Model WE1013H Serial No. 5A96536-7

Nitrification Field: No Fields 1 Square Feet 1200 Linear Feet 400

No Lines 4-5 Trench Width 36" Max Trench Bottom Depth ~30" Gravel Depth NA

☑ New System ☐ Repair System Type: I, II, III, IV, V, VI

System Description: pumped-pm-chambered

Repair System Description: 1 Solme

Maintenance Agreement Required: ☐ Yes ☑ No

☐ House/Mod. Home No. Bedrooms 4

☐ Mobile Home No. Bathrooms 4

☐ Business No. Employees ____

☐ Other _____


☐ Slab ☐ Crawl Space ☑ Basement w/plumbing ☐ Basement wo/plumbing

Water Supply:
☐ Individual
☐ Community
~~☐ Public~~


Comments:

Comments: 3 5 153

INITIAL SITE SKETCH

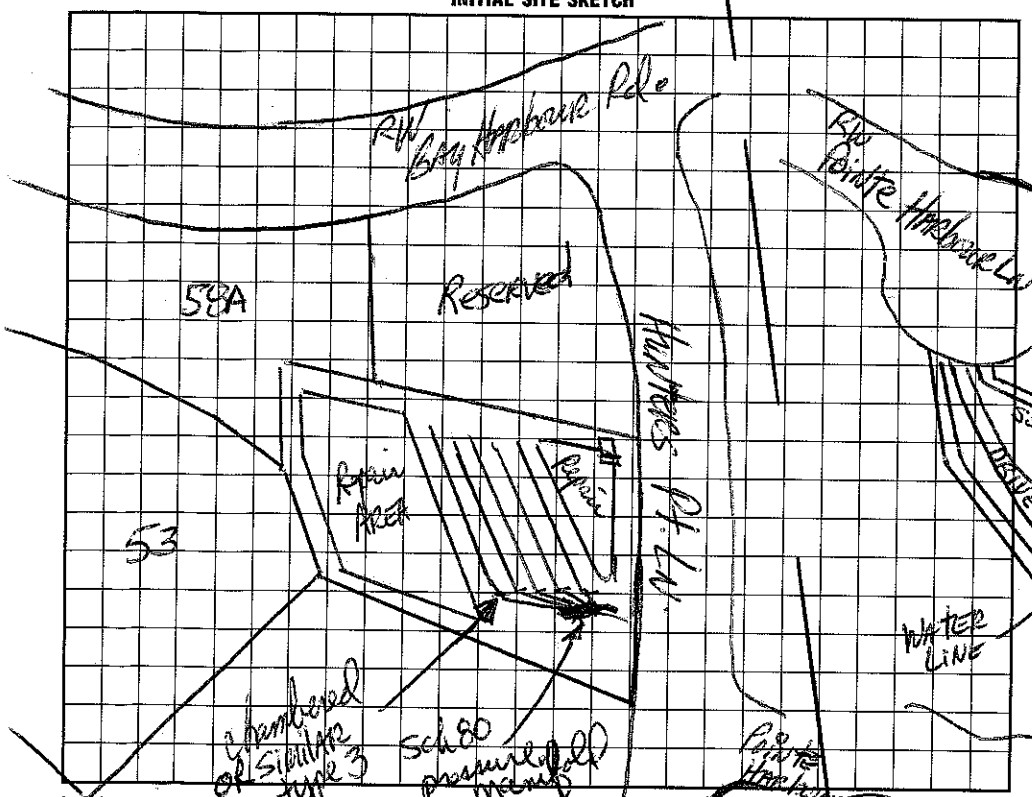

AS BUILT SKETCH

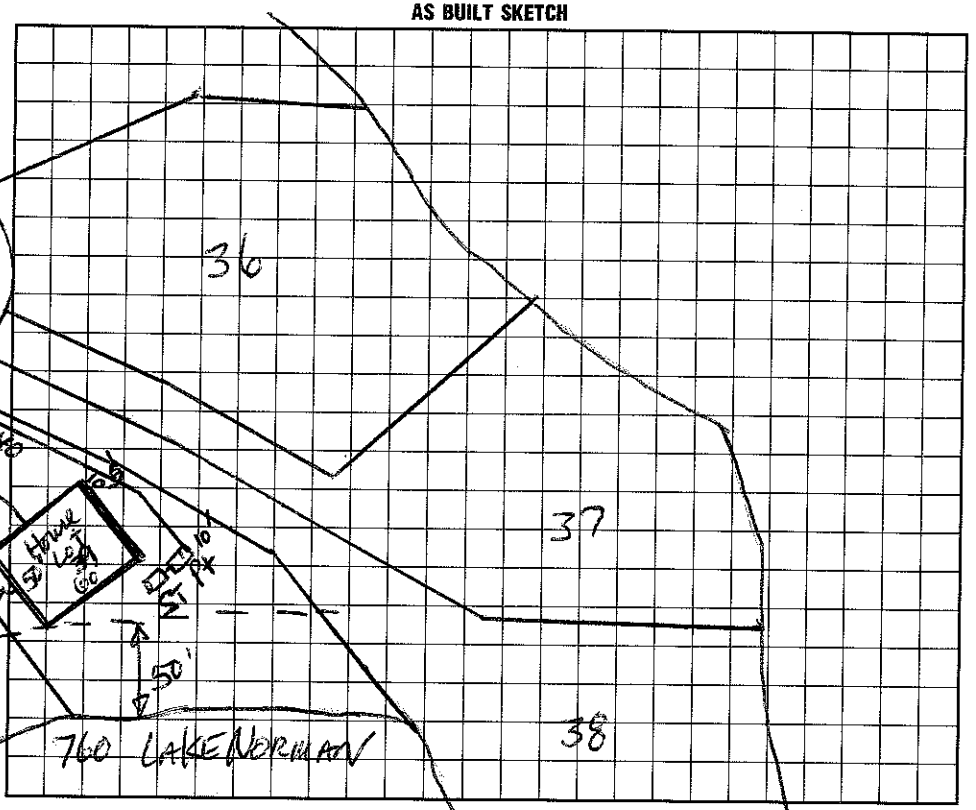

I understand that this permit can be suspended or revoked if any false information is supplied toward securing the permit/any unauthorized changes are made to the site/any unauthorized changes are made in the installation of the system.

Signed: _____ Agent

Improvement Permit by: _____ date 9-9-96

~~Existing System Inspection by:~~ Construction Authorization _____ date 3-2-98

Installed by: Leatherman Septic Tank

Certificate of Completion by: _____ date _____

Operation Permit by: Wesley Sparks R.S. date 3/29/99

HEALTH DEPT. COPY: WHITE INSPECTION COPY (FINAL): GREEN OWNER COPY (FINAL): YELLOW INSPECTION COPY (INITIAL): PINK OWNER COPY (INITIAL): GOLD