IREDELL COUNTY HEALTH DEPARTMENT

STATESVILLE 704-878-5305 MOORESVILLE 704-664-5281

As Built

IMPROVEMENT PERMIT / AUTHORIZATION TO CONSTRUCT / OPERATION PERMIT / EXISTING SYSTEM INSPECTION

PERMIT# 1160528 PIN# 4625285294 DATE 8/25/04

OWNER OR CONTRACTOR John & Diana Diederich / HH2 PHONE: Business _____ Home _____

ADDRESS _____

LOCATION _____

SUBDIVISION The Harbour BLOCK / SECTION 5 LOT 40 LOT AREA .75 Acre SITE CLASS. PS DESIGN FLOW 480gpd L.T.A.R. .3

Septic Tank: 1500 Gallons; STB 338 Date 7-2-04
Pump Tank: 1000 Gallons; PT 27 Date 6-26-04
Pump Make: Goulds Model WE0712HU Serial No. J026347
Nitrification Field: No Fields ___ Square Feet 867 Linear Feet 289
No Lines 5 Trench Width 36" Max Trench Bottom Depth ~30" Gravel Depth N/A

X New System ☐ Repair System Type: I, II, III, IV, V, VI
System Description: Pump-Lp-Panel Block
Repair System Description: Same
Maintenance Agreement Required: X Yes ☐ No


X House/Mod. Home No. Bedrooms 4
☐ Mobile Home No. Bathrooms 6
☐ Business No. Employees ___
☐ Other _____
☐ Slab ☐ Crawl Space ☐ Basement w/plumbing ☐ Basement wo/plumbing

Water Supply:
☐ Individual
X Public
☐ Community


Comments:/Conditions:

Comments:/Conditions:

INITIAL SITE SKETCH Scale 1:40

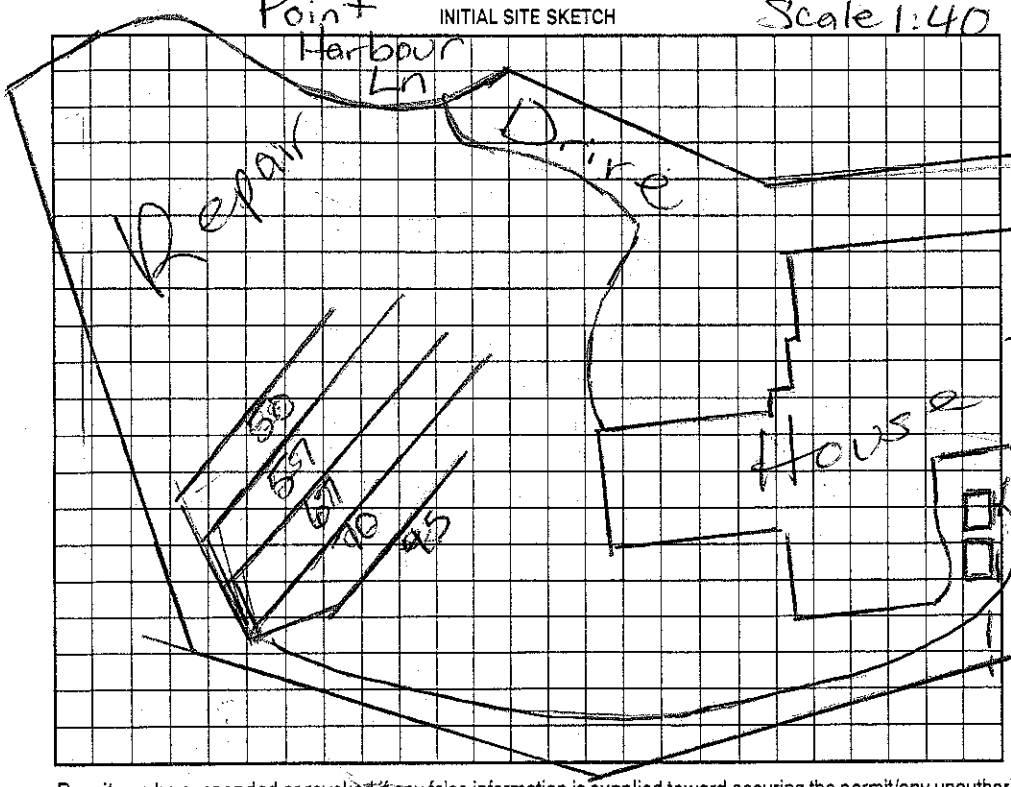

AS BUILT SKETCH

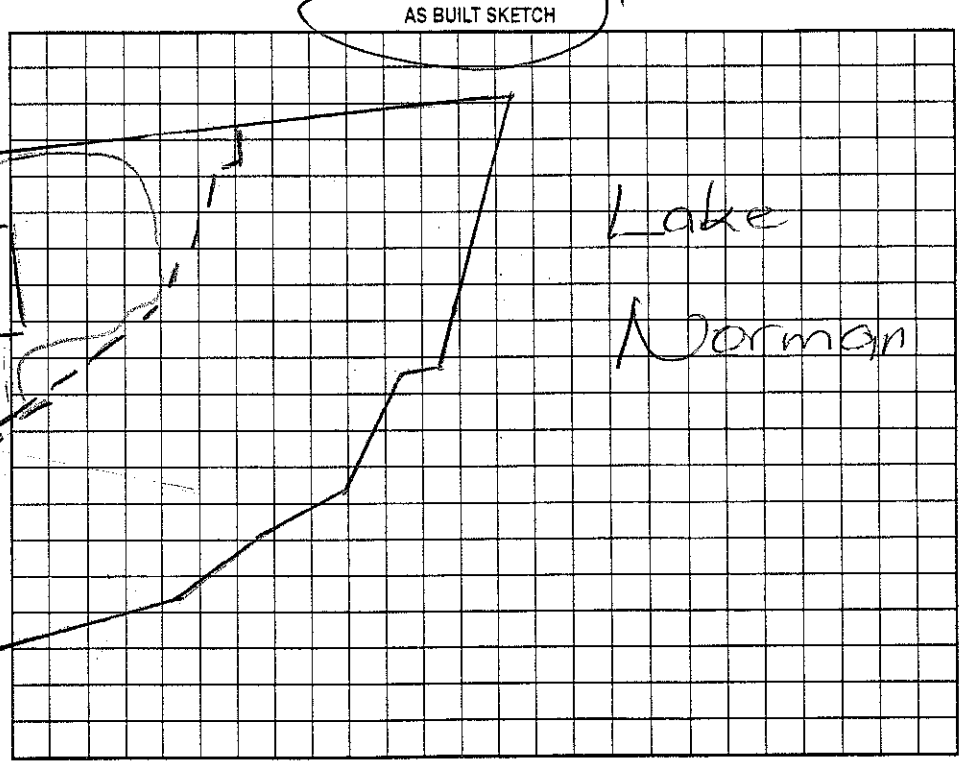

Permit can be suspended or revoked if any false information is supplied toward securing the permit/any unauthorized changes are made to the site/any unauthorized changes are made in the installation of the system. Improvement Permit with plat valid without expiration. Improvement Permit with site plan valid for sixty months. Authorization to Construct is valid for a period equal to that of Improvement Permit – not to exceed sixty months.

Signed: _____ date _____

Improvement Permit by: _____ date _____

Authorization to Construct by: _____ date _____

Installed by: Bob Mayhew

Operation Permit by: Maria HH2 Dotson date 8/27/04

Existing System Inspection by: _____ date _____

HEALTH DEPT. COPY: WHITE OWNER COPY (FINAL): YELLOW OWNER COPY (INITIAL): PINK