1:00

IREDELL COUNTY HEALTH DEPARTMENT

STATESVILLE 704-878-5305 MOORESVILLE 704-664-5281

IMPROVEMENT PERMIT / AUTHORIZATION TO CONSTRUCT / OPERATION PERMIT / EXISTING SYSTEM INSPECTION

PERMIT# 134616 PIN# 4625 28 5357 DATE 4/7/06

OWNER OR APPLICANT Whitley Const. LLC PHONE: Business 704-658-9251 Home

ADDRESS 132 Cedar Bluff Ln. Mooresville, NC 28117

LOCATION 1100, TR Bay Harbor TR Hunters Point on (L) past Point Harbour Ln.

SUBDIVISION Harbour BLOCK / SECTION 5 LOT 42 LOT AREA .59 AC SITE CLASS. PS DESIGN FLOW 480 L.T.A.R. .3

Septic Tank: 1500 Gallons; STB 444 Date 6/16/07
Pump Tank: 1500 Gallons; PT 477 Date 6/27/07
Pump Make: Goulds Model WEO-512HH Serial No. F0789217
Nitrification Field: No Fields 1 Square Feet 540 Linear Feet 270
No Lines 3 Aevs Trench Width 2' Max Trench Bottom Depth 30" Gravel Depth No ☐ Gravity ☐ Pressure

☒ New System ☐ Repair ☐ Expansion System Type: I II III (IV) V VI
System Description: LP - 16" PPBPS
Repair System Description: SAME TYPE
Maintenance Agreement Required: ☒ Yes ☐ No

☒ House/Mod. Home No. Bedrooms 4
☐ Mobile Home No. Persons
☐ Business No. Employees
☐ Other 1/2

Water Supply: ☐ Individual ☐ Public ☒ Community


☐ Slab ☐ Crawl Space ☒ Basement w/plumbing ☐ Basement wo/plumbing

Comments:/Conditions: Lines on contour, Lowest must be 25' or greater from Basement Wall.

Comments:/Conditions: 3' PH - Pressure Set - Tanks - Tank location moved to right side - 3 lines 90'x3' installed fed by CVB on top right of drainfield area

(1" = 50')

INITIAL SITE SKETCH

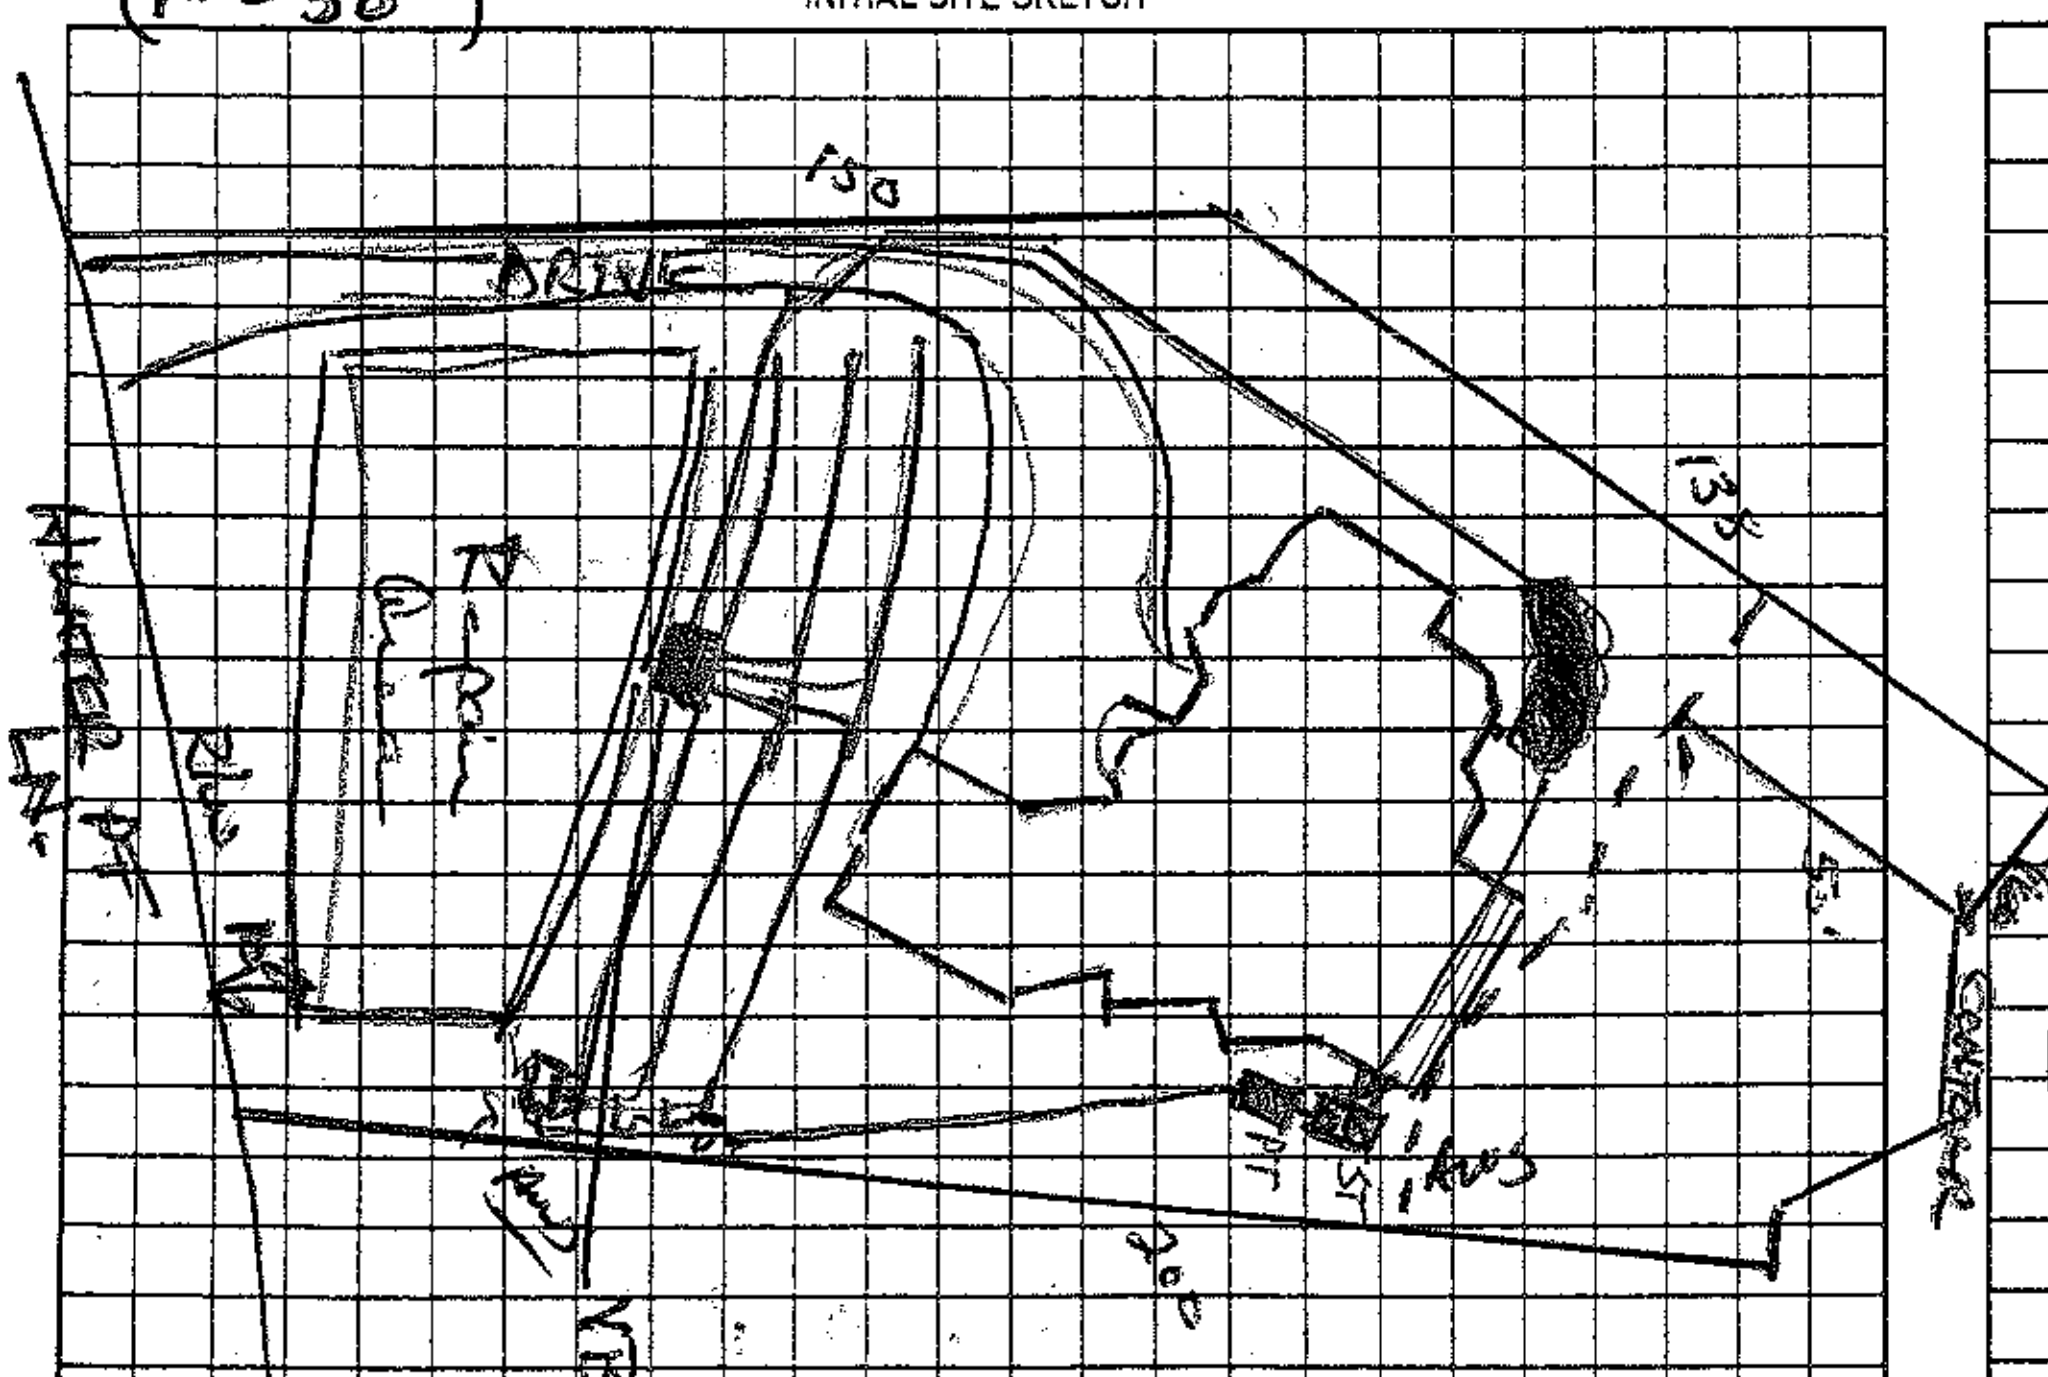

AS BUILT SKETCH

Permit can be suspended or revoked if any false information is supplied toward securing the permit/any unauthorized changes are made to the site/any unauthorized changes are made in the installation of the system. Improvement Permit with plat valid without expiration ☐ Improvement Permit with site plan valid for sixty months ☐ Authorization to Construct is valid for a period equal to that of Improvement Permit – not to exceed sixty months.

Signed: X John K Whitley date

Improvement Permit by: Wesley Sparks R.S. date 4/7/06

Authorization to Construct by: Wesley Sparks R.S. date 4/7/06

Installed by: Hallman Const

Operation Permit by: Wesley Sparks R.S. 9/13/07

Existing System Inspection by: date

HEALTH DEPT. COPY: WHITE OWNER COPY (FINAL): YELLOW OWNER COPY (INITIAL): PINK