IREDELL COUNTY HEALTH DEPARTMENT

STATESVILLE 704-878-5305 MOORESVILLE 704-664-5281

IMPROVEMENT PERMIT / AUTHORIZATION TO CONSTRUCT / OPERATION PERMIT / EXISTING SYSTEM INSPECT

PERMIT# 25766 PIN# 2C-A-3 pt of 4625 28 6600 DATE 3/11/99

OWNER OR CONTRACTOR CRESCENT RESOURCES (Jim Roche) PHONE: Business Home

ADDRESS PO BOX 1003 CHARLOTTE

LOCATION BRAWLEY SCHOOL - JR BAY HARBOUR - TR HUNTERS PT LN ON RT

SUBDIVISION HARBOUR BLOCK / SECTION I LOT 49 LOT AREA SITE CLASS. PS DESIGN FLOW 450GPD L.T.A.R. .30 GPD/FT2

Septic Tank: 1000 Gallons; STB 794 Date 3/26/99

Pump Tank: 1000 Gallons; PT 27 Date 8/23/99

Pump Make: GOULDS Model WE0 712H Serial No. J99138355

Nitrification Field: No Fields 1 Square Feet 1260 Linear Feet 420

No Lines 6@70' Trench Width 36" Max Trench Bottom Depth 36" Gravel Depth N/A

☑ New System ☐ Repair System Type: I, II, III, IV, V, VI

System Description: PUMP CHAMBERS OR HDS

Repair System Description: SAME

Maintenance Agreement Required: ☐ Yes ☑ No

☑ House/Mod. Home No. Bedrooms 4

☐ Mobile Home No. Bathrooms 4

☐ Business No. Employees

☐ Other


☐ Slab ☑ Crawl Space ☑ Basement w/plumbing ☐ Basement wo/plumbing

Water Supply: ☐ Individual ☐ Public ☑ Community


Comments/Conditions:

Comments/Conditions:

INITIAL SITE SKETCH 1"=40'

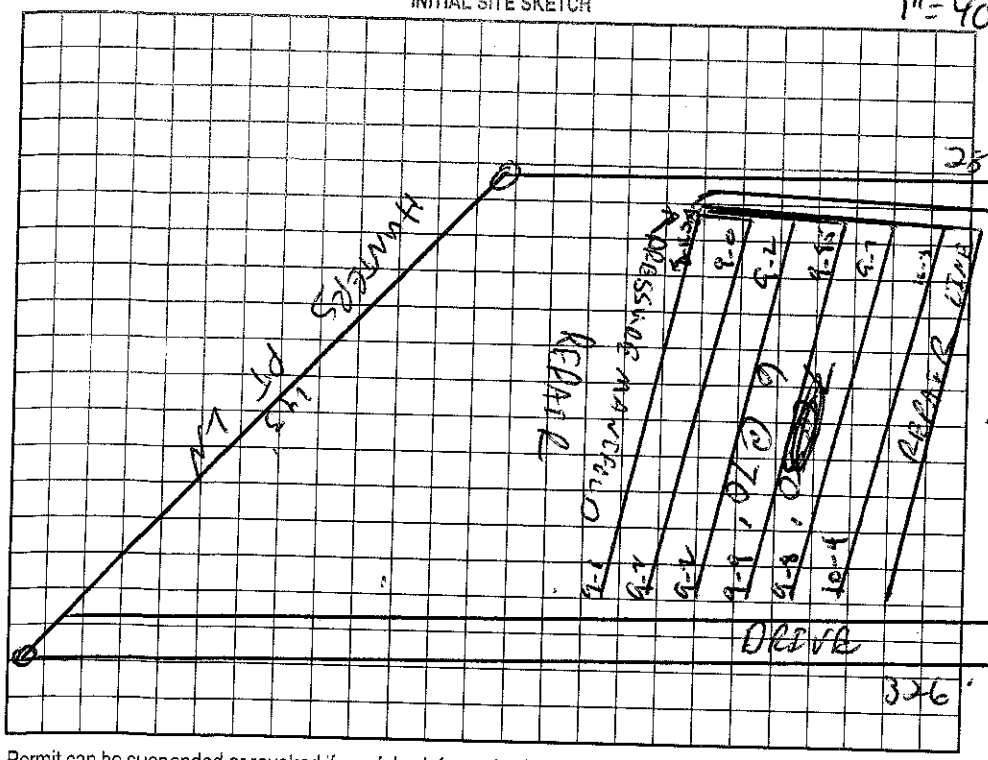

AS BUILT SKETCH

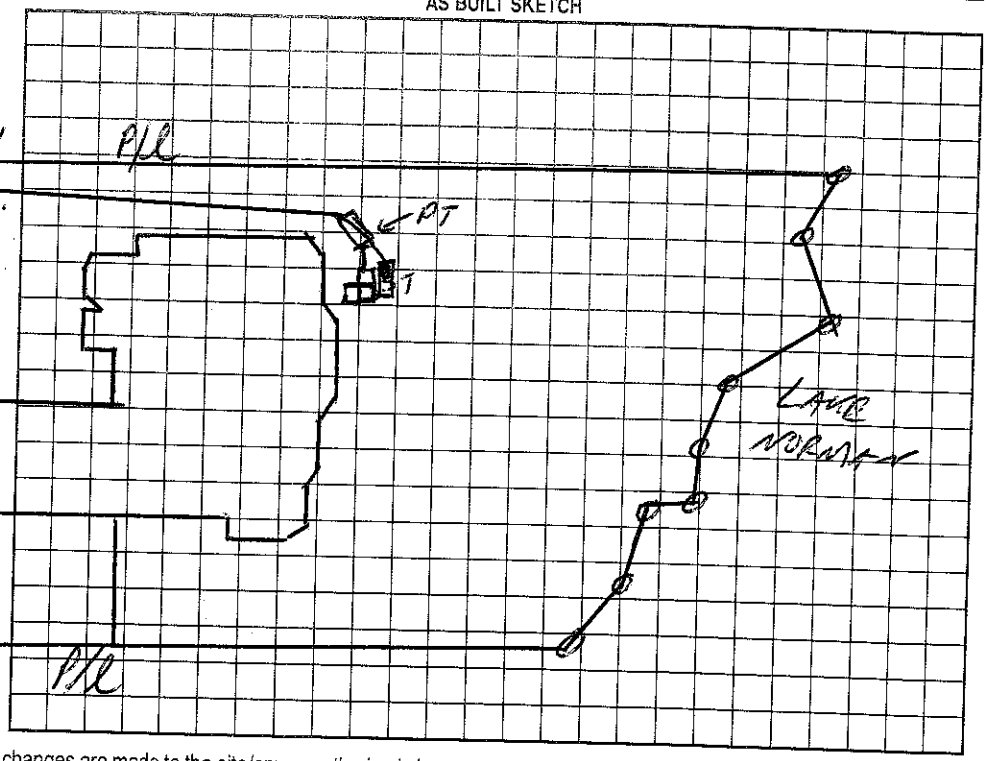

Permit can be suspended or revoked if any false information is supplied toward securing the permit/any unauthorized changes are made to the site/any unauthorized changes are made in the installation of the system. Improvement Permit with plat valid without expiration. Improvement Permit with site plan valid for sixty months. Authorization to Construct is valid for a period equal to that of Improvement Permit – not to exceed sixty months.

Signed: Thom O. Mauk date 3/12/99

Improvement Permit by: C. [signature] RS date 3/11/99

Authorization to Construct by: C. [signature] RS date 3/11/99

Installed by: FJ Ervin

Operation Permit by: Wesley Sparks RS. date 12/20/99

Existing System Inspection by: date

HEALTH DEPT. COPY: WHITE OWNER COPY (FINAL): YELLOW OWNER COPY (INITIAL): PINK