IREDELL COUNTY HEALTH DEPARTMENT Const. Auth. STATESVILLE 704-878-5305 MOORESVILLE 704-664-5281

IMPROVEMENT PERMIT / ~~CERTIFICATE OF COMPLETION~~ / OPERATION PERMIT / EXISTING SYSTEM INSPECTION

PROPERTY DESCRIPTION NO. 24390 DATE Sept 6 '96 TAX MAP NO. part of 2043 4625-28-6979 Watershed: ☑ Yes ☐ No

OWNER OR CONTRACTOR Crescent Resources Inc // Clay Fisher PHONE: Business _____ Home _____

ADDRESS PO Box 1003, Charlotte

LOCATION Brawley Sch Rd TR Bay Harbour Rd TR Windy Run Ln. at end

SUBDIVISION The Harbour BLOCK / SECTION 5 LOT 55 LOT AREA 41,570 +14,400 SITE CLASS. PSpec 1952 DESIGN FLOW 480 gpd L.T.A.R. n-3

Septic Tank: 1000 Gallons; STB 794 Date 12/6/99

Pump Tank: 1000 Gallons; PT 27 Date 12/28/99

Pump Make: GOULDS Model WE01012H Serial No. 9940951

Nitrification Field: No Fields 1 Square Feet 540 Linear Feet 270

No Lines 3@90' Trench Width 24" Max Trench Bottom Depth n 30" Gravel Depth NA

☑ New System ☐ Repair System Type: I, II, III, IV, V, VI

System Description: LP Panel Block

Repair System Description: LP Panel Block

Maintenance Agreement Required: ☑ Yes ☐ No

☑ House/Mod. Home No. Bedrooms 4

☐ Mobile Home No. Bathrooms 4

☐ Business No. Employees _____

☐ Other _____

☐ Slab ☐ Crawl Space ☑ Basement w/plumbing ☐ Basement wo/plumbing


Water Supply: ☐ Individual ☐ Community ☑ Public

Comments:


RW Bay Harbour Rd

Comments: 2-12-99 Reviewed house/site plan; appears in compliance w/ I.P. DBH

INITIAL SITE SKETCH

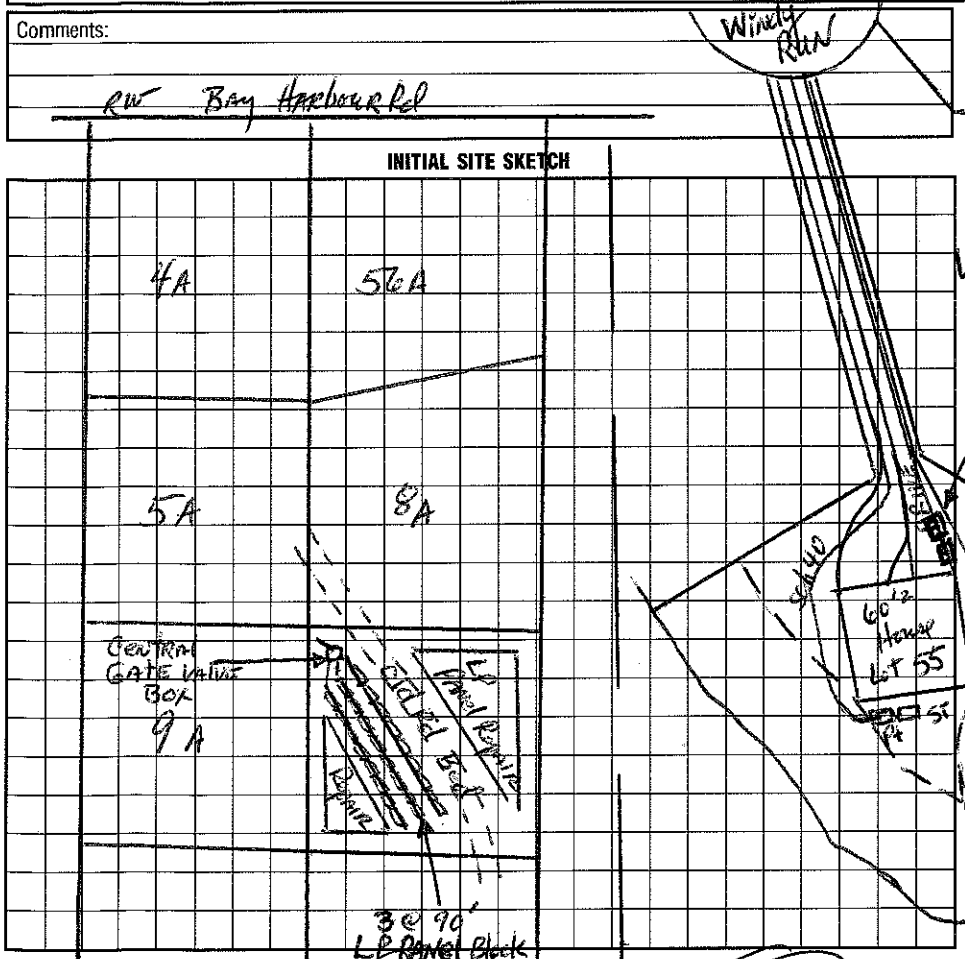

AS BUILT SKETCH

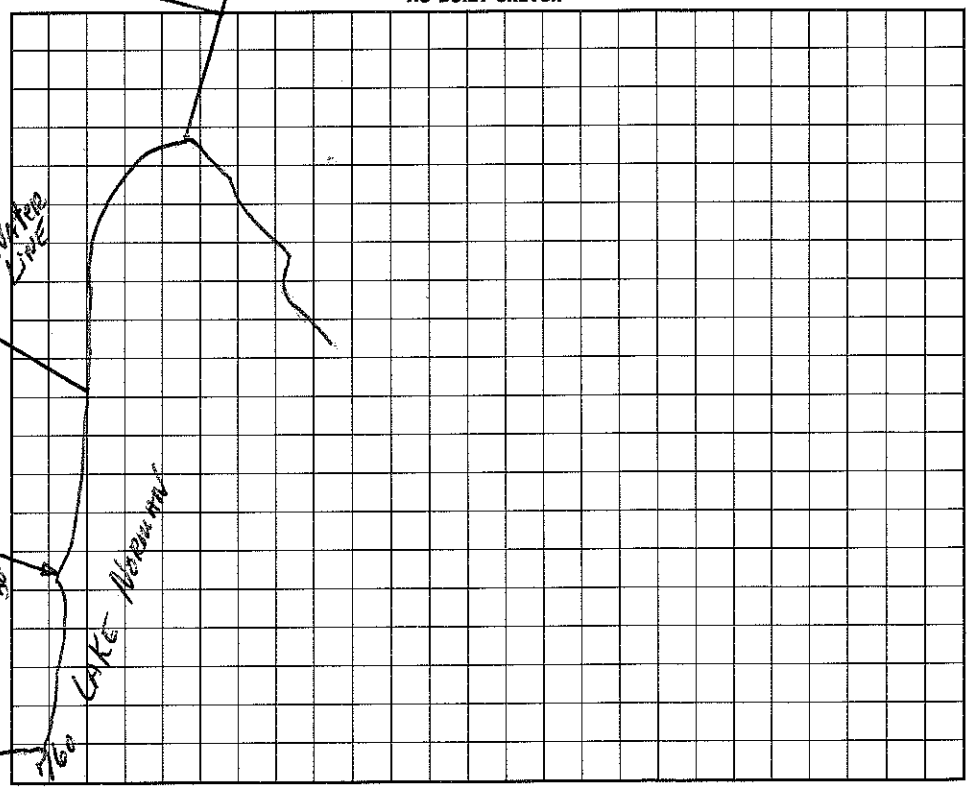

I understand that this permit can be suspended or revoked if any false information is supplied toward securing the permit/any unauthorized changes are made to the site/any unauthorized changes are made in the installation of the system.

Signed: _____

Improvement Permit by: _____ date 9-6-96

~~Construction~~ Existing System Inspection by: _____ date 2-12-99

Authorization

Installed by: Curt Dunnings

Certificate of Completion by: _____ RSI date 8/30/01

Operation Permit by: _____ date _____

HEALTH DEPT. COPY: WHITE INSPECTION COPY (FINAL): GREEN OWNER COPY (FINAL): YELLOW INSPECTION COPY (INITIAL): PINK OWNER COPY (INITIAL): GOLD