704 - 664 - 9579

IREDELL COUNTY HEALTH DEPARTMENT Const. Auth. STATESVILLE 704-878-5305 MOORESVILLE 704-664-5281

IMPROVEMENT PERMIT / ~~CERTIFICATE OF COMPLETION~~ / OPERATION PERMIT / EXISTING SYSTEM INSPECTION

PROPERTY DESCRIPTION NO. 24388 DATE Aug 29, '96 TAX MAP NO. part of 2CA3 4625-28-9738 Watershed: ☑ Yes ☐ No

OWNER OR CONTRACTOR Crescent Resources Inc. PHONE: Business _____ Home _____

ADDRESS PO Box 1003, Charlotte, NC

LOCATION Beverly Lake Rd TR Bay Harbour TR Windy Run Lane on left

SUBDIVISION The Harbour BLOCK / SECTION 5 LOT 53 LOT AREA 37,820 ft² SITE CLASS. Spec. 1936 DESIGN FLOW 480 gpd L.T.A.R. -.3

Septic Tank: 1000 Gallons; STB 312 Date 4-9-02
Pump Tank: 1000 Gallons; PT 27 Date 6-30-02
Pump Make: _____ Model _____ Serial No. _____
Nitrification Field: No Fields 1 Square Feet 540 Linear Feet 270
No Lines 6 Trench Width 24" Max Trench Bottom Depth ~30" Gravel Depth NA

☑ New System ☐ Repair System Type: I, II, III (IV) V, VI
System Description: LP Panel Block
Repair System Description: LP Panel Blocks
Maintenance Agreement Required: ☑ Yes ☐ No


☑ House/Mod. Home No. Bedrooms 4
☐ Mobile Home No. Bathrooms 4
☐ Business No. Employees _____
☐ Other _____
☐ Slab ☑ Crawl Space ☑ Basement w/plumbing ☐ Basement wo/plumbing

Water Supply:
☐ Individual
☐ Community
☑ Public


Comments: 11/28/01 - Reinspection, approved for 4 Bdrms Only. No room to expand system on this site. Ags

Comments: partial 5/32" hole drilled
Installed 4 Panel lines
Press. Elect. alarm Checked.

INITIAL SITE SKETCH 1" = 50'

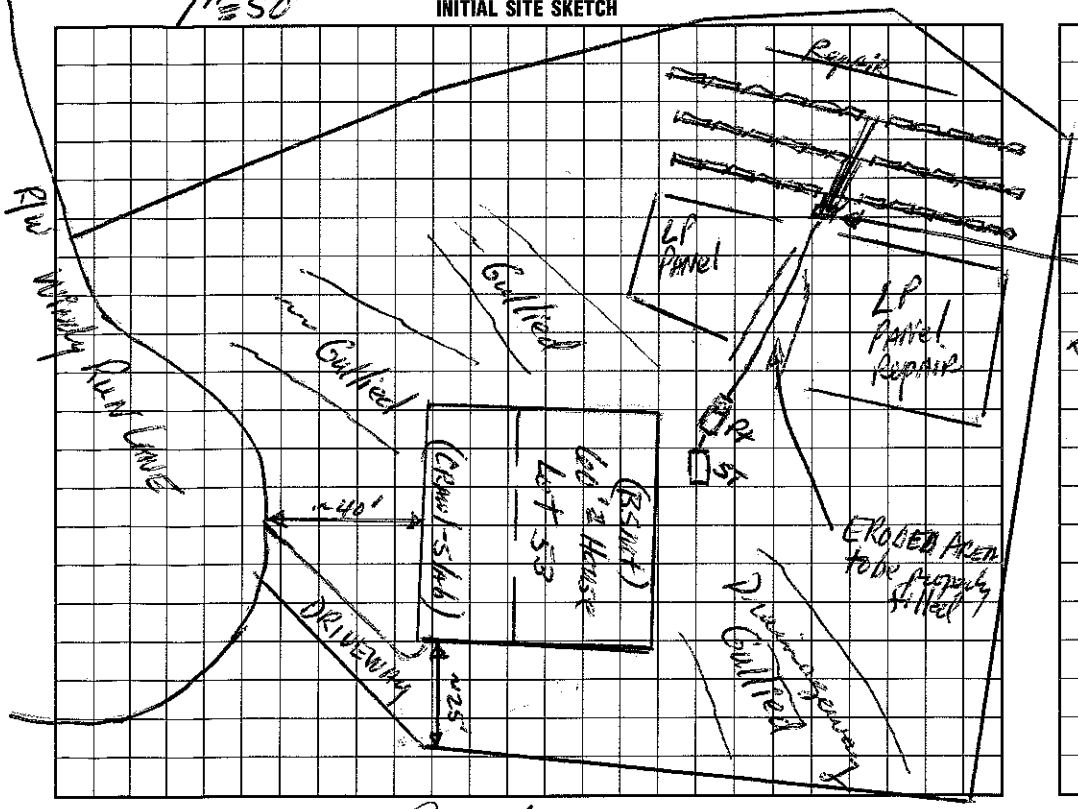

AS BUILT SKETCH

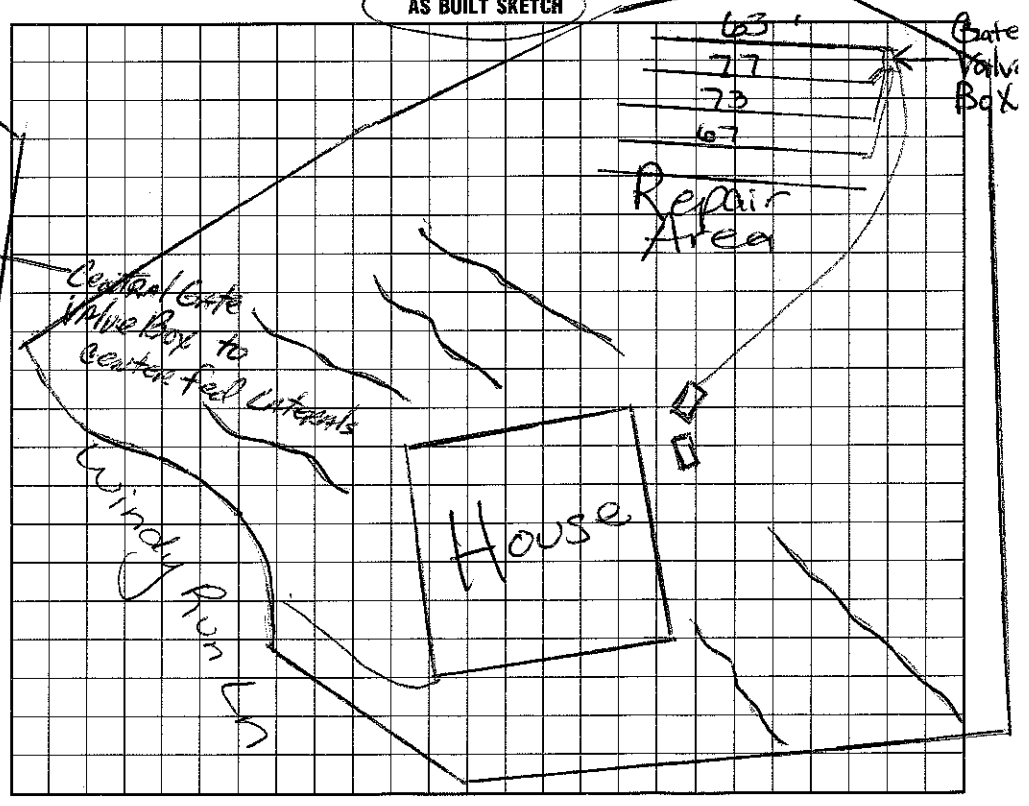

I understand that this permit can be suspended or revoked if any false information is supplied toward securing the permit/any unauthorized changes are made to the site/any unauthorized changes are made in the installation of the system.

Signed: Terry C. Stanley, LRS (Agent) Installed by: R & H Inc

Improvement Permit by: Wendell Hunter, RS date 8-29-96 Certificate of Completion by: _____ date _____

Existing System Inspection by: Wesley Sparks RS date 11/28/01 Operation Permit by: Maria H. Dotson RS date 8/27/02

Authorization

HEALTH DEPT. COPY: WHITE | INSPECTION COPY (FINAL): GREEN | OWNER COPY (FINAL): YELLOW | INSPECTION COPY (INITIAL): PINK | OWNER COPY (INITIAL): GOLD