IREDELL COUNTY HEALTH DEPARTMENT

STATESVILLE 704-878-5305 MOORESVILLE 704-664-5281

IMPROVEMENT PERMIT / AUTHORIZATION TO CONSTRUCT / OPERATION PERMIT / EXISTING SYSTEM INSPECTION

PERMIT# 05567 PIN# ~~4625944684~~ 4625-29-0217 DATE 4/23/98

OWNER OR CONTRACTOR @ TOM PENN PHONE: Business _____ Home 542-2023

ADDRESS _____

LOCATION BRAWLEY SCHOOL - TR B44 HARBOUR - TR SHEPYARD PT. - TL CEDAR BLUFF LN AT END

SUBDIVISION HARBOUR BLOCK / SECTION 6 LOT 38 LOT AREA 28411 ft² SITE CLASS. PS DESIGN FLOW 460 GPD L.T.A.R. .3 GPD/ft²

Septic Tank: 1000 Gallons; STB 794 Date 5/29/98
Pump Tank: 1000 Gallons; PT 27 Date 1/11/99
Pump Make: HYDROMATIC Model SHEP 50 Serial No. 5186-008-1
Nitrification Field: No Fields 1 Square Feet 533 Linear Feet 368
No Lines 4@67' Trench Width 36" Max Trench Bottom Depth 36" Gravel Depth N/A

☑ New System ☐ Repair System Type: I, II, III, IV, V, VI
System Description: PUMP PANEL
Repair System Description: SAME
Maintenance Agreement Required: ☑ Yes ☐ No

☑ House/Mod. Home No. Bedrooms 4
☐ Mobile Home No. Bathrooms 4
☐ Business No. Employees ____
☐ Other _____


☐ Slab ☐ Crawl Space ☑ Basement w/plumbing ☐ Basement wo/plumbing

Water Supply: ☐ Individual ☐ Public ☑ Community


Comments:/Conditions:

Comments:/Conditions:

INITIAL SITE SKETCH 1"=50'

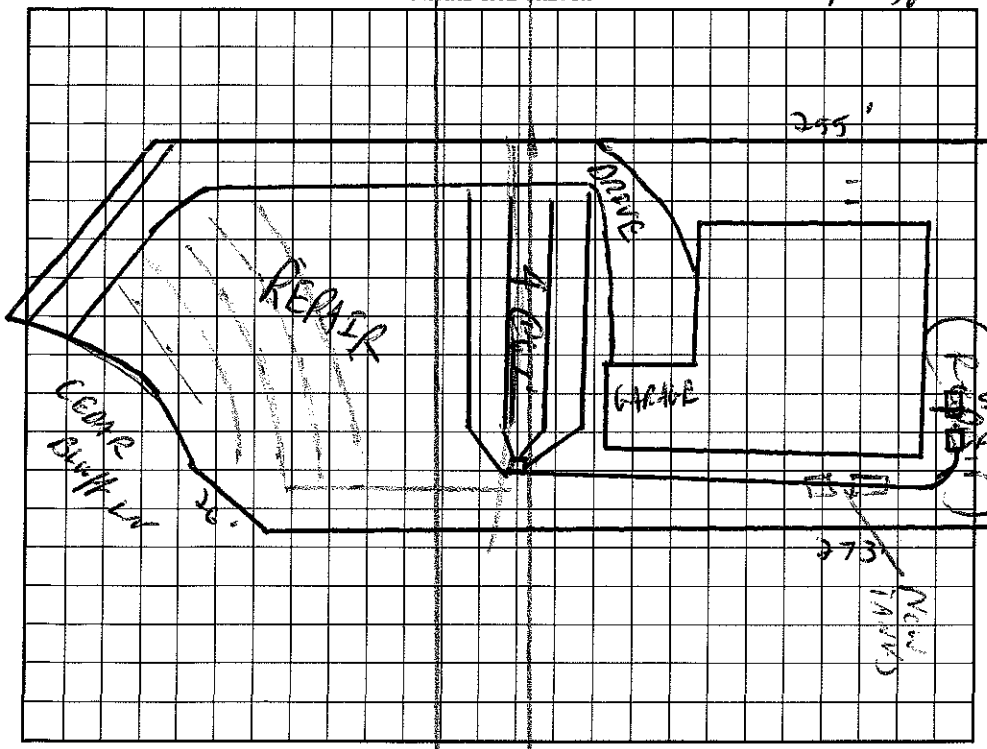

AS BUILT SKETCH

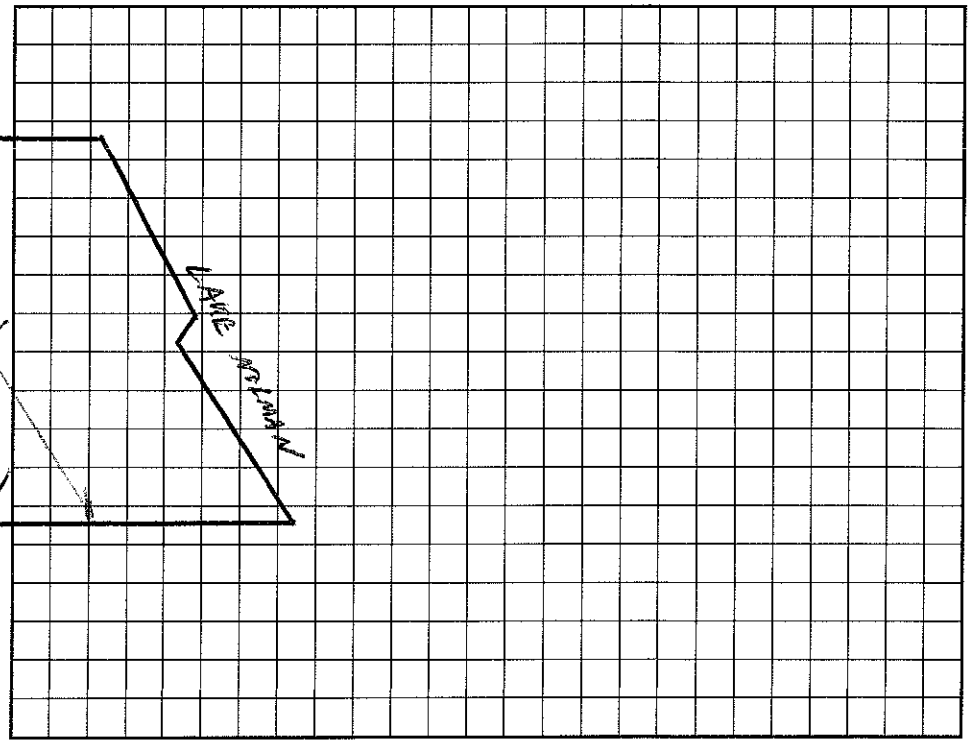

I understand that this permit can be suspended or revoked if any false information is supplied toward securing the permit/any unauthorized changes are made to the site/any unauthorized changes are made in the installation of the system. Improvement Permit with plat valid without expiration. Improvement Permit with site plan valid for sixty months. Authorization to Construct is valid for a period equal to that of Improvement Permit – not to exceed sixty months.

Signed: Tom Penn date 5-11-98

Improvement Permit by: C. [illegible] RS date 4/23/98

Authorization to Construct by: C. [illegible] RS date 4/23/98

Installed by: BOB MAYHEW

Operation Permit by: C. [illegible] date 4/9/99

Existing System Inspection by: _____ date _____

HEALTH DEPT. COPY: WHITE INSPECTION COPY (FINAL): GREEN OWNER COPY (FINAL): YELLOW INSPECTION COPY (INITIAL): PINK OWNER COPY (INITIAL): GOLD