IREDELL COUNTY HEALTH DEPARTMENT

Cert. Auth. STATESVILLE 704-878-5305 MOORESVILLE 704-664-5281

IMPROVEMENT PERMIT / ~~CERTIFICATE OF COMPLETION~~ / OPERATION PERMIT / EXISTING SYSTEM INSPECTION

PROPERTY DESCRIPTION NO. 065668 DATE MAY 30, '97 TAX MAP NO. 4625941684 (pt.) 4625 29 1348 Watershed: ☑ Yes ☐ No

OWNER OR CONTRACTOR Crescent Resources Inc. / Clint Kenley PHONE: Business _____ Home _____

ADDRESS PO Box 1003, Charlotte PO Cedar Bluff Ln. Mooresville, NC. 28117

LOCATION Brawley Sch Rd. TR Bay Harbour TR Shipyard Rd. TL Cedar Bluff Ln. on left near end

SUBDIVISION The Harbour BLOCK / SECTION 6 LOT ~~4039~~ LOT AREA 43245 ft² SITE CLASS. PS DESIGN FLOW 480gpd L.T.A.R. .3

Septic Tank: 1000 Gallons; STB 794 Date 1-25-99 ☑ New System ☐ Repair System Type: I, II, III, IV, V, VI ☑ House/Mod. Home No. Bedrooms 4

Pump Tank: 1000 Gallons; PT 23 Date 5-29-99 System Description: PM Conventional ☐ Mobile Home No. Bathrooms 4

Pump Make: Gowlos Model WEO 712H Serial No. C9943338 Repair System Description: Same ☐ Business No. Employees _____

Nitrification Field: No Fields 1 Square Feet 1620 Linear Feet 540 Maintenance Agreement Required: ☐ Yes ☑ No ☐ Other _____


No Lines ~~6 @ 90'~~ Trench Width 36" Max Trench Bottom Depth 36" Gravel Depth 12" ☐ Slab ☐ Crawl Space ☑ Basement w/plumbing ☐ Basement wo/plumbing

Water Supply: ☐ Individual ☑ Community ☐ Public


Comments: 3-18-98. House larger than shown on sketch but extends into area with complex topo. Proposed Driveway must be closer to Right PROP. LINE than shown on architects drawing to avoid change / modification to Septic System. Builder/owner indicates this not to be possible

Comments:

INITIAL SITE SKETCH

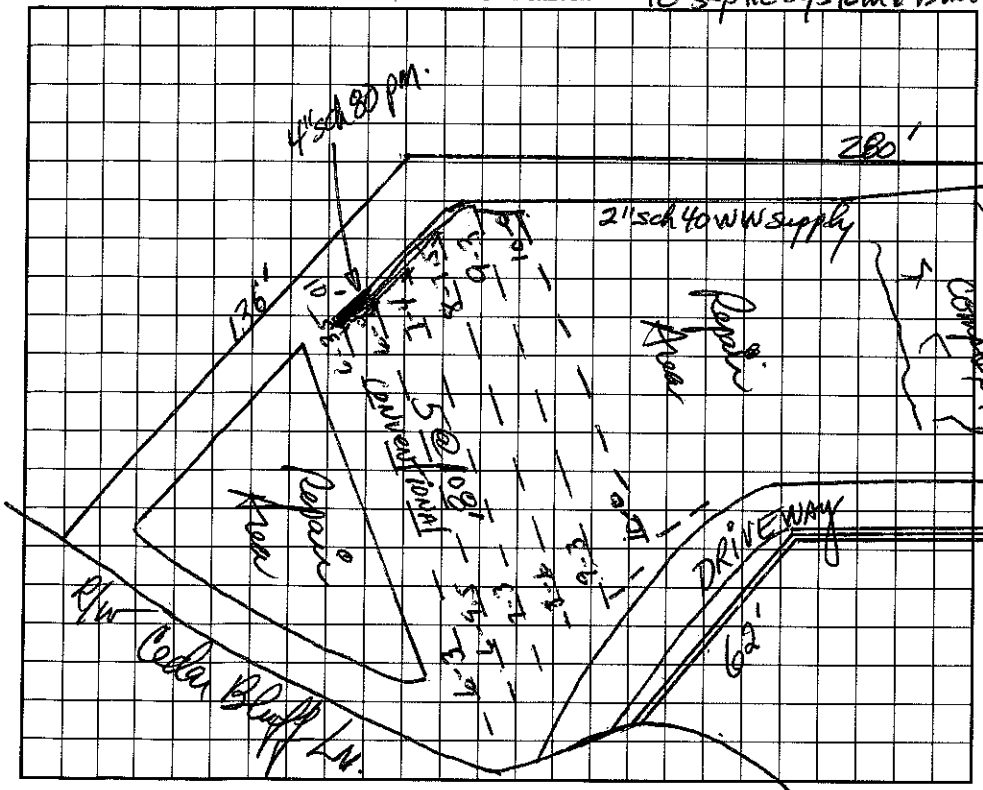

AS BUILT SKETCH

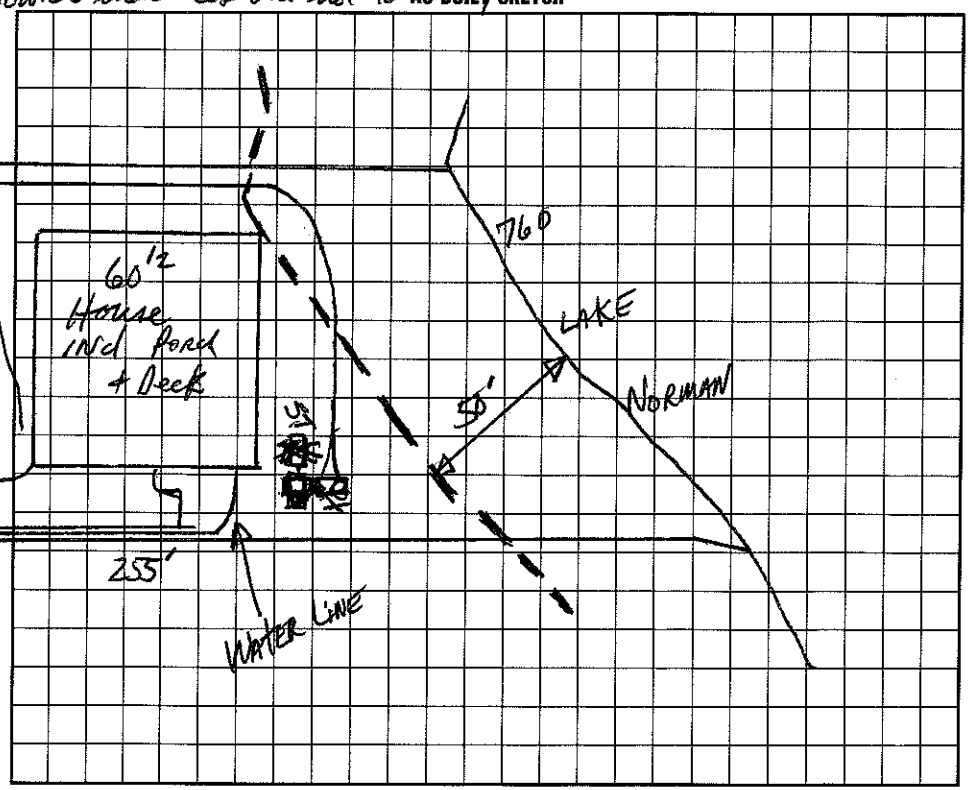

I understand that this permit can be ~~suspended~~ or revoked if any false information is supplied toward securing the permit/any unauthorized changes are made to the site/any unauthorized changes are made in the installation of the system. Improvement Permit is valid for 60 months from date of issuance.

Signed: _____

Improvement Permit by: DR Hinson, IRS date 5-30-97

~~Existing System~~ Construction Authorization by: DR Hinson, RS date 3-18-98

Installed by: F J Ervin

Certificate of Completion by: Wesley Sparks RS. date 7/17/02

Operation Permit by: Wesley Sparks RS. date 7/17/02

HEALTH DEPT. COPY: WHITE INSPECTION COPY (FINAL): GREEN OWNER COPY (FINAL): YELLOW INSPECTION COPY (INITIAL): PINK OWNER COPY (INITIAL): GOLD