IREDELL COUNTY HEALTH DEPARTMENT

Coast Auth. · STATESVILLE 704-878-5305 MOORESVILLE 704-664-5281

IMPROVEMENT PERMIT / ~~CERTIFICATE OF COMPLETION~~ / OPERATION PERMIT / EXISTING SYSTEM INSPECTION

PROPERTY DESCRIPTION NO. 065698 DATE July 3, 1997 TAX MAP NO. 4625941684 (pt.) 4625291997 Watershed: ☑ Yes ☐ No

OWNER OR CONTRACTOR Crescent Resources Dev. (DAVID EDISON) PHONE: Business _____ Home _____

ADDRESS 10 Box 1003 Charlotte

LOCATION Bowaters Mill Rd. TR Bay Harbour TR Shipyard Pointe TR Cedar Bluff on Right

SUBDIVISION The Harbour BLOCK / SECTION 6 LOT 29, 29A LOT AREA 38436 ft² SITE CLASS. PS DESIGN FLOW 480 gpd L.T.A.R. .103

Septic Tank: 1000 Gallons; STB 317 Date 9/15/99

Pump Tank: 1000 Gallons; PT 27 Date 10/25/99

Pump Make: ZOELLER Model E-185B Serial No. 9777

Nitrification Field: No Fields 1 Square Feet 1200 Linear Feet 480

No Lines 4 @ 100' Trench Width 36" Max Trench Bottom Depth 36"

☑ New System ☐ Repair System Type: I, II, III, IV, V, VI

System Description: pumped per Crawford

Repair System Description: 1 LP Panel Block

Maintenance Agreement Required: ☐ Yes ☑ No

Gravel Depth N/A

☑ House/Mod. Home ☐ Mobile Home ☐ Business ☐ Other

No. Bedrooms 4 No. Bathrooms 4 No. Employees ____


☐ Slab ☐ Crawl Space ☑ Basement w/plumbing ☐ Basement wo/plumbing

Water Supply: ☐ Individual ☑ Community ☐ Public


Comments:

Comments: 7" Tether

INITIAL SITE SKETCH 1" = 100'

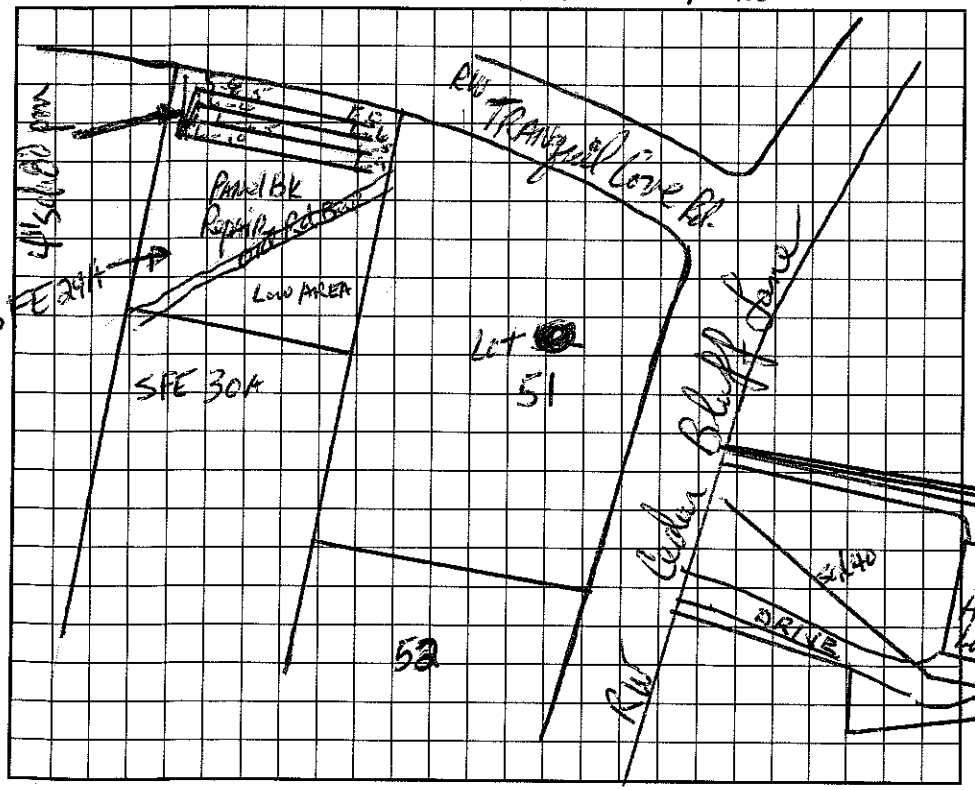

AS BUILT SKETCH

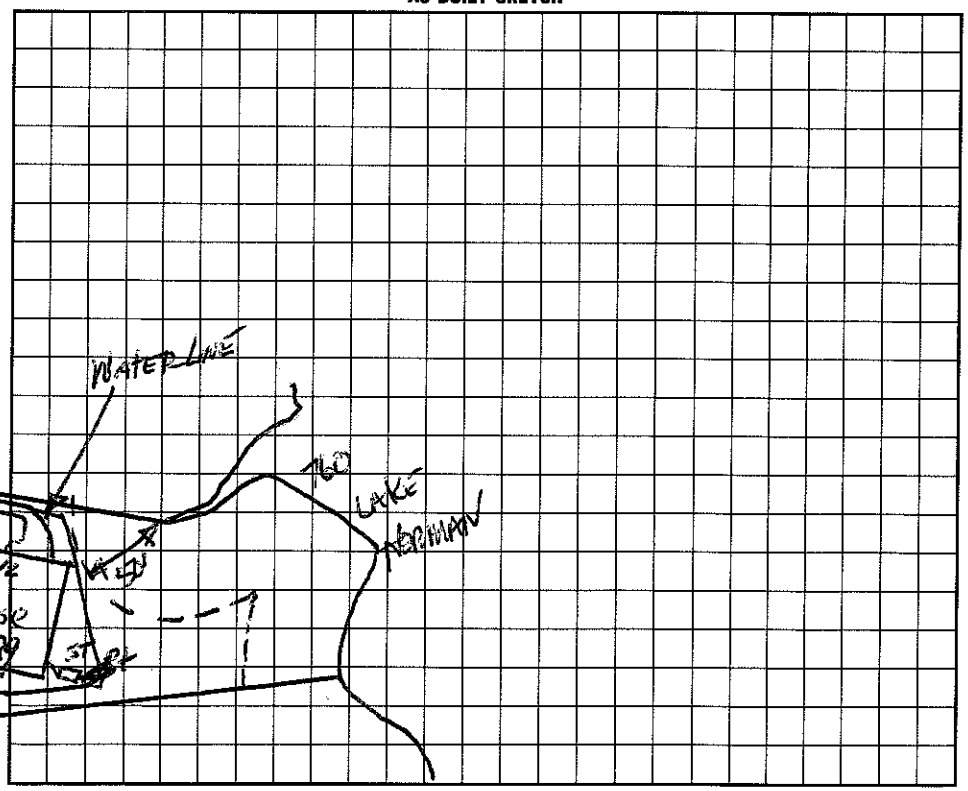

I understand that this permit ~~can be~~ suspended or revoked if any false information is supplied toward securing the permit/any unauthorized changes are made to the site/any unauthorized changes are made in the installation of the system. Improvement Permit is valid for 60 months from date of issuance.

Signed: X

Improvement Permit by: D.R. Hanson, RS date 7-3-97

~~Construction~~ Existing System Inspection by: Wesley Sparks RS. date 1/20/99

Authorization

Installed by: Charles Beatty

Certificate of Completion by: _____ date _____

Operation Permit by: Wesley Sparks RS. date 5/11/00

HEALTH DEPT. COPY: WHITE INSPECTION COPY (FINAL): GREEN OWNER COPY (FINAL): YELLOW INSPECTION COPY (INITIAL): PINK OWNER COPY (INITIAL): GOLD