IREDELL COUNTY HEALTH DEPARTMENT

STATESVILLE 704-878-5305 MOORESVILLE 704-664-5281

IMPROVEMENT PERMIT / CERTIFICATE OF COMPLETION / OPERATION PERMIT / EXISTING SYSTEM INSPECTION

PROPERTY DESCRIPTION NO. 065675 DATE 5/30/97 TAX MAP NO. 4625941684 4625 29 2450 Watershed: ☒ Yes ☐ No CWSIR CA

OWNER OR CONTRACTOR Crescent Resources PHONE: Business _____ Home _____

ADDRESS 400 S Tryon St

LOCATION Bay Harbour TL Shipyard TL Cedar Bluff on Left

SUBDIVISION Harbour BLOCK / SECTION VI LOT ~~X~~ 40 LOT AREA 37351 SITE CLASS. PS DESIGN FLOW 450 gpd L.T.A.R. .3

Septic Tank: 1000 Gallons; STB ~~1000~~ 1312 Date 5/25/99

Pump Tank: 1000 Gallons; PT ~~1000~~ 794 Date 6/29/99

Pump Make: Myers Model ME508 Serial No. _____

Nitrification Field: No Fields 1 Square Feet 1260' Linear Feet 420'

No Lines 6 @ 70' Trench Width 36" Max Trench Bottom Depth 36" Gravel Depth 1/4

☒ New System ☐ Repair System Type: I, II, ☒ III, IV, V, VI

System Description: Pump to Plastic Chamber

Repair System Description: Pump to Plastic Chamber

Maintenance Agreement Required: ☐ Yes ☒ No

☐ Slab ☐ Crawl Space ☒ Basement w/plumbing ☐ Basement wo/plumbing

☒ House/Mod. Home No. Bedrooms 4

☐ Mobile Home No. Bathrooms _____

☐ Business No. Employees _____


☐ Other _____

Water Supply:
☐ Individual
☒ Community
☐ Public


Comments: * Install inspection ports near end of each lateral, didn't install inspection ports.

Comments: partial
Drain lines inspected 8/16/99 MS
~~Pump tank to close to PL, needs to be moved~~ 8/16/99
Checked pressure head 8/17/99.

INITIAL SITE SKETCH Scale 1:50

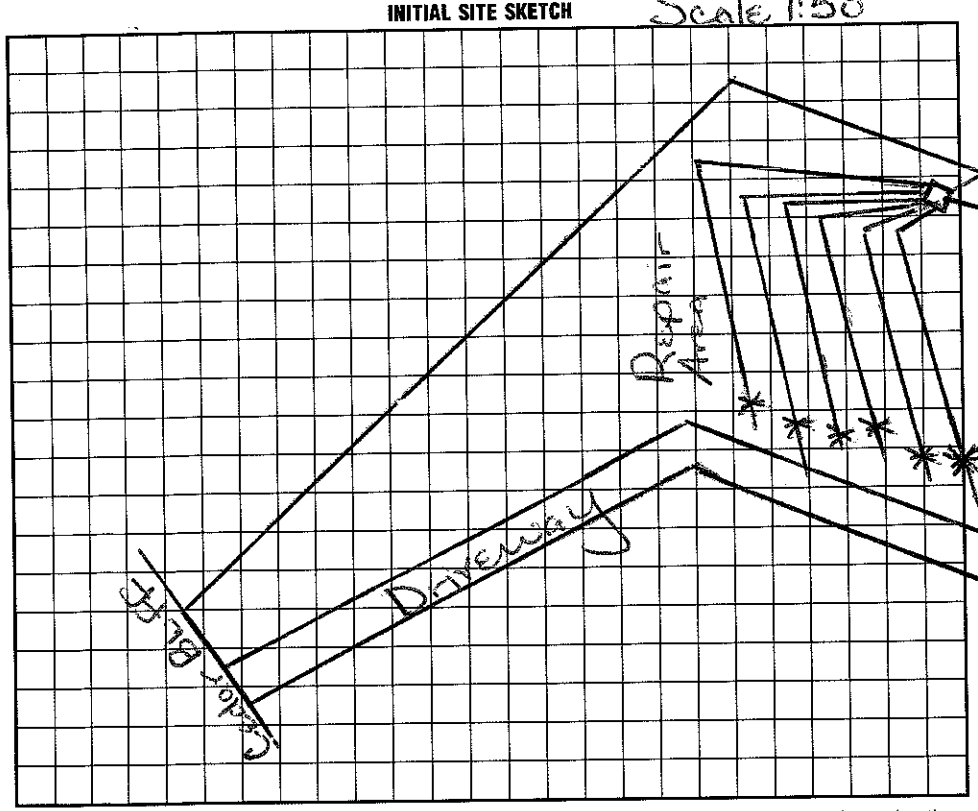

AS BUILT SKETCH

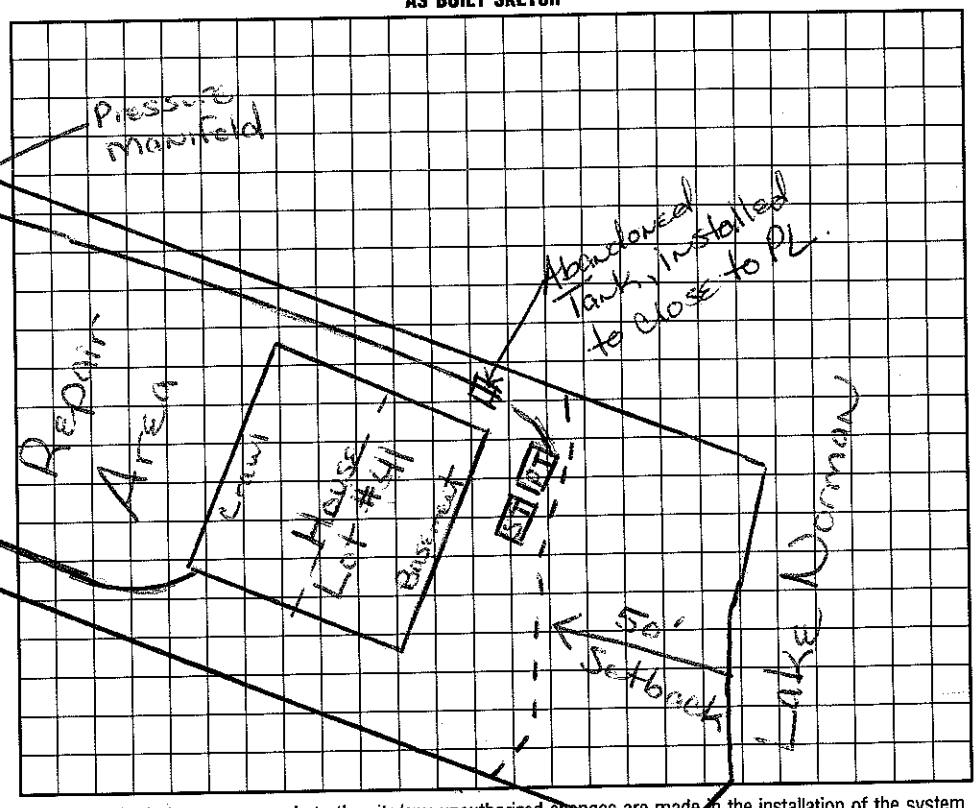

I understand that this permit can be suspended or revoked if any false information is supplied toward securing the permit/any unauthorized changes are made to the site/any unauthorized changes are made in the installation of the system. Improvement Permit is valid for 60 months from date of issuance.

Signed: _____

Improvement Permit by: Maria H. Dotson date 5/30/97

Existing System Inspection by: Maria H. Dotson R.S. date 1/13/98

Installed by: Big MacGill Brothers Inc

Certificate of Completion by: Maria H. Dotson R.S. date 8/31/99

Operation Permit by: Maria H. Dotson R.S. date 8/31/99

HEALTH DEPT. COPY: WHITE INSPECTION COPY (FINAL): GREEN OWNER COPY (FINAL): YELLOW INSPECTION COPY (INITIAL): PINK OWNER COPY (INITIAL): GOLD