IREDELL COUNTY HEALTH DEPARTMENT Const Auth

STATESVILLE 704-878-5305 MOORESVILLE 704-664-5281

IMPROVEMENT PERMIT / ~~CERTIFICATE OF COMPLETION~~ / OPERATION PERMIT / EXISTING SYSTEM INSPECTION

PROPERTY DESCRIPTION NO. 065677 DATE July 7 97 TAX MAP NO. 4625941684 (pt.) 4625-29-4489 Watershed: ☑ Yes ☐ No

OWNER OR CONTRACTOR Crescent Resources / LLOYD HARTSELL PHONE: Business _____ Home _____ WS II CA

ADDRESS PO Box 1003 / Charlotte / 2400 VERNON DR. CHARLOTTE NC 28815

LOCATION Brawley Sch Rd TR Bay Harbour TR Shepyard PT. TL Cedar Bluff TL Tranquil Cove on Right

SUBDIVISION The Harbour BLOCK / SECTION 6 LOT 43 LOT AREA .34556 ± SITE CLASS. RS DESIGN FLOW 120 gpd L.T.A.R. .3

Septic Tank: 1000 Gallons; STB 312 Date 3/07/02

Pump Tank: 1000 Gallons; PT 283 Date 4/2/05

Pump Make: Myers Model ME 505-11 Serial No. 25325 0007

Nitrification Field: No Fields 1 Square Feet 1200 Linear Feet 400

No Lines 4@100' Trench Width 36" Max Trench Bottom Depth 36"

☑ New System ☐ Repair System Type: I, II, III, IV, V, VI

System Description: pumped-pm- chambered

Repair System Description: LP Panel Block

Maintenance Agreement Required: ☐ Yes ☑ No

Gravel Depth N/A

☑ House/Mod. Home No. Bedrooms 4

☐ Mobile Home No. Bathrooms 4

☐ Business No. Employees _____

☐ Other _____


☐ Slab ☐ Crawl Space ☑ Basement w/plumbing ☐ Basement wo/plumbing

Water Supply: ☐ Individual ☑ Community ☐ Public


Comments:

Comments: shallow water installed

INITIAL SITE SKETCH

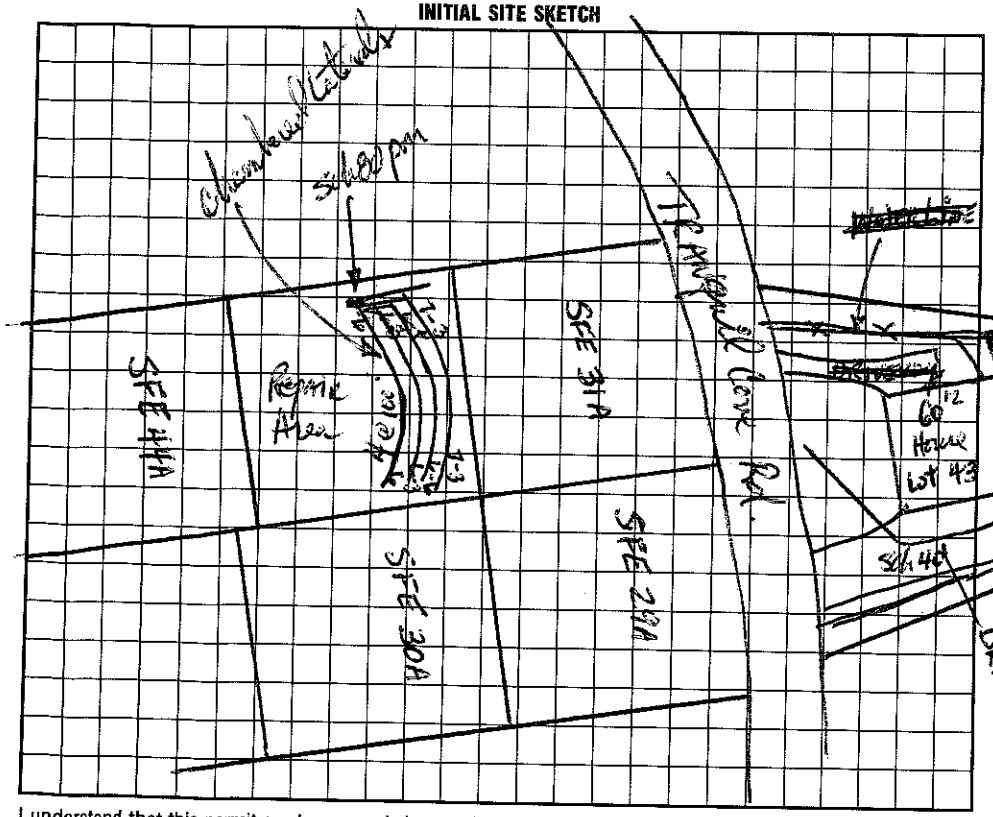

AS BUILT SKETCH

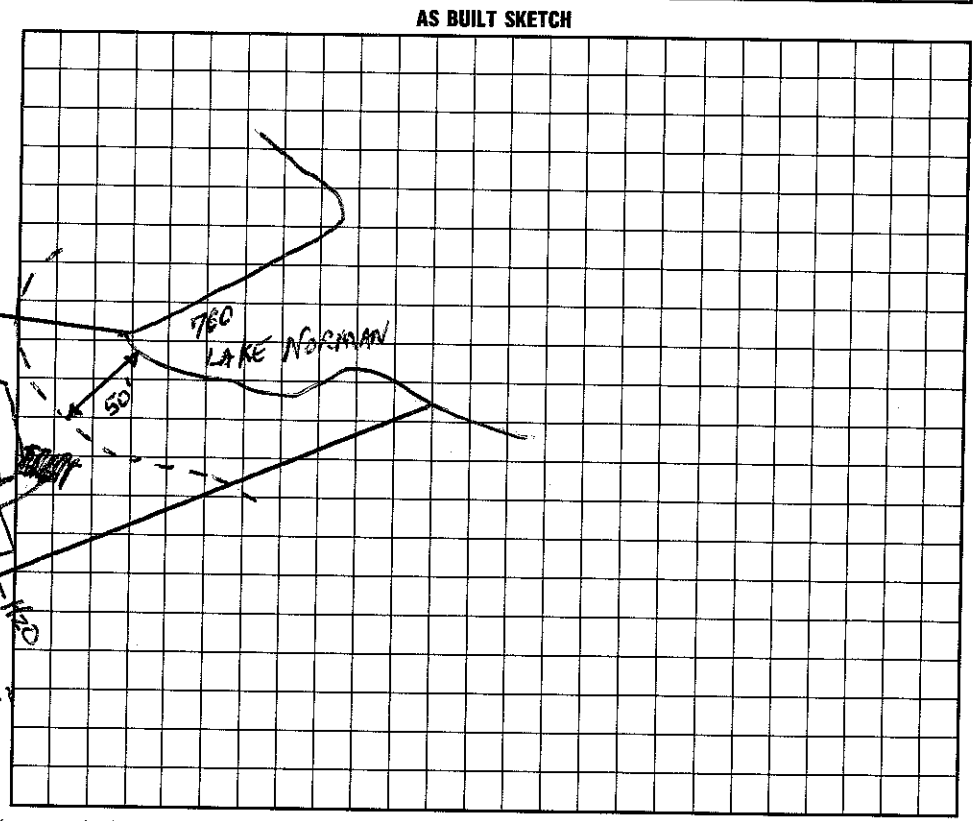

I understand that this permit can be suspended or revoked if any false information is supplied toward securing the permit/any unauthorized changes are made to the site/any unauthorized changes are made in the installation of the system. Improvement Permit is valid for 60 months from date of issuance.

Signed: _____

Improvement Permit by: _____ date 7-7-97

~~Construction Existing System Inspection by:~~ Authorization _____ date 8/27/02

Installed by: Art Dunning

Certificate of Completion by: _____ date 7/31/03

Operation Permit by: _____ date _____

HEALTH DEPT. COPY: WHITE INSPECTION COPY (FINAL): GREEN OWNER COPY (FINAL): YELLOW INSPECTION COPY (INITIAL): PINK OWNER COPY (INITIAL): GOLD