...ELL COUNTY HEALTH DEPARTMENT

...SVILLE 704-878-5305 MOORESVILLE 704-664-5281

Paid 175.00

IMPROVEMENT PERMIT / AUTHORIZATION TO CONS...OCT / OPERATION PERMIT / EXISTING SYSTEM INSPECTION

PERMIT# D65 6094 PIN# 4625941684 (Lot) 4625-29-4820 DATE 5-8-2000

OWNER OR CONTRACTOR Crescent Resources / Tom Stevens PHONE: Business 202-4710 (Zack Roberts (Builder) Home

ADDRESS Brawley Commons Ste. #503 6021 Brawley School Rd Mooresville, NC 28117

LOCATION Brawley School Rd TR Bay Harbour TR Shipyard Pt TC Cedar Bluff TC Tranquil Cove- 1st lot on left

SUBDIVISION Harbour BLOCK / SECTION 6 LOT 51 LOT AREA 32451 Ft² SITE CLASS. PS DESIGN FLOW 480 gpd L.T.A.R. .3

Septic Tank: 1000 Gallons; STB 794 Date 2-27-00

Pump Tank: Gallons; PT Date

Pump Make: Model Serial No.

Nitrification Field: No Fields 2 Square Feet 1206' Linear Feet 402'

No Lines 3+3 Trench Width 36" Max Trench Bottom Depth 36"

☒ New System ☐ Repair System Type: I, II, III, IV, V, VI *

System Description: Gravity - 25% Reduction *

Repair System Description: Same

Maintenance Agreement Required: ☐ Yes ☒ No

Gravel Depth N/A

☒ House/Mod. Home No. Bedrooms 4

☐ Mobile Home No. Bathrooms 3.5

☐ Business No. Employees

☐ Other


☐ Slab ☒ Crawl Space ☐ Basement w/plumbing ☐ Basement wo/plumbing

Water Supply: ☐ Individual ☐ Public ☒ Community


Comments/Conditions: Keep Septic System at least 10' From PL
*5' From House.
*25% Reduction in Drainfield area.
Note: Distribution = 1 Flow Divider to 2 Separate D-Boxes

Comments/Conditions: Checked tanks & lines

INITIAL SITE SKETCH Scale = 1:50

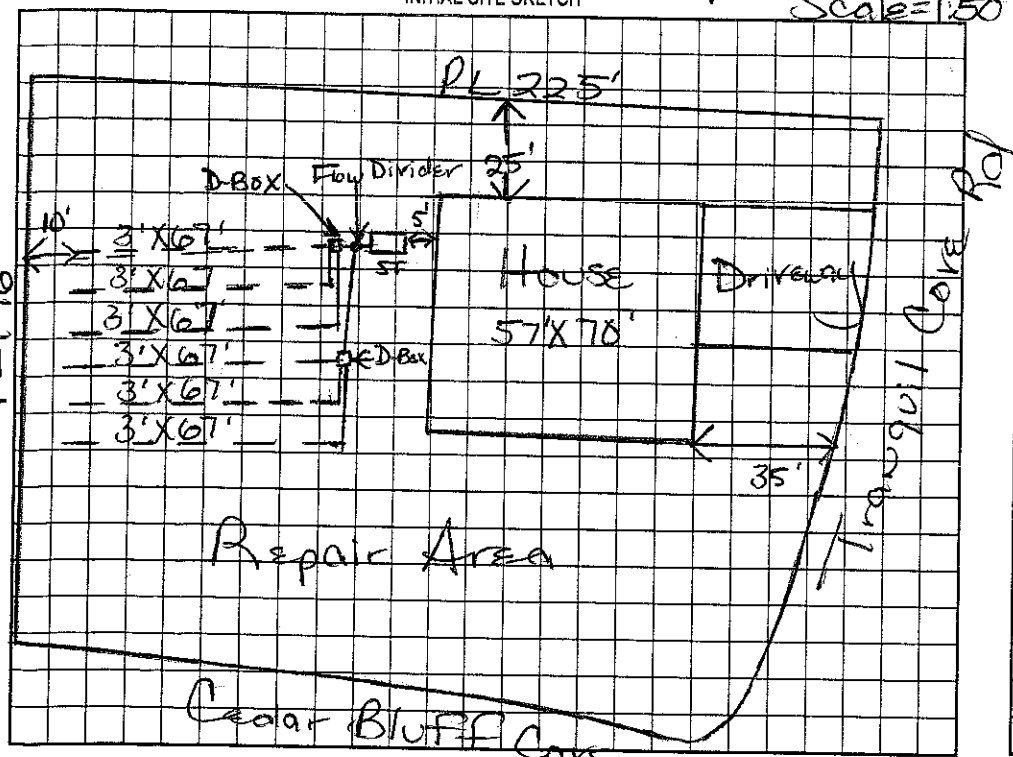

AS BUILT SKETCH

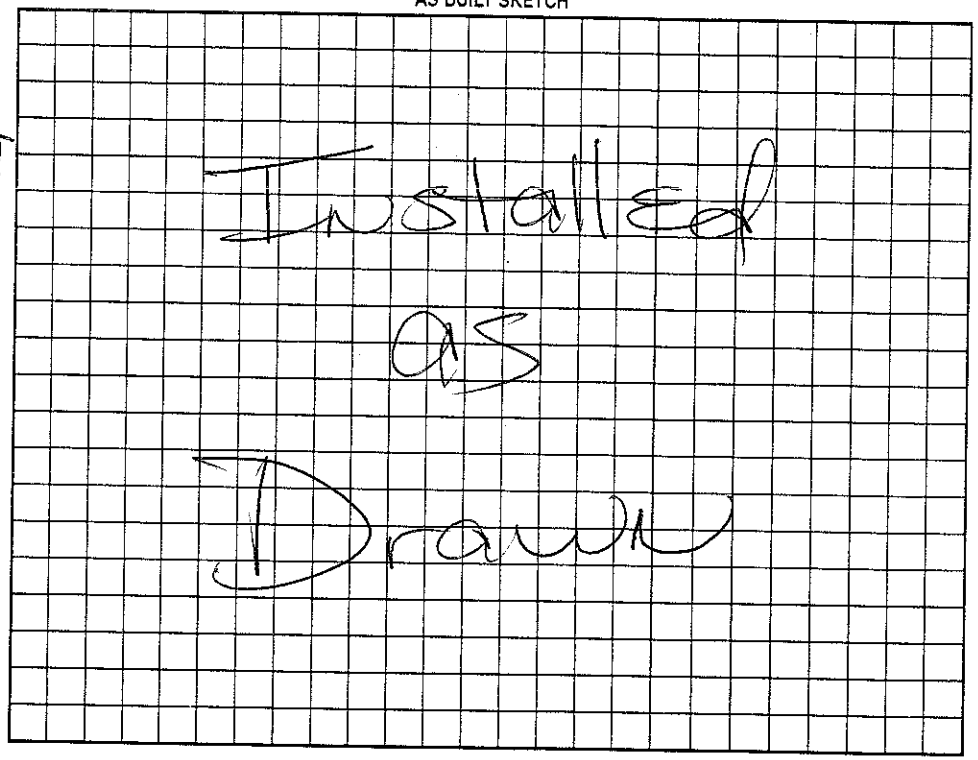

Permit can be suspended or revoked if any false information is supplied toward securing the permit/any unauthorized changes are made to the site/any unauthorized changes are made in the installation of the system. Improvement Permit with plat valid without expiration. Improvement Permit with site plan valid for sixty months. Authorization to Construct is valid for a period equal to that of Improvement Permit – not to exceed sixty months.

Signed: Zack Roberts date 5-8-2000 Installed by: R & H

Improvement Permit by: Maria H. Watson R.S. date 5/8/2000 Operation Permit by: Maria H. Watson date 8/24/2000

Authorization to Construct by: Maria H. Watson R.S. date 5/8/2000 Existing System Inspection by: date

HEALTH DEPT. COPY: WHITE OWNER COPY (FINAL): YELLOW OWNER COPY (INITIAL): PINK