IREDELL COUNTY HEALTH DEPARTMENT

STATESVILLE 704-878-5305 MOORESVILLE 704-664-5281

IMPROVEMENT PERMIT / AUTHORIZATION TO CONSTRUCT / OPERATION PERMIT / EXISTING SYSTEM INSPECTI

PERMIT# 065680 1085/4 PIN# 4625941684 pt DATE 6/12/03

OWNER OR CONTRACTOR GREG FISHER PHONE: Business _____ Home _____

ADDRESS PO BOX 3302 MOORESVILLE NC 28117

LOCATION BRAWLEY SCHOOL TR BAY HARBOUR - TR SHIPYARD - TL CEDAR BLUFF - TL TRANQUIL - ON RT.

SUBDIVISION HARBOUR BLOCK / SECTION 6 LOT 45 LOT AREA 26,744 ft² SITE CLASS. PS DESIGN FLOW 450 GPD L.T.A.R. .3680 ft²

Septic Tank: 1000 Gallons; STB 312 Date 3/9/03
Pump Tank: 1000 Gallons; PT 29 Date 4/24/03
Pump Make: GOULDS Model WEG 511 HM Serial No. E036223B
Nitrification Field: No Fields 1 Square Feet 556 Linear Feet 278
No Lines 6 Trench Width 24" Max Trench Bottom Depth 30" Gravel Depth _____

☑ New System ☐ Repair System Type: I, II, III, IV, V, VI
System Description: LP PANEL
Repair System Description: SAME - POSSIBLE
Maintenance Agreement Required: ☑ Yes ☐ No PUMP TREAT IN RECORD


☐ House/Mod. Home No. Bedrooms 4
☐ Mobile Home No. Bathrooms 4
☐ Business No. Employees _____
☐ Other _____
☐ Slab ☐ Crawl Space ☑ Basement w/plumbing ☐ Basement wo/plumbing

Water Supply: ☐ Individual ☐ Public ☑ Community


Comments/Conditions: 1) VERY POOR DESIGN BY TONEY JACOBS BUT MEETS MINIMUM REQUIREMENTS BY RULE. 2) VERY HIGH POSSIBILITY FOR PERMIT TO BE REVOKED IN POOL IS PUT IN WRONG PLACE.

Comments/Conditions: OR REPAIR IS ALTERED. 3) IF TANKS ARE TOO DEEP (GREATER THAN 36") TRAFFIC RATED TANKS SHALL BE INSTALLED.

INITIAL SITE SKETCH 1" = 50'

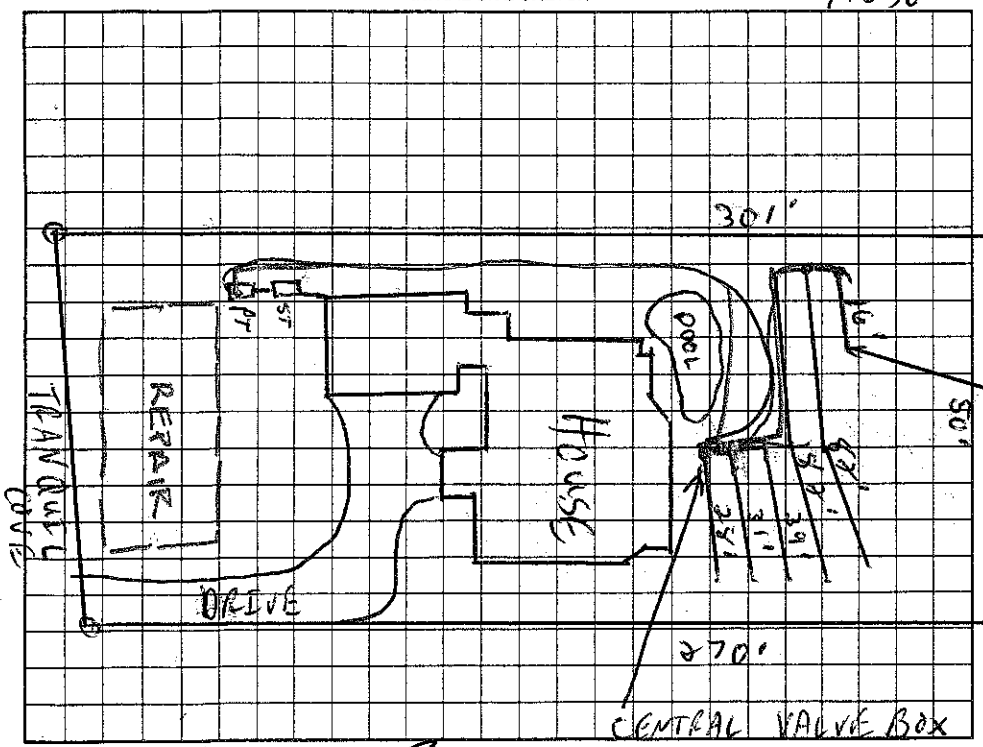

AS BUILT SKETCH

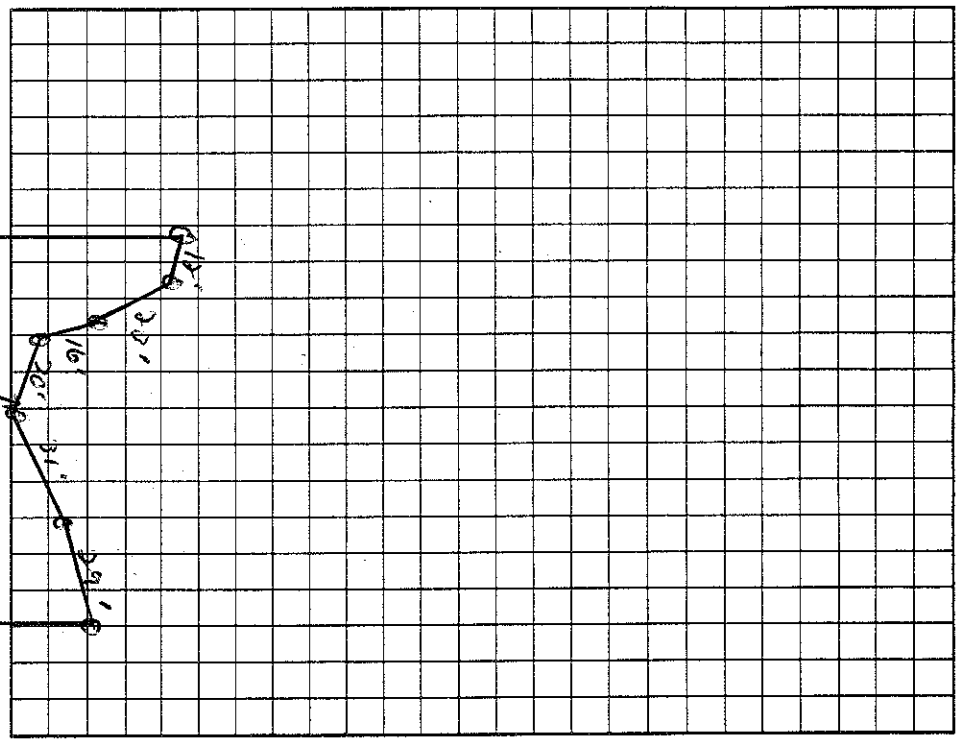

Permit can be suspended or revoked if any false information is supplied toward securing the permit/any unauthorized changes are made to the site/any unauthorized changes are made in the installation of the system. Improvement Permit with plat valid without expiration. Improvement Permit with site plan valid for sixty months. Authorization to Construct is valid for a period equal to that of Improvement Permit – not to exceed sixty months.

Signed: _____ date _____ Installed by: Orbison Const. Co.

Improvement Permit by: C. Hoyle RS date 6/12/03 Operation Permit by: Wesley Sparks RS. date 7/16/03

Authorization to Construct by: C. Hoyle RS date 6/12/03 Existing System Inspection by: _____ date _____

HEALTH DEPT. COPY: WHITE OWNER COPY (FINAL): YELLOW OWNER COPY (INITIAL): PINK