124 / 10

IREDELL COUNTY HEALTH DEPARTMENT

STATESVILLE 704-878-5305 MOORESVILLE 704-664-5281

200

IMPROVEMENT PERMIT / AUTHORIZATION TO CONSTRUCT / OPERATION PERMIT / EXISTING SYSTEM INSPECTION

PERMIT# 101240 PIN# 4625 94 1684.835 Dealer 4625-30-9506 DATE Oct 9, 01

OWNER OR CONTRACTOR Crescent Resources Inc - / Brookshire Const / PHONE: Business _____ Home _____

ADDRESS P.O. Box 1003, Charlotte N.C. 28201

LOCATION Brawley Sch Rd. TR Broad Sound Ct. - SFE 1st Lot on left - Building Lot at end TR Broad on left

SUBDIVISION The Point BLOCK / SECTION 8 LOT 835, 835A LOT AREA 72,223 ft² + 44,910 ft² SITE CLASS. PS SFE DESIGN FLOW 720 gpd L.T.A.R. .3 SFE

Septic Tank: 1500 Gallons: STB 338 Date 7-15-05

Pump Tank: 1500 Gallons: P.T. 477 Date 12-4-01

Pump Make: Goulds Model P102 Serial No. _____

Nitrification Field: No Fields 1 Square Feet 1800 Linear Feet 600

No Lines 6 @ 100' Trench Width 36" Max Trench Bottom Depth 36" Gravel Depth N/A

☑ New System ☐ Repair System Type: I, II, III, IV, V, VI

System Description: PM - Innovative - 25% Red.

Repair System Description: Innovative or PPBPS

Maintenance Agreement Required: ☐ Yes ☑ No

☑ House/Mod. Home No. Bedrooms 6

☐ Mobile Home No. Bathrooms 6

☐ Business No. Employees _____

☐ Other _____


☐ Slab ☐ Crawl Space ☑ Basement w/plumbing ☐ Basement wo/plumbing

Water Supply: ☐ Individual ☑ Public ☑ Community

Comments:/Conditions:

Comments:/Conditions: Some standing water in uppermost trench. E/ Flow installed as Drawn 4/5/05 mg

INITIAL SITE SKETCH 1" = 100'

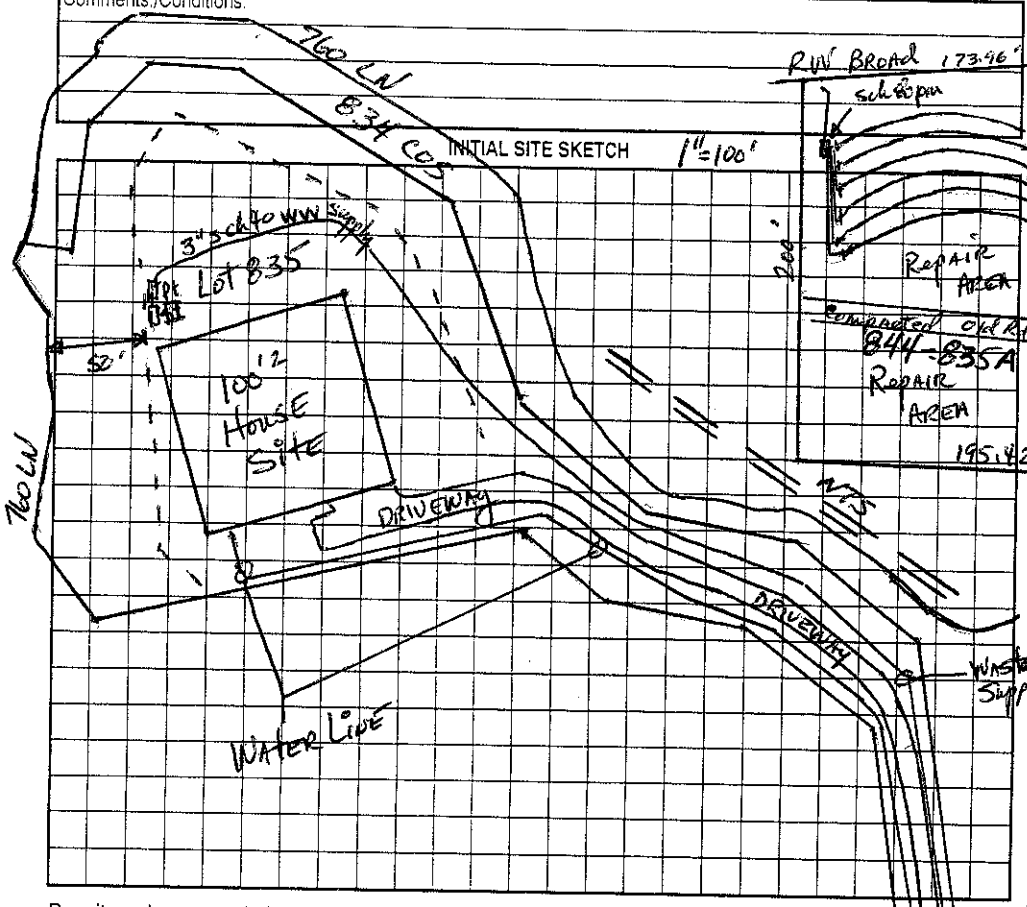

AS BUILT SKETCH

Pressure, Elect & alarm 2/20/01

The proposed / existing Pool House / Cabana addition does not appear to impact the existing septic system.

**NOTE: Must be 5' from tanks

R.S.

Date: 9-11-12

ICHD-Environmental Health Division

Permit can be suspended or revoked if any false information is supplied toward securing the permit/any unauthorized changes are made to the site/any unauthorized changes are made in the installation of the system. Improvement Permit with plat valid without expiration. Improvement Permit with site plan valid for sixty months. Authorization to Construct is valid for a period equal to that of Improvement Permit -- not to exceed sixty months.

Signed: _____ date 10/9/01

Improvement Permit by: _____ date 10-9-01

Authorization to Construct by: Wesley Sparks RS. date 2/10/03

Installed by: R & H

Operation Permit by: Mark H Dotson RS date 2/20/01

Existing System Inspection by: _____ date _____

HEALTH DEPT. COPY: WHITE OWNER COPY (FINAL): YELLOW OWNER COPY (INITIAL): PINK