IREDELL COUNTY HEALTH DEPARTMENT

AUTHORIZATION TO CONSTRUCT

4625-37-0732

STATESVILLE 704-878-5305 MOORESVILLE 704-664-5281

IMPROVEMENT PERMIT / ~~CERTIFICATE OF COMPLETION~~ / OPERATION PERMIT / EXISTING SYSTEM INSPECTION

PROPERTY DESCRIPTION NO. 25759 DATE 7/24/97 TAX MAP NO. pt of JC-A-3 Watershed: ☑ Yes ☐ No

OWNER OR CONTRACTOR TRENT C. ADAMS PHONE: Business 910-760-1540 Home

ADDRESS 401 TOWNLEY STREET - WINSTON-SALEM N.C.

LOCATION BRAWLEY SCHOOL RD - TR BAY HARBOR - AT END ON RT BEFORE GOOSENECK

SUBDIVISION HARBOUR BLOCK / SECTION V LOT 30 LOT AREA -- SITE CLASS. PS DESIGN FLOW 450GPD L.T.A.R. .3 GPD/FT²

Septic Tank: 1000 Gallons; STB 794 Date 5/21/00

Pump Tank: 1000 Gallons; PT 283 Date 4/16/00

Pump Make: MYERS Model ME-50511 Serial No. 25325D009

Nitrification Field: No Fields 1 Square Feet 550 Linear Feet 275

No Lines 3 Trench Width 24" Max Trench Bottom Depth 36" Gravel Depth NA

☑ New System ☐ Repair System Type: I, II, III, (IV) V, VI

System Description: PUMP PANEL

Repair System Description: SAME

Maintenance Agreement Required: ☑ Yes ☐ No

☑ House/Mod. Home No. Bedrooms 4

☐ Mobile Home No. Bathrooms 4

☐ Business No. Employees

☐ Other


☐ Slab ☑ Crawl Space ☐ Basement w/plumbing ☐ Basement wo/plumbing

Water Supply: ☐ Individual ☑ Community ☐ Public


Comments:

Comments:

INITIAL SITE SKETCH

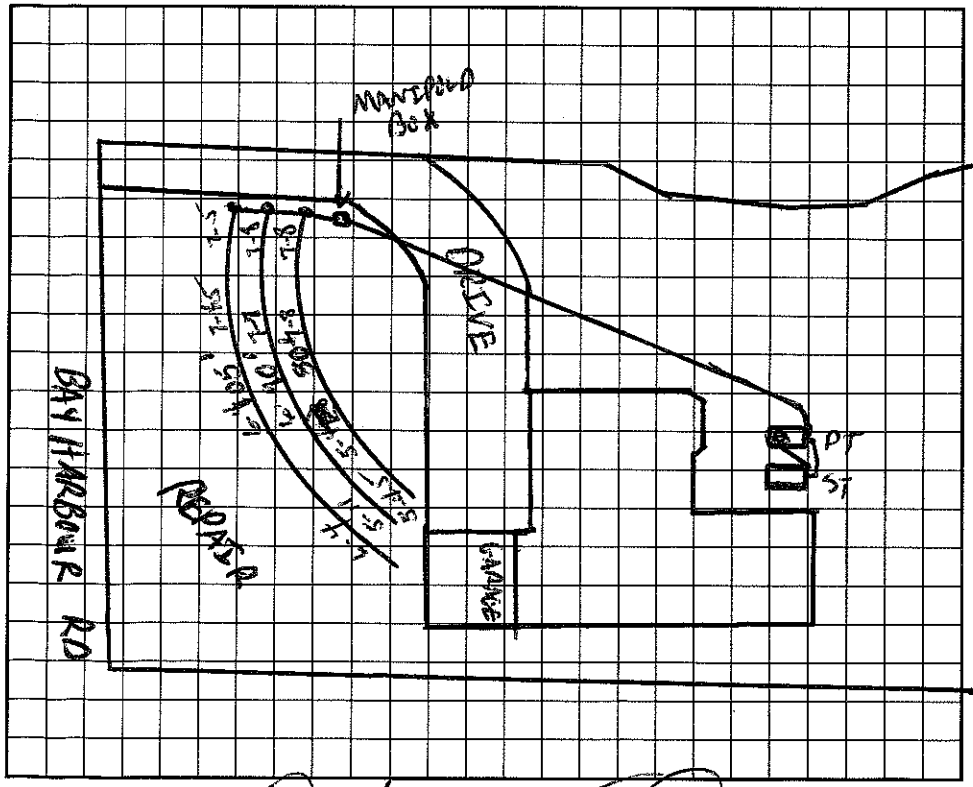

AS BUILT SKETCH

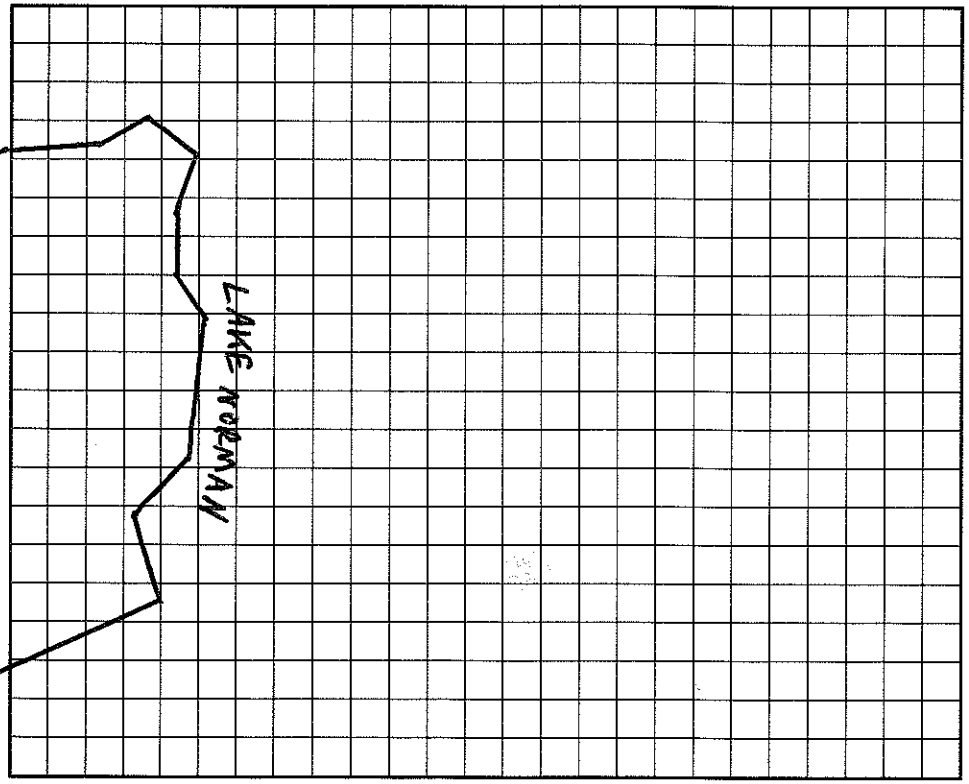

I understand that this permit can be suspended or revoked if any false information is supplied toward securing the permit/any unauthorized changes are made to the site/any unauthorized changes are made in the installation of the system. Improvement Permit is valid for 60 months from date of issuance.

Signed: Agent 7/24/97

Improvement Permit by: date 7/24/97

~~Existing System Inspection by:~~ AUTHORIZATION TO CONSTRUCT date 7/24/97

Installed by: Orbison Const. Co.

Certificate of Completion by: Wesley Sparks R.S. date 8/18/00

Operation Permit by: date

HEALTH DEPT. COPY: WHITE INSPECTION COPY (FINAL): GREEN OWNER COPY (FINAL): YELLOW INSPECTION COPY (INITIAL): PINK OWNER COPY (INITIAL): GOLD