IREDELL COUNTY HEALTH DEPARTMENT

Statesville Office (704) 878-5305 | Mooresville Office (704) 660-3625 | PERMIT # 211962

IMPROVEMENT PERMIT / AUTHORIZATION TO CONSTRUCT / OPERATION PERMIT / EXISTING SYSTEM

PIN # 4625-37-0854

APPLICANT: PHILLIP HURST | APPLICANT ADDRESS: 4246 SIGMON COVE LN. TERRELL NC 28682

SITE ADDRESS: 444 BAY HARBOUR Rd. | PHONE: 704-936-7508 | ALT. PHONE:

SITE DIRECTIONS: BSR, TR BAY HARBOUR, ON R

SUBDIVISION: THE HARBOUR | SECTION: 5 | LOT # 31 | LOT AREA: .59 AC | DESIGN FLOW: 480 | L.T.A.R.: .3 (.1R)

Septic Tank EXISTING (gal) | STB | Date
Pump Tank EXISTING (gal) | PT | Date
Pump Make ORENCO | Model PF500512 | Serial #
Nitrification Fields | # Lines EXISTING | Linear Ft:
Trench Width | Max. Trench Bottom Depth 7 | Gravel Depth —

☐ New System ☐ Repair ☐ Expansion System Type: I II III (IV) V VI
System Description: LP PANEL BLOCK
Repair System Description: PANEL BLOCK + DRIP TS-11
Maintenance Agreement Required: ☒ YES ☐ NO
☐ GRAVITY ☒ PRESSURE

☐ Residence ☐ Business ☒ Other ☐ Slab ☐ Basement w/plumbing
No. Bedrooms 4 | No. Persons | No. Employees | ☐ Crawl Space
Water Supply: ☐ Private ☐ Public ☐ Community
☐ Basement w/o plumbing

Comments / Conditions:

POOL

INITIAL SITE SKETCH

SEE PLAN FROM PENNINGER SOIL CONSULTING

AS BUILT SKETCH

Permit can be suspended or revoked if any false information is supplied toward securing the permit / any unauthorized changes are made to the site / any unauthorized changes are made in the installation of the system. **CONTACT A LOCATOR SERVICE PRIOR TO ANY EXCAVATION**


☐ **IMPROVEMENT PERMIT** *with plat valid without expiration.* ☐ **IMPROVEMENT PERMIT** *with site plan valid for 60 mos.* ☐ **AUTHORIZATION TO CONSTRUCT** *valid for period equal to IMPROVEMENT PERMIT--not to exceed 60 mo.*

Owner / Applicant Signature: Phillip Hurst | Date: 7/21/15 | Installed by:

IMPROVEMENT PERMIT by: [signature] | Date: APPROVED JUL 15 2015 | OPERATION PERMIT by: [signature] | APPROVED Date: JUL 15 2015

AUTHORIZATION TO CONSTRUCT by: [signature] | Date: APPROVED JUL 15 2015 | Existing System Inspected by: | Date:

Health Dept. Copy - WHITE Applicant (Final Approval) - YELLOW Applicant (Conditional Approval) - PINK

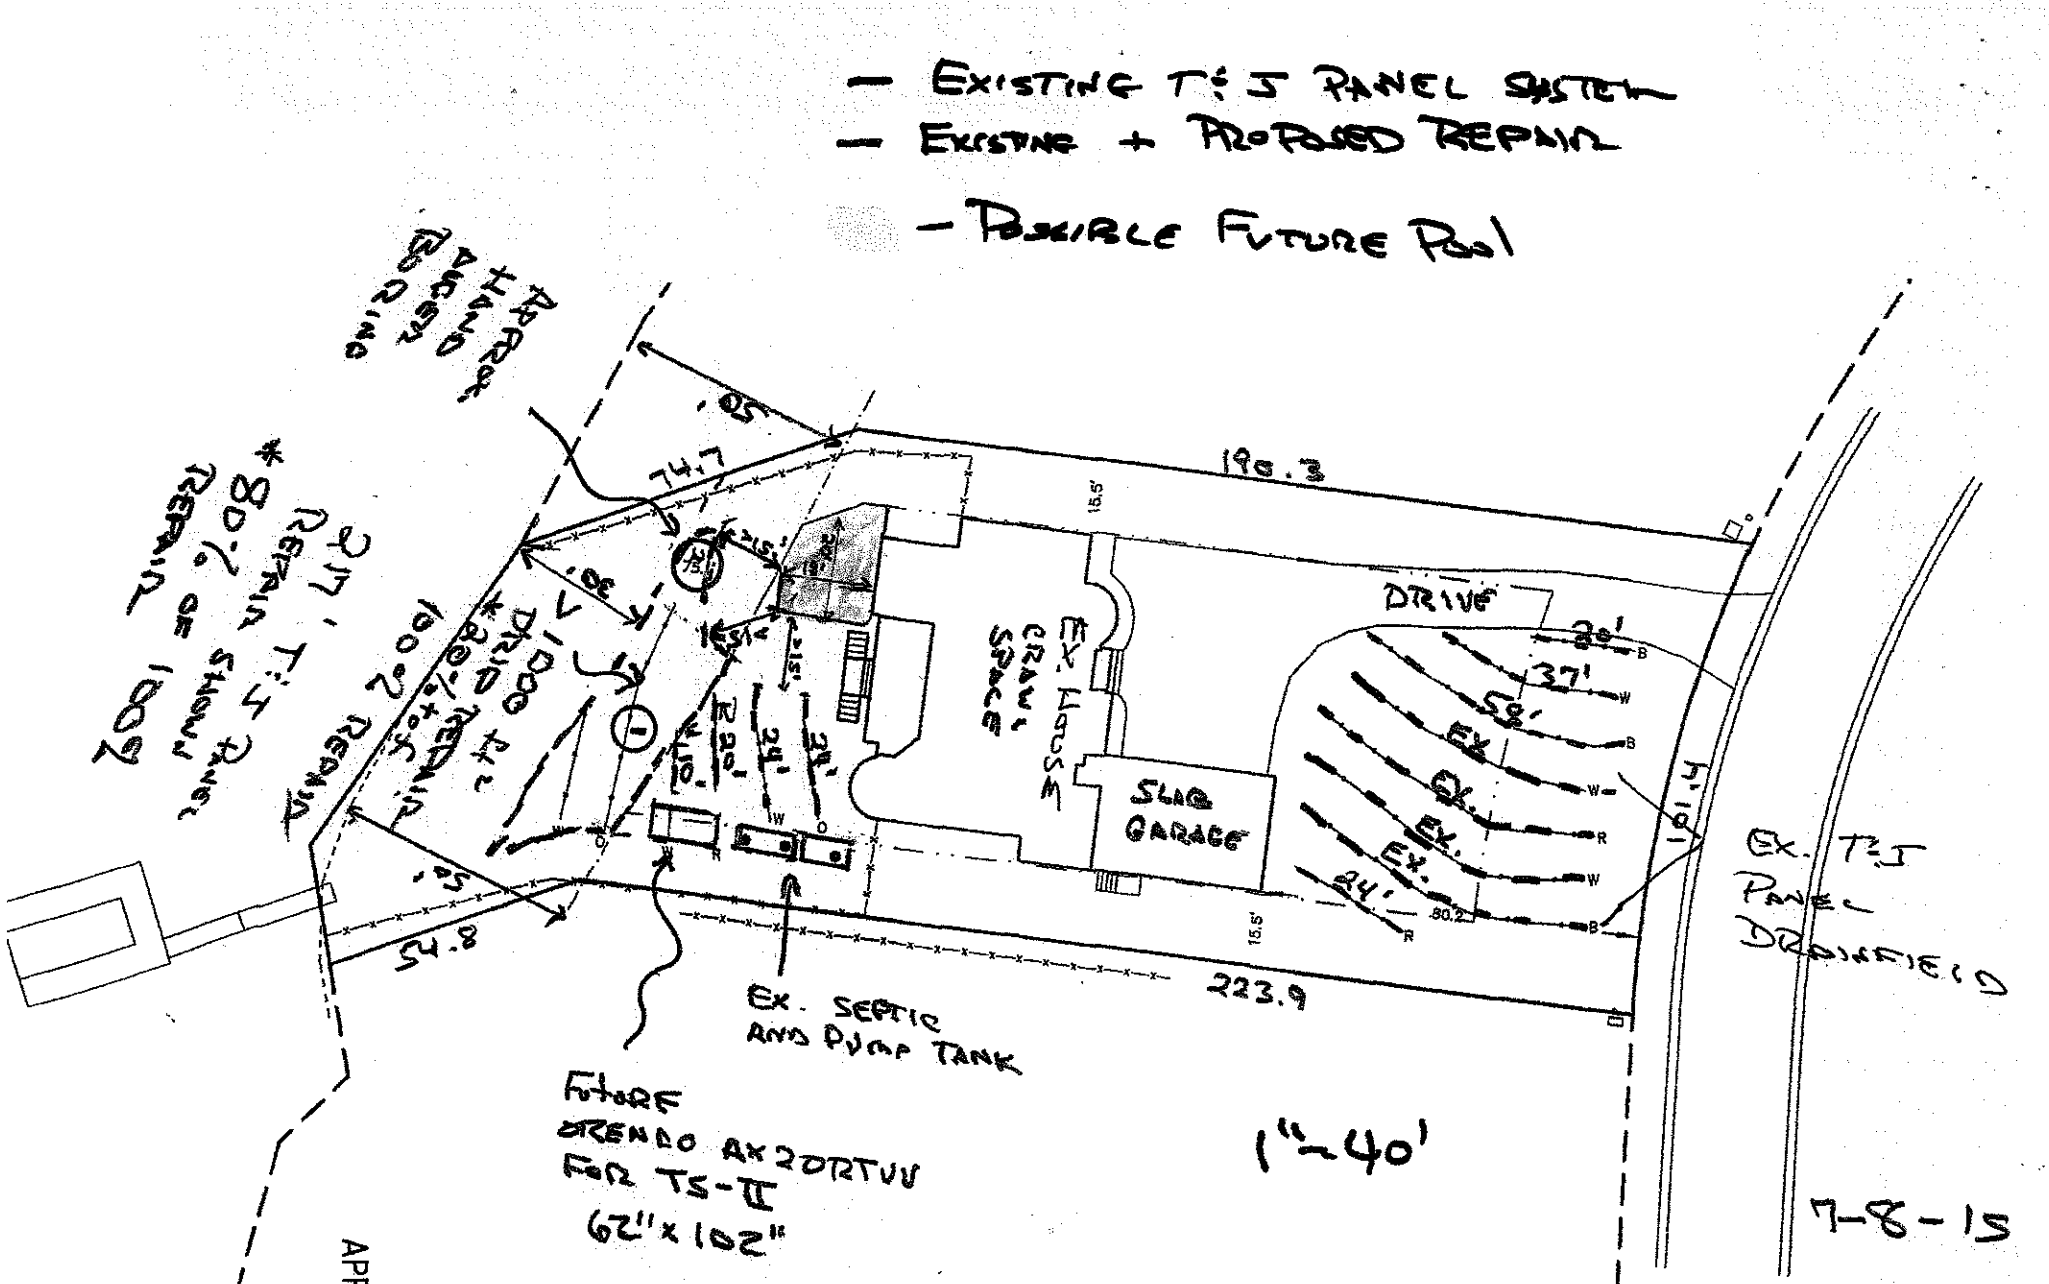

– 444 BAY HARBOUR – LOT 31 PH. 5

– FUTURE POOL – REVISED 100% REPAIR SKETCH

* MUST ACCOMPANY PERRINGER SOIL CONSULTING, PLLC WRITTEN REPORT