IREDELL COUNTY HEALTH DEPARTMENT

STATESVILLE 704-878-5305 MOORESVILLE 704-664-5281

IMPROVEMENT PERMIT / AUTHORIZATION TO CONSTRUCT / OPERATION PERMIT / EXISTING SYSTEM INSPECTION

700.00 sq.ft. 11:00

PERMIT# 129488 PIN# 4625 37 0854 DATE 1/6/06

OWNER OR APPLICANT Bernie Wilber / Stonebridge PHONE: Business 864 979 5786 Home

ADDRESS Po Box 12212 Greenville, SC 29612

LOCATION Brawley School Rd (R) Bay Harbor Rd (R) Lot 444 Bay Harbor Rd

SUBDIVISION The Harbour BLOCK / SECTION 5 LOT 31 LOT AREA .59 acres SITE CLASS. PS DESIGN FLOW 480 gpd L.T.A.R. .3

Septic Tank: 1000/1500 Gallons; STB 338 Date 9/2/14

Pump Tank: ~~1000~~/1500 Gallons; PT 477 Date 9/2/14

Pump Make: Orenco Model PF500512 Serial No.

Nitrification Field: No Fields 1 Square Feet Eq 1600 Linear Feet 270

No Lines 4 Trench Width 24" Max Trench Bottom Depth 30" Gravel Depth NA ☐ Gravity ☒ Pressure

☒ New System ☐ Repair ☐ Expansion System Type: I II III IV V VI

System Description: LP PPBPS

Repair System Description: same

Maintenance Agreement Required: ☒ Yes ☐ No

☒ House/Mod. Home ☐ Mobile Home ☐ Business ☐ Other

No. Bedrooms 4 No. Persons ___ No. Employees ___


Water Supply: ☐ Individual ☒ Public ☒ Community

☐ Slab ☐ Crawl Space ☒ Basement w/plumbing ☐ Basement wo/plumbing


Comments/Conditions: Install on contour. Main x/in setbacks.
use 5/32 holes. Tank drawdown: 8" Pump: 28 GPM vs 44' TDH
Tight system - install exactly as drawn

Comments/Conditions: - 36" Trench width
- Crawl Space Home.
- Lines shifted to left facing front of House.

INITIAL SITE SKETCH SCALE: 1" = 50'

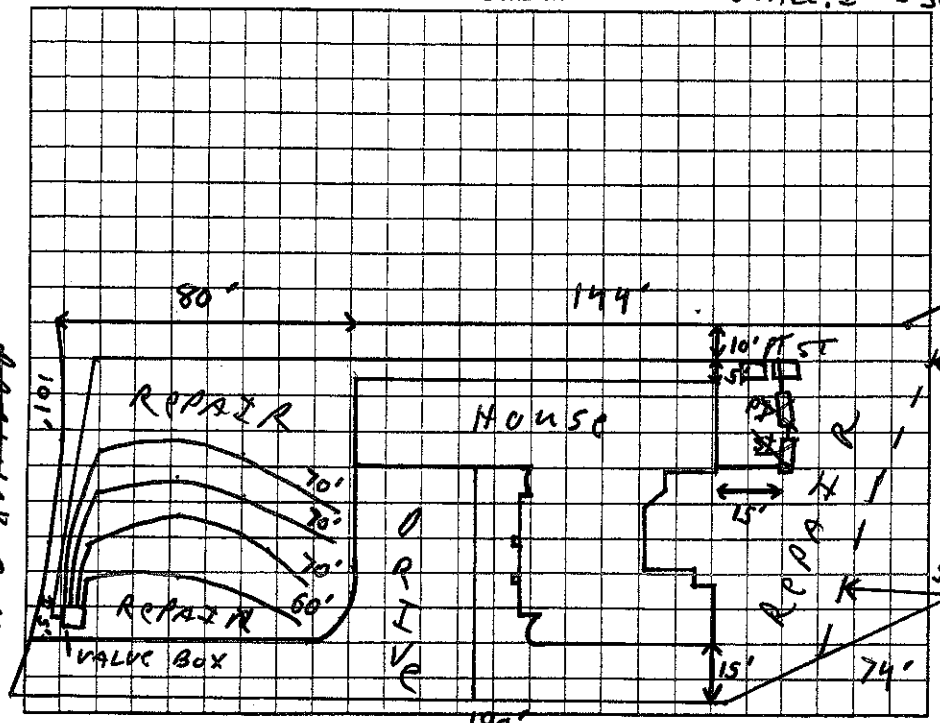

AS BUILT SKETCH

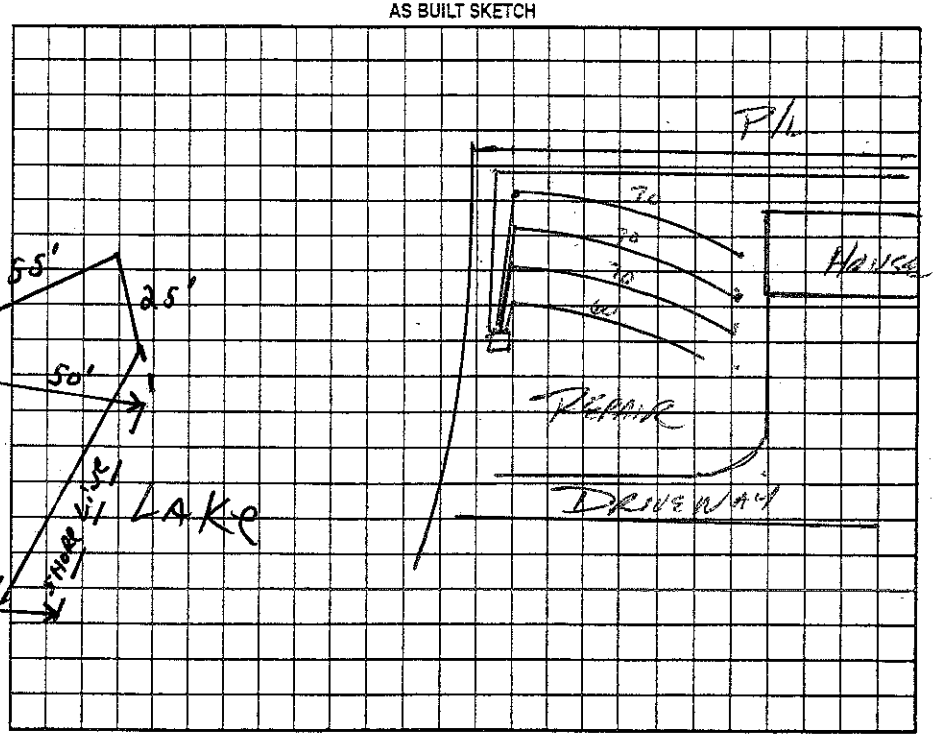

Permit can be suspended or revoked if any false information is supplied toward securing the permit/any unauthorized changes are made to the site/any unauthorized changes are made in the installation of the system. Improvement Permit with plat valid without expiration ☐ Improvement Permit with site plan valid for sixty months ☒ Authorization to Construct is valid for a period equal to that of Improvement Permit – not to exceed sixty months.

Signed: _____ date ___

Improvement Permit by: _____ date 1/6/06

Authorization to Construct by: _____ date 5-17-13

Installed by: Steve Jordan

Operation Permit by: _____ date APPROVED NOV 17 2014

Existing System Inspection by: _____ date ___

HEALTH DEPT. COPY: WHITE OWNER COPY (FINAL): YELLOW OWNER COPY (INITIAL): PINK