IREDELL COUNTY HEALTH DEPARTMENT *ENVIRONMENTAL HEALTH DIVISION:*

SITE PLAN WORKSHEET

SEE THE "SAMPLE SITE PLAN" BELOW. ***INCOMPLETE SITE PLANS WILL BE RETURNED TO YOU FOR COMPLETION AND MAY RESULT IN A DELAY IN THE ISSUANCE OF YOUR SEPTIC SYSTEM PERMIT!!!***

Place an (X) beside each item as you complete the site plan:

____ Property Line measurements are clearly identified… **____ All proposed structures are indicated…**

SHOW: proposed house or business footprint, wells, water lines, patios, pools and decks, and any other item that will occupy space on the site


____ Front and side setbacks from property line… **____ Preferred driveway location and configuration, preferred well location…**

____ Area you prefer your septic system to be placed… **____ North arrow, or other sufficient indicator of direction…**

Circle N/A on the following if appropriate:

____ Location of septic systems and wells within 100' of your property… N/A

____ Location of easements and rights of ways on your property… N/A **____ Location of any designated wetlands on the property… N/A**

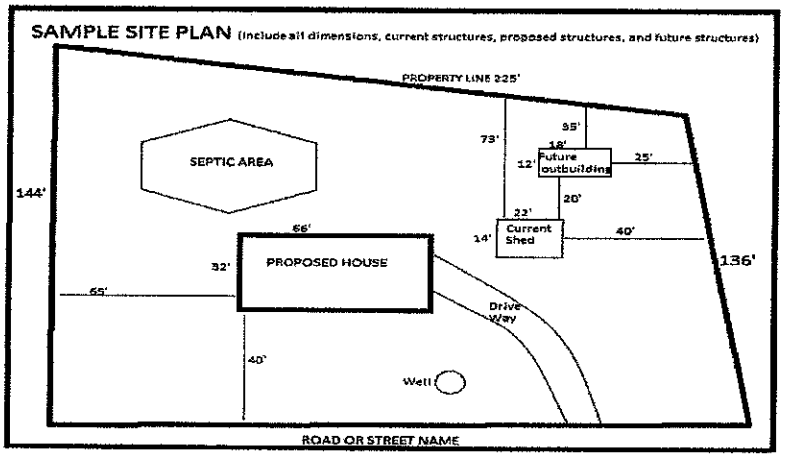

USE THIS SPACE TO DRAW YOUR SITE PLAN

See Attached Survey

Signature: _____

REQUIRED **property owner or ~~owner's legal~~ representative signature.**

7-8-15

DATE

IREDELL COUNTY HEALTH DEPARTMENT

STATESVILLE 704-878-5305 MOORESVILLE 704-664-5281

IMPROVEMENT PERMIT / AUTHORIZATION TO CONSTRUCT / OPERATION PERMIT / EXISTING SYSTEM INSPECTION

700.00 Eq. 0 11:00

PERMIT# 139478 PIN# 4635 37 0854 DATE 1/6/06

OWNER OR APPLICANT Barwick Harbor / Stonebridge PHONE: Business 864 974 5786 Home

ADDRESS PO Box 12212 Greenville, SC 29612

LOCATION Barwick School Rd @ Bay Harbor Rd @ Lot 449 Bay Harbor Rd

SUBDIVISION The Harbour BLOCK / SECTION 5 LOT 21 LOT AREA .59 ACRES SITE CLASS CS DESIGN FLOW 360 gpd L.T.A.R. = 3

Septic Tank: 1000 1500 Gallons; STB 338 Date 9/12/14

Pump Tank: 1000 1000 Gallons; PT 477 Date 9/12/14

Pump Make Orenco Model PF300512 Serial No.

Notification Field; No Fields 1 Square Feet 540/600 Linear Feet 270

No Lines 4 Trench Width 24" Max Trench Bottom Depth 30" Gravel Depth N/A ☐ Gravity ☒ Pressure ☐ Slab ☐ Crawl Space ☒ Basement w/plumbing ☐ Basement w/o plumbing

☒ New System ☐ Repair ☐ Expansion System Type: I II III IV V

System Description: LPP Pump

Repair System Description: Same

Maintenance Agreement Required: ☒ Yes ☐ No

☒ House/Mod. Home ☐ Mobile Home ☐ Business ☐ Other

No. Bedrooms 4 No. Persons No. Employees


Water Supply: ☐ Individual ☒ Public ☐ Community

Comments/Conditions: Install on contour. Maintain setbacks. Use 5/3a Holes. Tank Arrangement: 8" Pump: 23 GPM vs 48' TDH


Tight System - Install Exactly as Drawn

Comments/Conditions: - 30" Treated Gravel Bed - Crawl Space Here - Lines Shifted To Left Facing Front of House

INITIAL SITE SKETCH SCALE: 1" = 50'

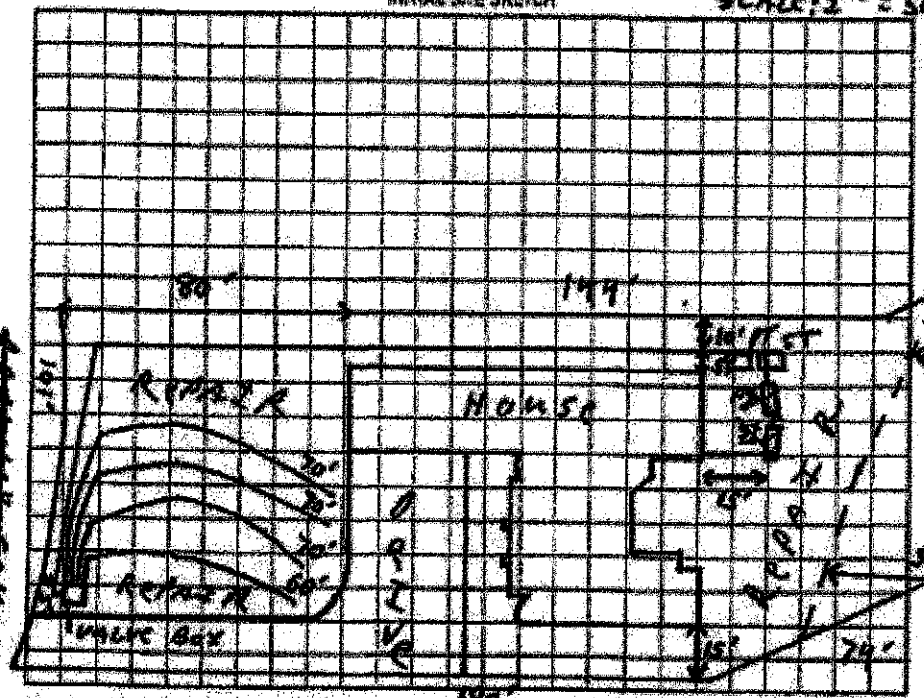

AS BUILT SKETCH

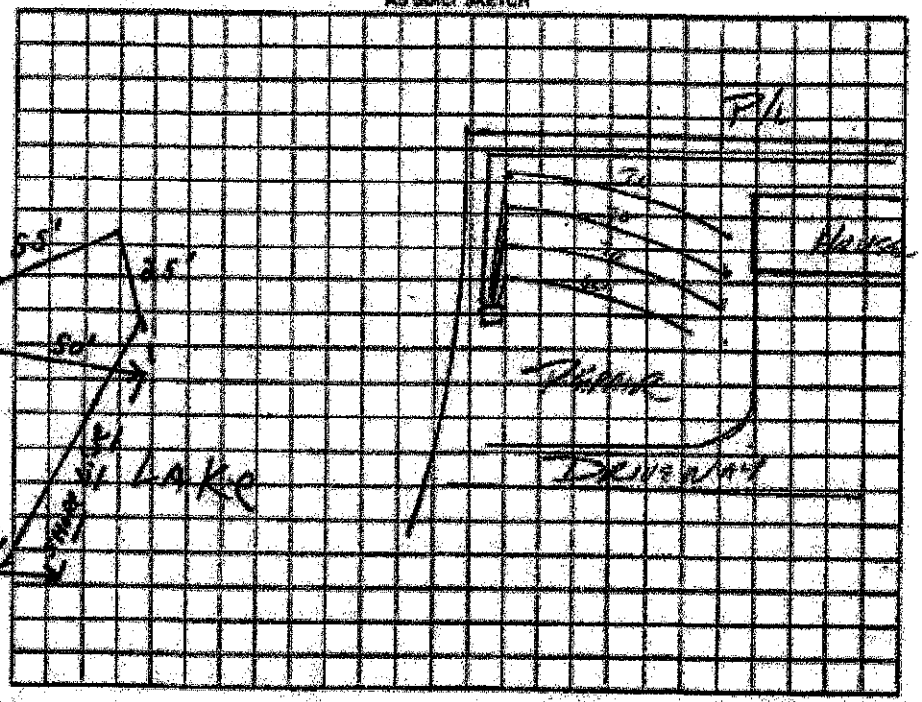

Permit can be suspended or revoked if any false information is supplied toward securing the permit, any unauthorized changes are made to the site, any unauthorized changes are made in the installation of the system. Improvement Permit with plat valid without expiration ☐ Improvement Permit with site plan valid for sixty months ☒ Authorization to Construct is valid for a period equal to that of Improvement Permit – not to exceed sixty months.

Signed: date

Improvement Permit by: date 1/6/06


Authorization to Construct by: date 5-17-13

Installed by: Steve Lemay

Operation Permit by: APPROVED NOV 17 2014

Existing System Inspection by: date

HEALTH DEPT COPY: WHITE OWNER COPY (FINAL): YELLOW OWNER COPY (INITIAL): PINK

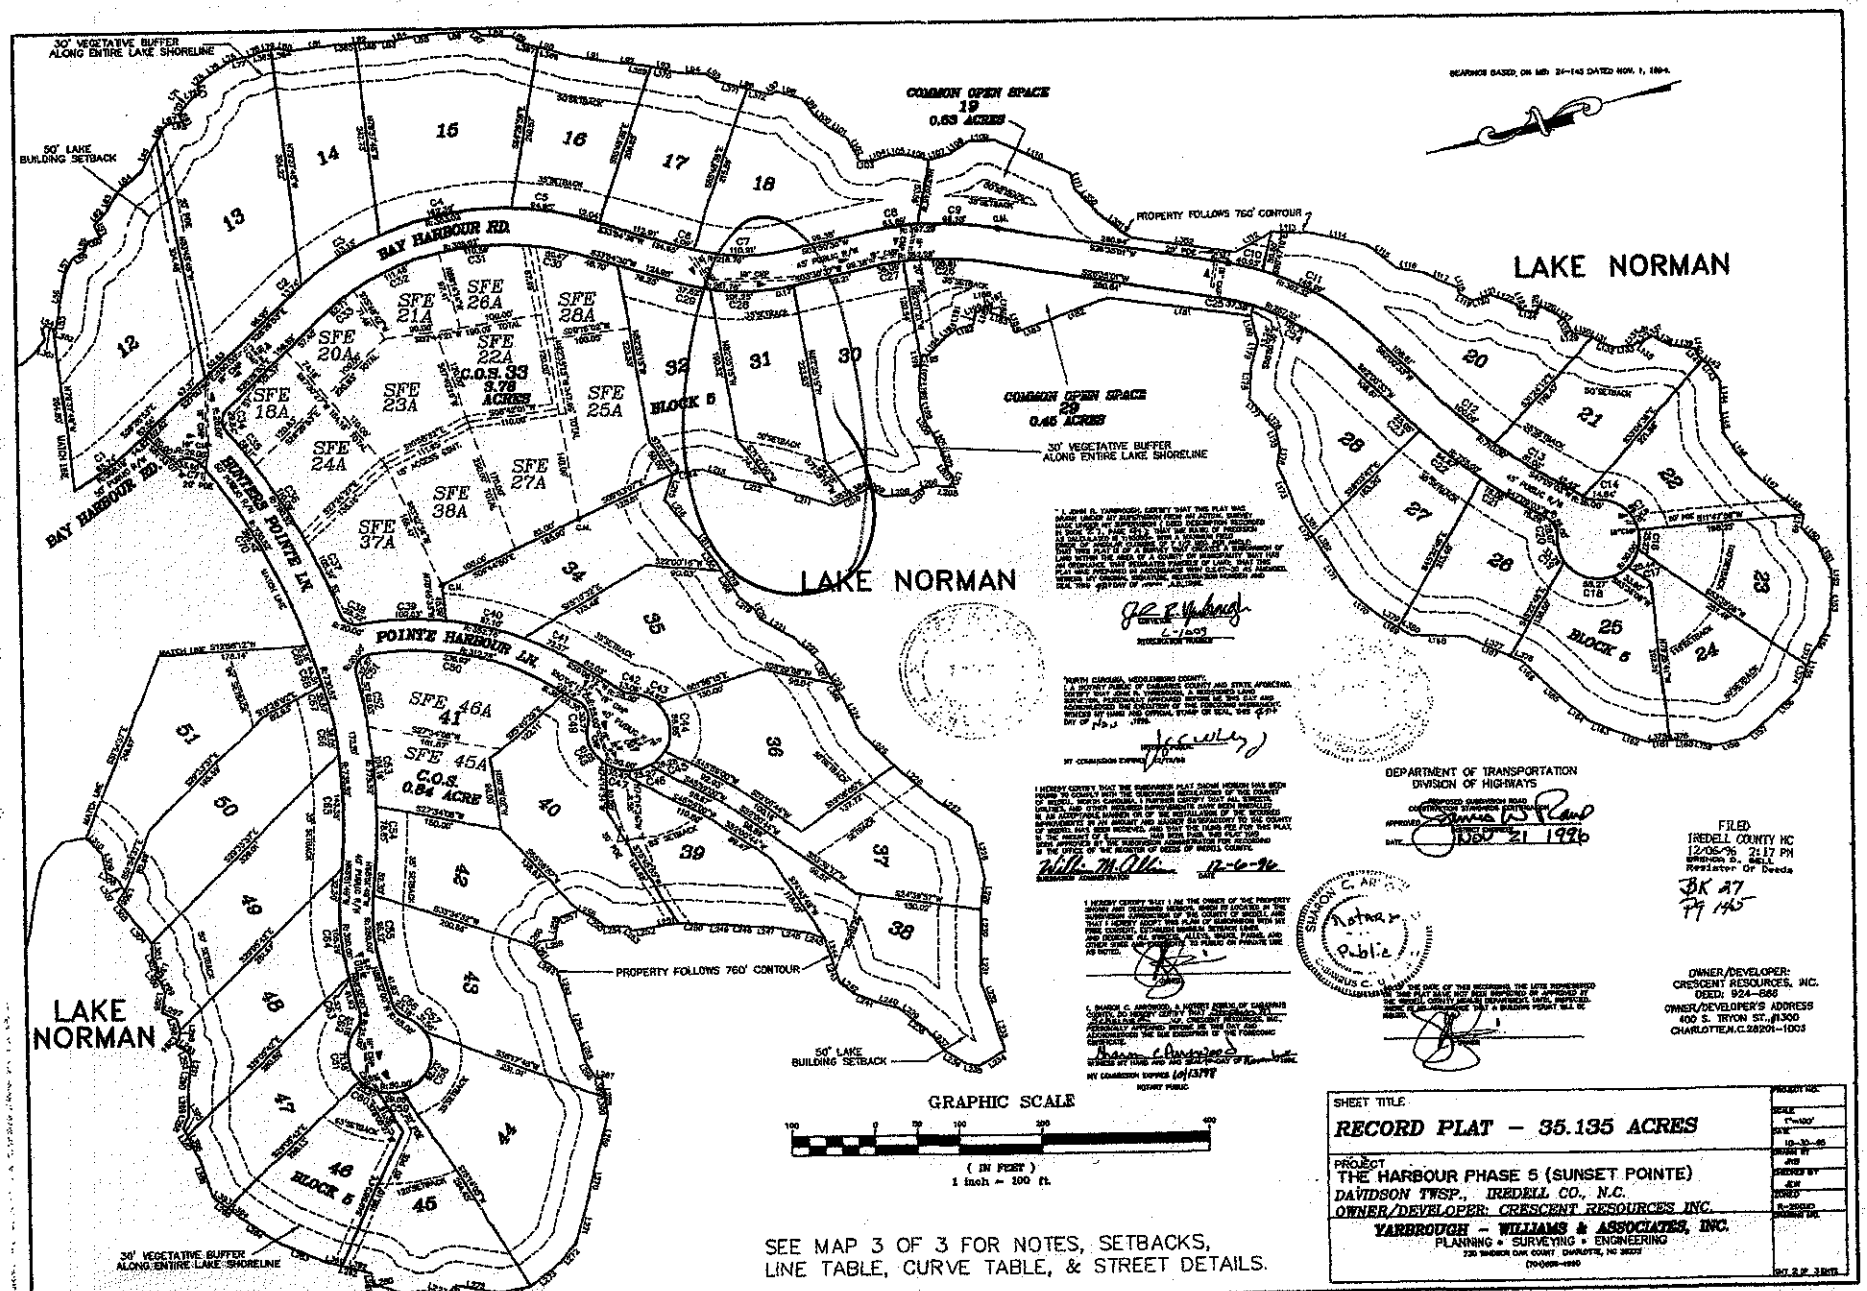

SEE MAP 3 OF 3 FOR NOTES, SETBACKS, LINE TABLE, CURVE TABLE, & STREET DETAILS.