IREDELL COUNTY HEALTH DEPARTMENT

STATESVILLE 704-878-5305 MOORESVILLE 704-664-5281

IMPROVEMENT PERMIT / AUTHORIZATION TO CONSTRUCT / OPERATION PERMIT / EXISTING SYSTEM INSPECTION

PERMIT# 104831 PIN# 4625 37 0994 DATE 1/27/03

OWNER OR CONTRACTOR HOKE CO. / JALAL MONTAZERI PHONE: Business 704-799-7495 Home

ADDRESS PO BOX 4448 MOORESVILLE, NC. 28117 438 BAY HARBOUR RD.

LOCATION BRAWLEY SCH TR BAY HARBOUR ON RT BEFORE GOOSENECK

SUBDIVISION HARBOR BLOCK / SECTION 5 LOT 32 LOT AREA .6AC SITE CLASS. PS DESIGN FLOW 480 L.T.A.R. .3

Septic Tank: 1000 Gallons; STB 794 Date 9/14/02
Pump Tank: 1000 Gallons; PT 283 Date 10/8/02
Pump Make: MYERS Model ME-505 Serial No. 10/02
Nitrification Field: No Fields 1 Square Feet 540 Linear Feet 270
No Lines 3@90' Trench Width 2' Max Trench Bottom Depth 3' Gravel Depth No

[X] New System [ ] Repair System Type: I, II, III, (IV), V, VI
System Description: PreDosed - 16" PPBPS
Repair System Description: SAME
Maintenance Agreement Required: [X] Yes [ ] No


[X] House/Mod. Home No. Bedrooms 4
[ ] Mobile Home No. Bathrooms 4.5
[ ] Business No. Employees
[ ] Other
[ ] Slab [ ] Crawl Space [X] Basement w/plumbing [ ] Basement wo/plumbing

Water Supply: [ ] Individual [ ] Public [X] Community


Comments:/Conditions:

Comments:/Conditions:

INITIAL SITE SKETCH (1" = 40')

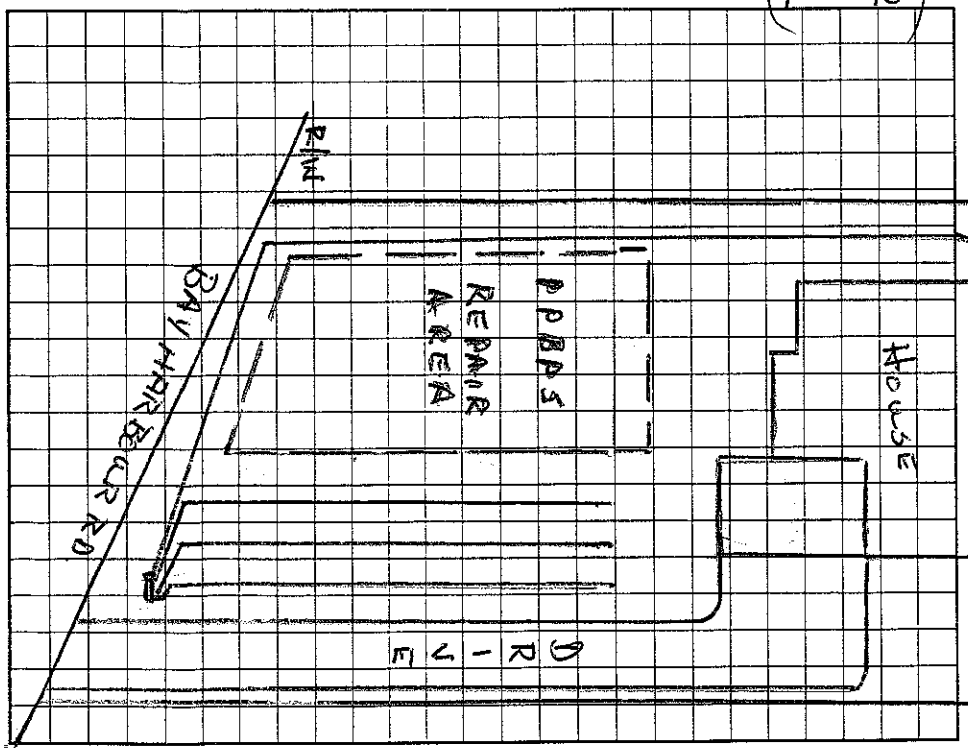

AS BUILT SKETCH

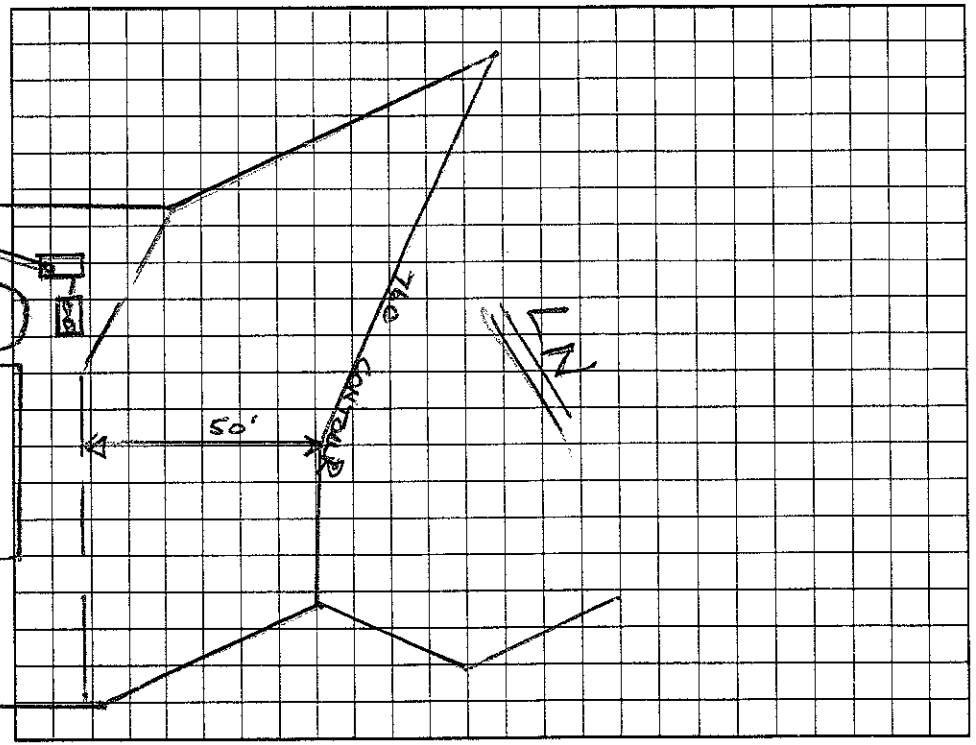

Permit can be suspended or revoked if any false information is supplied toward securing the permit/any unauthorized changes are made to the site/any unauthorized changes are made in the installation of the system. Improvement Permit with plat valid without expiration. Improvement Permit with site plan valid for sixty months. Authorization to Construct is valid for a period equal to that of Improvement Permit – not to exceed sixty months.

Signed: B [signature] date

Improvement Permit by: G McN. date

Authorization to Construct by: G McN. date 2/7/02

Installed by: R+N

Operation Permit by: Wesley Sparkes. date 1/27/03

Existing System Inspection by: date

HEALTH DEPT. COPY: WHITE OWNER COPY (FINAL): YELLOW OWNER COPY (INITIAL): PINK