# IREDELL COUNTY HEALTH DEPARTMENT

STATESVILLE 704-878-5305 50.00 Paid MOORESVILLE 704-664-5281 3.00-

## IMPROVEMENT PERMIT / AUTHORIZATION TO CONSTRUCT / OPERATION PERMIT / EXISTING SYSTEM INSPECTION

PERMIT# ~~2[illegible]~~ 104831 PIN# 4625-37-0994 DATE 2/7/02

OWNER OR CONTRACTOR The Hoke Co. / Jalal Montazeri PHONE: Business 704-799-7495 Home

ADDRESS PO Box 4448 Mooresville NC 28117

LOCATION Brawley Sch, TR Bay Harbour on Rt before Goosenack

SUBDIVISION Harbour BLOCK / SECTION 5 LOT 32 LOT AREA — SITE CLASS. PS DESIGN FLOW 480 L.T.A.R. 0.3

Septic Tank: 1000 Gallons; STB 794 Date 9-14-02
Pump Tank: 1000 Gallons; PT 283 Date 10-8-02
Pump Make: MYERS Model MEP 5 Serial No.
Nitrification Field: No Fields 1 Square Feet 810 Linear Feet 270
No Lines 30@90' Trench Width 24" or 36" Max Trench Bottom Depth 36" Gravel Depth —

☒ New System ☐ Repair System Type: I, II, III, IV, V, VI
System Description: LP Panel Block
Repair System Description: Same
Maintenance Agreement Required: ☒ Yes ☐ No

☒ House/Mod. Home ☐ Mobile Home ☐ Business ☐ Other
No. Bedrooms 4 No. Bathrooms 4.5 No. Employees


☐ Slab ☐ Crawl Space ☒ Basement w/plumbing ☐ Basement wo/plumbing

Water Supply: ☐ Individual ☐ Public ☒ Community


Comments:/Conditions:

Comments:/Conditions: 5/30" hole drilled
Checked tanks & lines 12/19/02 MO

INITIAL SITE SKETCH 1"=40'

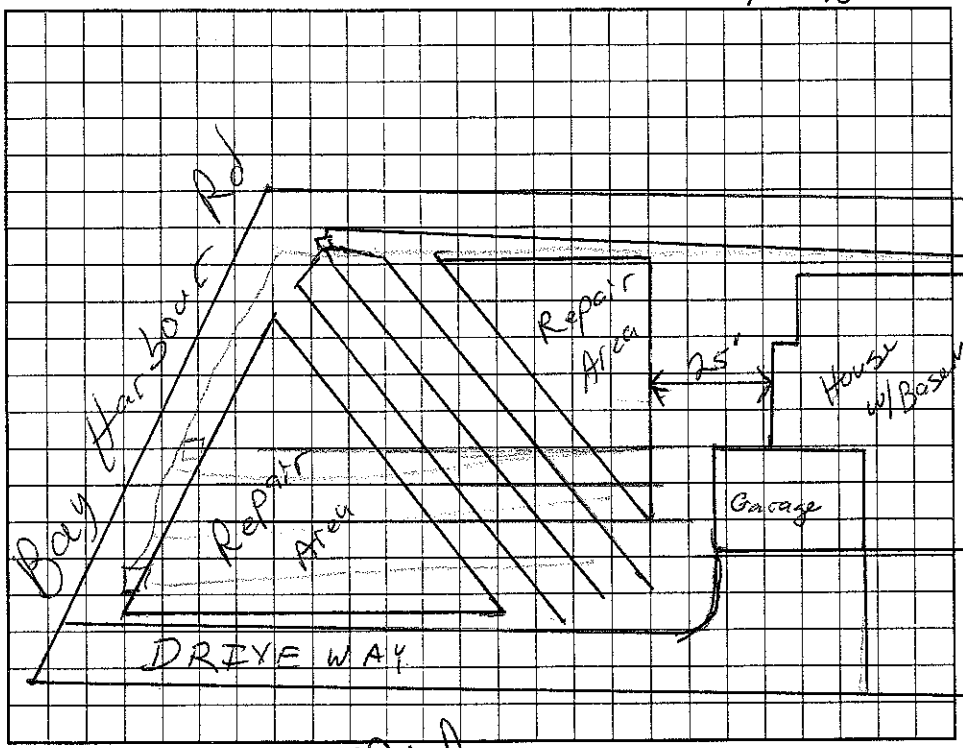


AS BUILT SKETCH

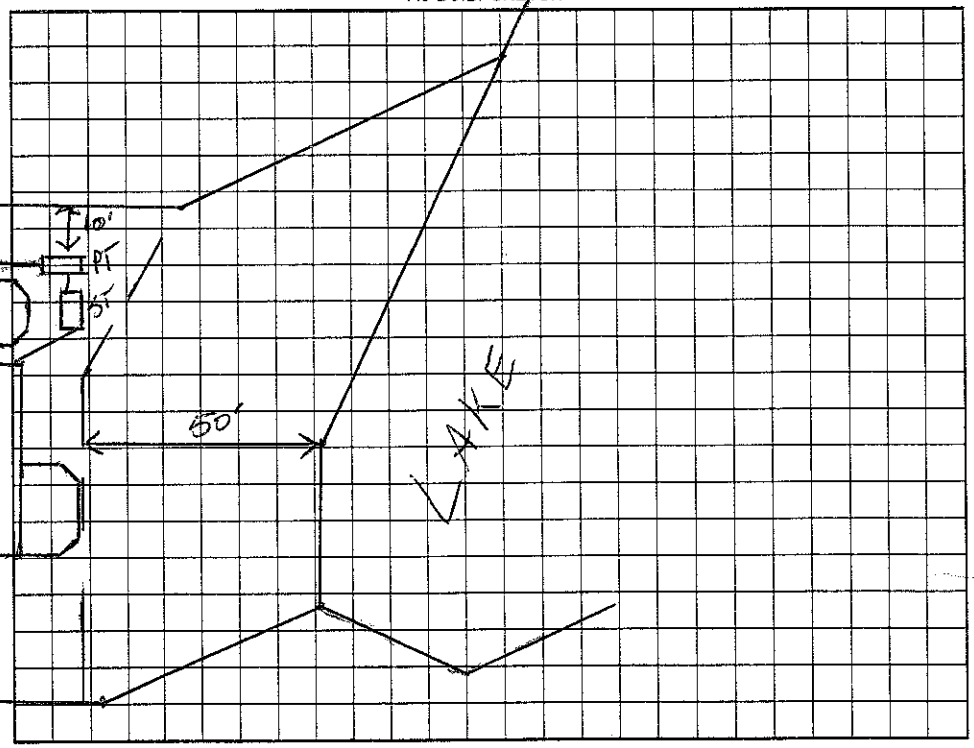


Permit can be suspended or revoked if any false information is supplied toward securing the permit/any unauthorized changes are made to the site/any unauthorized changes are made in the installation of the system. Improvement Permit with plat valid without expiration. Improvement Permit with site plan valid for sixty months. Authorization to Construct is valid for a period equal to that of Improvement Permit – not to exceed sixty months.

Signed: [signature] date 2/7/02 Installed by: R & H Inc.

Improvement Permit by: [signature] RS date 2/7/02 Operation Permit by: date

Authorization to Construct by: [signature] RS date 2/7/02 Existing System Inspection by: date

HEALTH DEPT. COPY: WHITE OWNER COPY (FINAL): YELLOW OWNER COPY (INITIAL): PINK