IREDELL COUNTY HEALTH DEPARTMENT

STATESVILLE 704-878-5305 MOORESVILLE 704-664-5281

IMPROVEMENT PERMIT / AUTHORIZATION TO CONSTRUCT / OPERATION PERMIT / EXISTING SYSTEM INSPECTION

126408

PERMIT# 24369 / 126408 PIN# 4625-37-2766 DATE 10/25/04

OWNER OR CONTRACTOR Jim Wilson PHONE: Business 704 737-1474 Home 704 663-3540

ADDRESS 107 Harbor Shore Ct Mooresville NC 28117

LOCATION BSR, TR Bay Harbour, on Lt Just before Causeway

SUBDIVISION Harbour BLOCK / SECTION 5 LOT 18/18A LOT AREA 37,383 Ft² SITE CLASS. PS DESIGN FLOW 600 L.T.A.R. 0.3

Septic Tank: 1500 Gallons; STB 339 Date 12/6/05

Pump Tank: 1500 Gallons; PT 427 Date 12/18/05

Pump Make: Goulds Model WS05 511 H Serial No.

Nitrification Field: No Fields 1 Square Feet 999 Linear Feet 333

No Lines 6 Trench Width 24" Max Trench Bottom Depth 36" Gravel Depth —

☒ New System ☐ Repair System Type: I, II, III, IV, V, VI

System Description: LP Panel Block

Repair System Description: Same - offsite

Maintenance Agreement Required: ☒ Yes ☐ No

☒ House/Mod. Home No. Bedrooms 5

☐ Mobile Home No. Bathrooms

☐ Business No. Employees

☐ Other


☐ Slab ☐ Crawl Space ☒ Basement w/plumbing ☐ Basement wo/plumbing

Water Supply: ☐ Individual ☐ Public ☐ Community

Comments:/Conditions:

Comments:/Conditions:

INITIAL SITE SKETCH

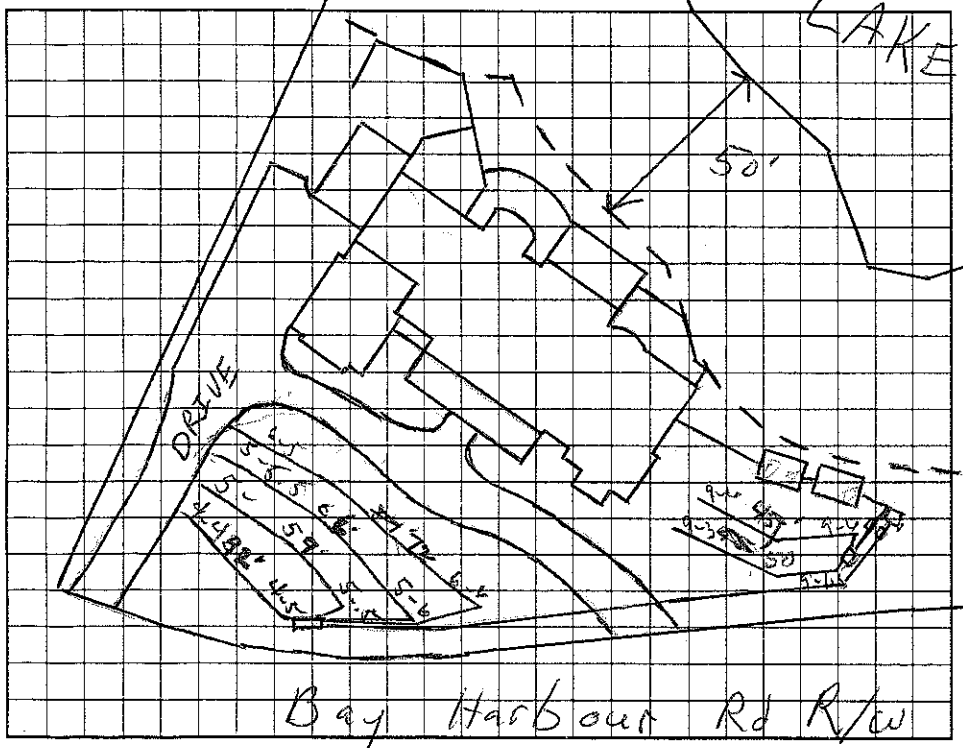

AS BUILT SKETCH

Permit can be suspended or revoked if any false information is supplied toward securing the permit/any unauthorized changes are made to the site/any unauthorized changes are made in the installation of the system. Improvement Permit with plat valid without expiration. Improvement Permit with site plan valid for sixty months. Authorization to Construct is valid for a period equal to that of Improvement Permit – not to exceed sixty months.

Signed: Jim Wilson date 10-25-04 Installed by: Dobson & Sons

Improvement Permit by: RS date 10/25/04 Operation Permit by: Wendy Sparks R.S. date 4/20/06

Authorization to Construct by: RS date 10/25/04 Existing System Inspection by: date

HEALTH DEPT. COPY: WHITE OWNER COPY (FINAL): YELLOW OWNER COPY (INITIAL): PINK