IREDELL COUNTY HEALTH DEPARTMENT Coast. Auth. STATESVILLE 704-878-5305 MOORESVILLE 704-664-5281

IMPROVEMENT PERMIT / ~~CERTIFICATE OF COMPLETION~~ / OPERATION PERMIT / EXISTING SYSTEM INSPECTION

PROPERTY DESCRIPTION NO. 24368 DATE Aug 15, '96 TAX MAP NO. part of 2643 4625-37-3989 Watershed: ☑ Yes ☐ No

OWNER OR CONTRACTOR Crescent Resources Inc. / Tom Stevenson & PHONE: Business _____ Home _____

ADDRESS 40 Box 1003, Charlotte, NC

LOCATION Brawley School RD. TR Bay Harbour on left past Island Cove Ln

SUBDIVISION The Harbours BLOCK / SECTION 5 LOT 16 LOT AREA 25,055 sq ft SITE CLASS. I Spec 136 DESIGN FLOW 460 gpd L.T.A.R. na3

Septic Tank: 1000 Gallons; STB 594 Date 10/24/97

Pump Tank: 1000 Gallons; PT 27 Date 3/13/98

Pump Make: Zoeller Model WE0511N Serial No. M9728411

Nitrification Field: No Fields 1 Square Feet 540 Linear Feet 270

No Lines 3 Trench Width 24" Max Trench Bottom Depth 2'30" Gravel Depth N/A

☑ New System ☐ Repair System Type: I, II, III, IV, V, VI

System Description: LPP Rigid Block

Repair System Description: LPP Rigid Block

Maintenance Agreement Required: ☑ Yes ☐ No

☑ House/Mod. Home No. Bedrooms 4/4

☐ Mobile Home No. Bathrooms

☐ Business No. Employees

☐ Other

☐ Slab ☑ Crawl Space ☑ Basement w/plumbing ☐ Basement wo/plumbing


Water Supply: ☐ Individual ☐ Community ~~☑ Public~~

Comments: 3/13/98 Home 10' longer (70') than shown on sketch. Orient tanks side by side touching each other and parallel to property line and 5' off old-formed lot line OK

Comments: partial

1"=50'

INITIAL SITE SKETCH

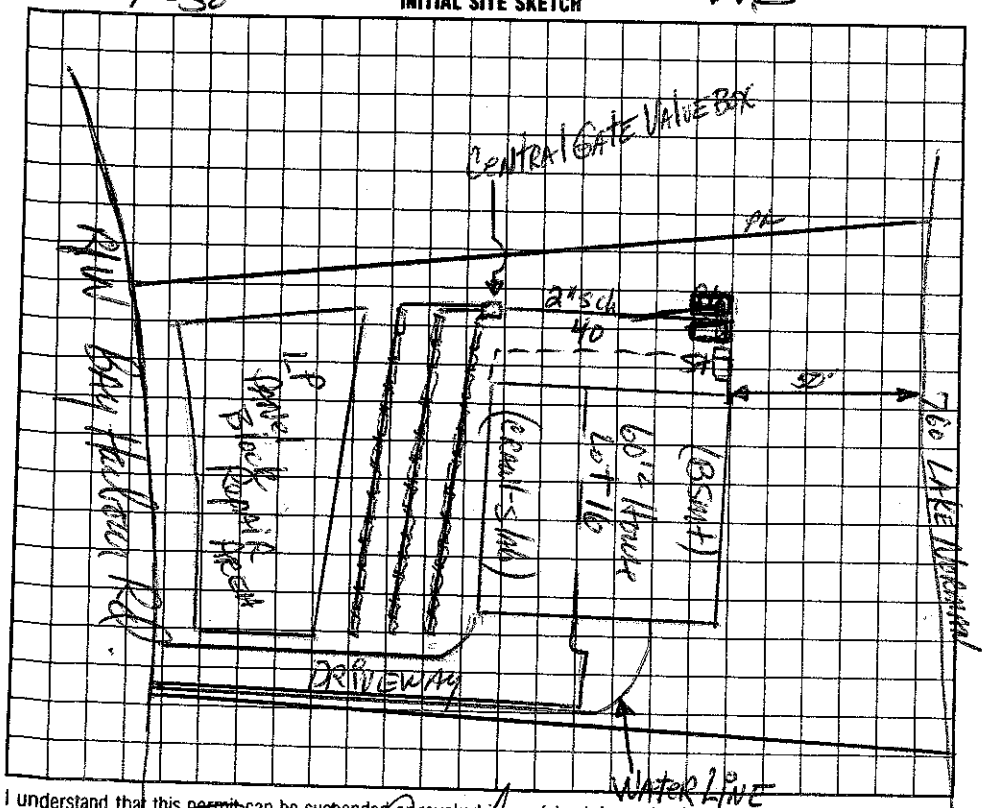

AS BUILT SKETCH

I understand that this permit can be suspended or revoked if any false information is supplied toward securing the permit/any unauthorized changes are made to the site/any unauthorized changes are made in the installation of the system.

Signed: _____ Agent

Improvement Permit by: _____, RS date 8-15-96

~~Construction Site Inspection by:~~ _____, RS date 3/13/98

Authorization

Installed by: Chris Hedrick

Certificate of Completion by: Wesley Sparks RS. date 5/13/98

Operation Permit by: Wesley Sparks RS date 5/13/98

HEALTH DEPT. COPY: WHITE INSPECTION COPY (FINAL): GREEN OWNER COPY (FINAL): YELLOW INSPECTION COPY (INITIAL): PINK OWNER COPY (INITIAL): GOLD