IREDELL COUNTY HEALTH DEPARTMENT

$ 550

STATESVILLE 704-878-5305 MOORESVILLE 704-664-5281

IMPROVEMENT PERMIT / AUTHORIZATION TO CONSTRUCT / OPERATION PERMIT / EXISTING SYSTEM INSPECTION

PERMIT# 13472 PIN# 4625382849

OWNER OR APPLICANT Bill Whitley DATE 4-11-06

ADDRESS 106 Lightship Dr. Mooresville 28117 PHONE: Business 704-567-1700 Home

LOCATION Brawley School Rd. TR Bay Harbour Lot 10 on left TR shipyard to lot 10A (across from Sanibel)

SUBDIVISION The Harbour BLOCK / SECTION 5 LOT 10/10A LOT AREA SITE CLASS. DESIGN FLOW L.T.A.R.

Septic Tank: 1000 Gallons; STB 317 Date 11/13/06

Pump Tank: 1000 Gallons; PT 393 Date 11/22/06

Pump Make: Lowes Model WEO-712 HU Serial No. 12/06

Nitrification Field: No Fields 1 Square Feet Linear Feet 400

No Lines 4@100' Trench Width 36" Max Trench Bottom Depth 36" Gravel Depth NA

☒ New System ☐ Repair ☐ Expansion System Type: I II (III) IV V VI

System Description: 25% reduction pump pm

Repair System Description: LP Panel

Maintenance Agreement Required: ☐ Yes ☒ No

☒ House/Mod. Home ☐ Mobile Home ☐ Business ☐ Other

No. Bedrooms 4 No. Persons No. Employees

Water Supply: ☐ Individual ☐ Public ☒ Community


☐ Gravity ☒ Pressure ☐ Slab ☐ Crawl Space ☐ Basement w/plumbing ☒ Basement wo/plumbing

Comments:/Conditions:


Comments:/Conditions:

1" = 50'

Lot 11A INITIAL SITE SKETCH

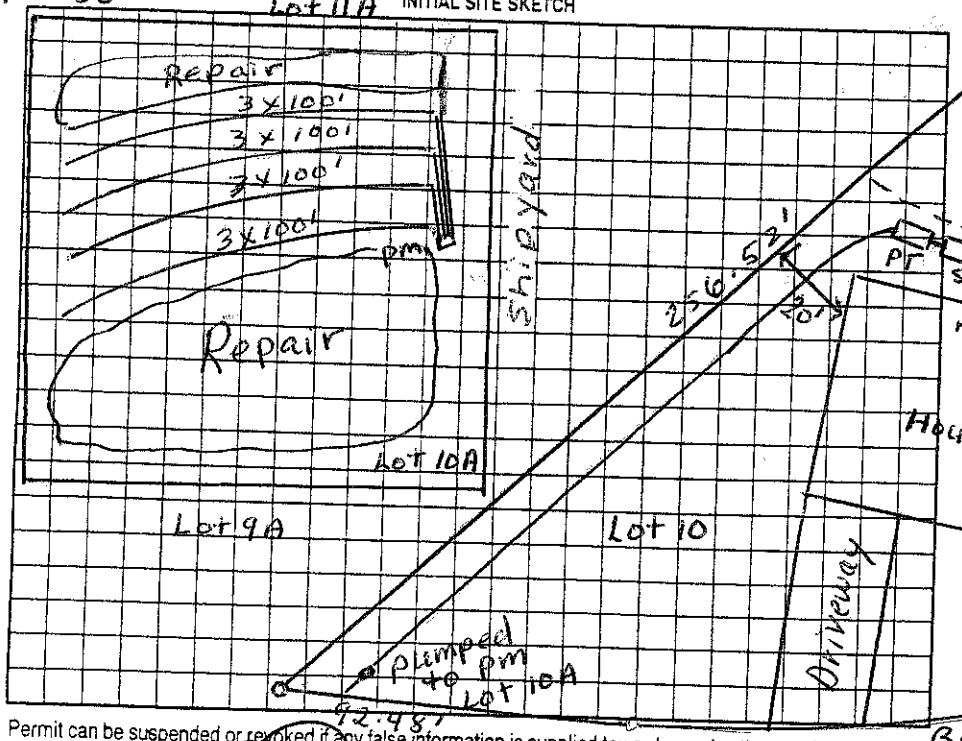

AS BUILT SKETCH

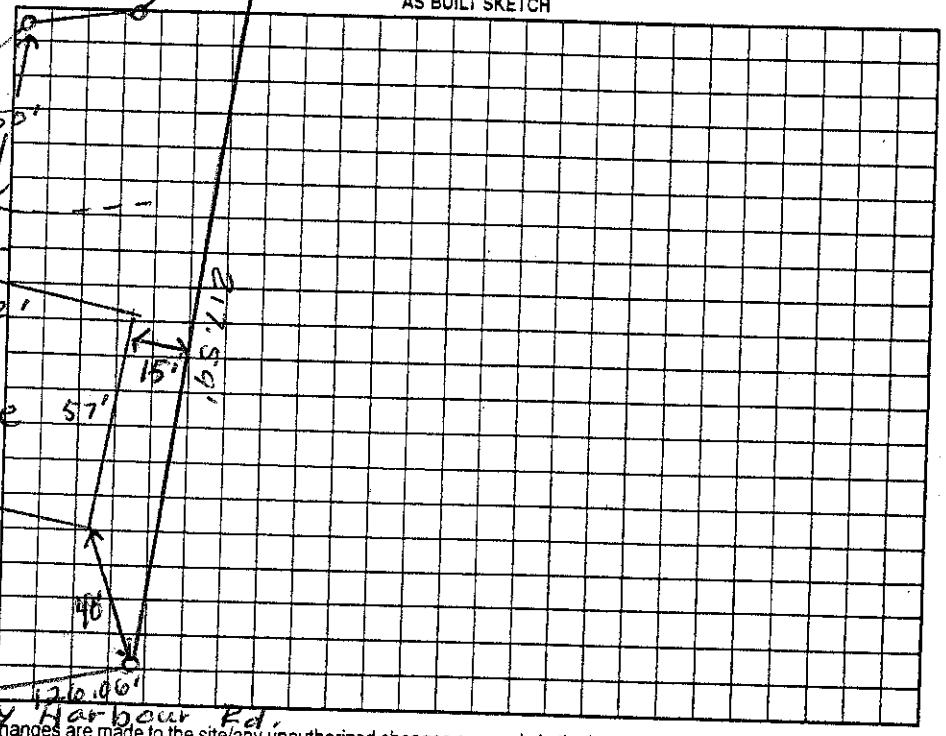

Permit can be suspended or revoked if any false information is supplied toward securing the permit/any unauthorized changes are made to the site/any unauthorized changes are made in the installation of the system. Improvement Permit with plat valid without expiration ☐ Improvement Permit with site plan valid for sixty months ☒ Authorization to Construct is valid for a period equal to that of Improvement Permit – not to exceed sixty months.

Signed: WC date 4/17/6 Installed by: Curtis Cummings

Improvement Permit by: Judy Melville date 4-11-06 Operation Permit by: Josh E' Allen date 4-13-07

Authorization to Construct by: Judy Melville date 4-11-06 Existing System Inspection by: date

HEALTH DEPT. COPY: WHITE OWNER COPY (FINAL): YELLOW OWNER COPY (INITIAL): PINK