IREDELL COUNTY HEALTH DEPARTMENT Const Auth STATESVILLE 704-878-5305 MOORESVILLE [illegible]34-5281

IMPROVEMENT PERMIT / ~~CERTIFICATE OF COMPLETION~~ / OPERATION PERMIT / EXISTING SYSTEM INSPECTION

PROPERTY DESCRIPTION NO. 24363 DATE Aug 14, 96 TAX MAP NO. part of 2CA3 4625-38-3506 Watershed: ☑ Yes ☐ No

OWNER OR CONTRACTOR Crescent Resources clo ABJ Const. PHONE: Business _____ Home _____

ADDRESS PO Box 1003 Charlotte ED & Diane KRAUSE

LOCATION Brawley Sch Rd. TR Bay Harbour on left past Island Cove Ln.

SUBDIVISION The Harbour BLOCK / SECTION 5 LOT 12 LOT AREA 45,969 SITE CLASS. B pan 1956 DESIGN FLOW 480 gpd L.T.A.R. .3

Septic Tank: 1000 Gallons; STB 794 Date 11/22/00
Pump Tank: 1000 Gallons; PT 29 Date 11/15/00
Pump Make: Gould Model WE6-511H Serial No. K0030564
Nitrification Field: No Fields 1 Square Feet 540 Linear Feet 270
No Lines 4 Trench Width 24" Max Trench Bottom Depth ≈ 30" Gravel Depth N/A

☑ New System ☐ Repair System Type: I, II, III, IV, V, VI
System Description: LP panel block
Repair System Description: Same
Maintenance Agreement Required: ☑ Yes ☐ No

☑ House/Mod. Home ☐ Mobile Home ☐ Business ☐ Other
No. Bedrooms 4/4 No. Bathrooms 4 No. Employees ____

☐ Slab ☑ Crawl Space ☑ Basement w/plumbing ☐ Basement wo/plumbing


Water Supply: ☐ Individual ☐ Community ☑ Public

Comments:
Jan 4, 2000 plan reviewed appears substantially in compliance w/IP DHA

Comments: partial

1" = 50'

INITIAL SITE SKETCH

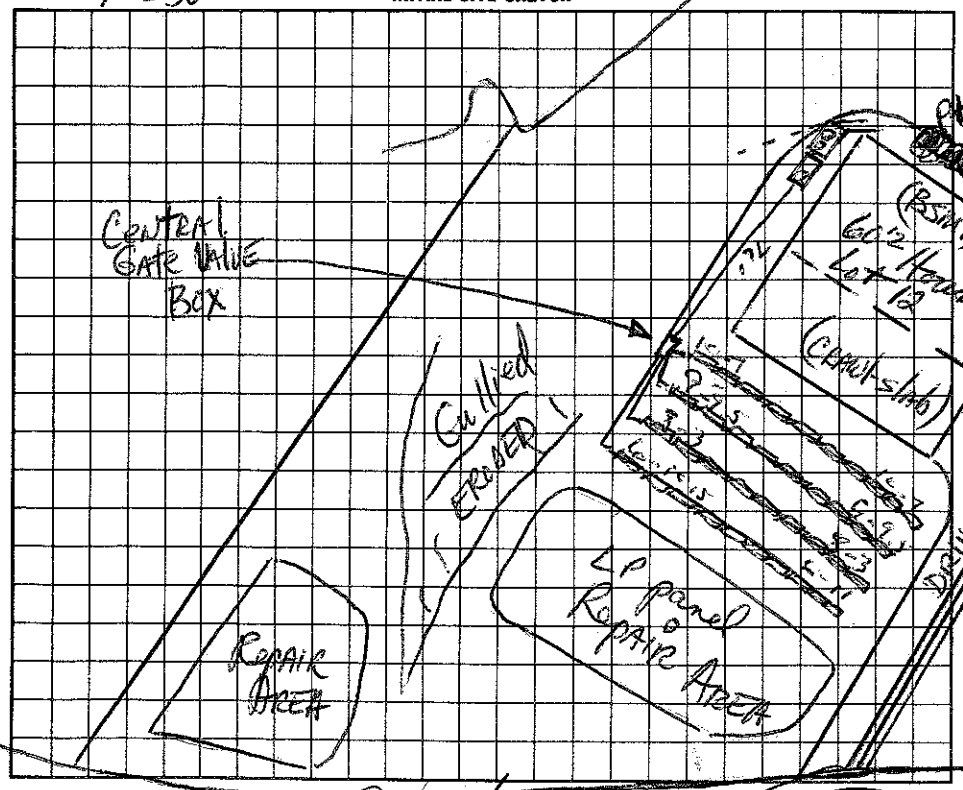

AS BUILT SKETCH

I understand that this permit can be suspended or revoked if any false information is supplied toward securing the permit/any unauthorized changes are made to the site/any unauthorized changes are made in the installation of the system.

Signed: _____

Improvement Permit by: _____ date 8-14-96

~~Existing System Inspection~~ Construction Authorization by: _____ date Jan 4 2000

Installed by: F J Erwin

Certificate of Completion by: Wesley Sparks RS. date 5/8/01

Operation Permit by: _____ date _____

HEALTH DEPT. COPY: WHITE INSPECTION COPY (FINAL): GREEN OWNER COPY (FINAL): YELLOW INSPECTION COPY (INITIAL): PINK OWNER COPY (INITIAL): GOLD