IREDELL COUNTY HEALTH DEPARTMENT

Const. Auth. STATESVILLE 704-878-5305 MOORESVILLE 704-664-5281

IMPROVEMENT PERMIT / ~~CERTIFICATE OF COMPLETION~~ / OPERATION PERMIT / EXISTING SYSTEM INSPECTION

PROPERTY DESCRIPTION NO. 24360 DATE Sept 5, '96 TAX MAP NO. part of 2CA3 4625 38 3954 Watershed: ☑ Yes ☐ No

OWNER OR CONTRACTOR ~~Crescent Resources Inc~~ GRIFFIN CONST CO PHONE: Business _____ Home _____

ADDRESS PO Box 1003, Charlotte

LOCATION Brawley Sch Rd. TR Bay Harbour on left @ Island Cove Ln.

SUBDIVISION The Harbour BLOCK / SECTION 5 LOT 9 LOT AREA ~33,000ft² + 14,400 SITE CLASS. BSpt. 1956 DESIGN FLOW 480gpd L.T.A.R. ~.3

Septic Tank: 1000 Gallons; STB 994 Date 5/21/98

Pump Tank: 1000 Gallons; PT 27 Date 6/10/98

Pump Make: Goulds Model WE1NBH Serial No. K96429/2

Nitrification Field: No Fields 1 Square Feet 1200 Linear Feet 400

No Lines 4@100' Trench Width 36" Max Trench Bottom Depth ~30" Gravel Depth N/A

☑ New System ☐ Repair System Type: I, II, (III), IV, V, VI

System Description: pumped pre-chambered (9A)

Repair System Description: LP Panel BK on 9A

Maintenance Agreement Required: ☐ Yes ☑ No

☑ House/Mod. Home No. Bedrooms 4

☐ Mobile Home No. Bathrooms 4

☐ Business No. Employees _____

☐ Other _____


☐ Slab ☐ Crawl Space ☑ Basement w/plumbing ☐ Basement wo/plumbing

Water Supply:
☐ Individual
☐ Community
☑ Public


Comments:

Comments: 1996 Base 8-8.5" DRAWDOWN

INITIAL SITE SKETCH

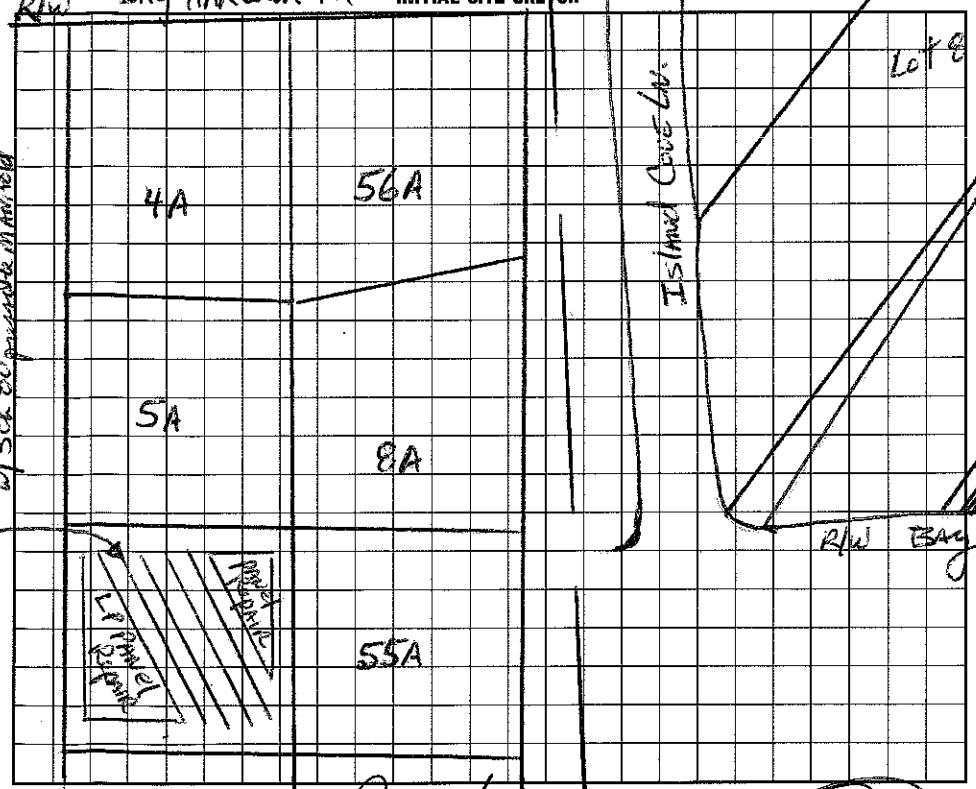

AS BUILT SKETCH

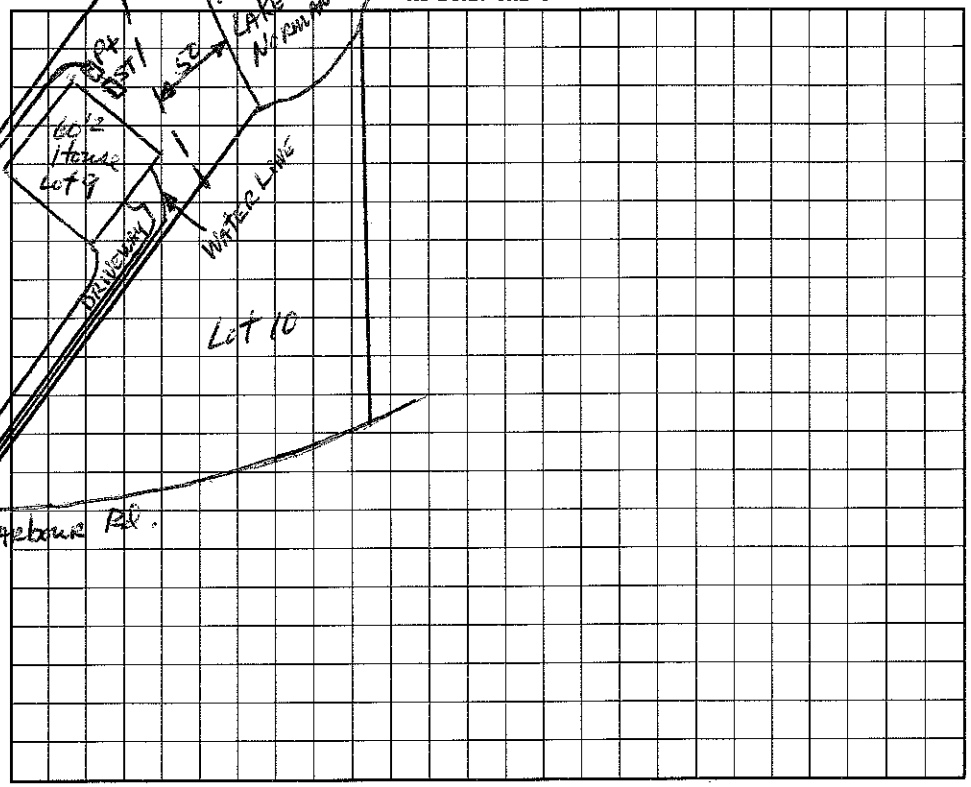

I understand that this permit can be suspended or revoked if any false information is supplied toward securing the permit/any unauthorized changes are made to the site/any unauthorized changes are made in the installation of the system.

Signed: _____

Improvement Permit by: _____ date 9-5-96

~~Existing System Inspection~~ CONSTRUCTION AUTHORIZATION by: _____ date 12/12/97

Installed by: FJ Erwin

Certificate of Completion by: _____ date _____

Operation Permit by: _____ date 9/16/98

HEALTH DEPT. COPY: WHITE INSPECTION COPY (FINAL): GREEN OWNER COPY (FINAL): YELLOW INSPECTION COPY (INITIAL): PINK OWNER COPY (INITIAL): GOLD