IREDELL COUNTY HEALTH DEPARTMENT

STATESVILLE 704-878-5305 MOORESVILLE 704-664-5281

IMPROVEMENT PERMIT / AUTHORIZATION TO CONSTRUCT / OPERATION PERMIT / EXISTING SYSTEM INSPECTION

PERMIT# 24365 PIN# 4625-38-4286 DATE 4/19/01

OWNER OR CONTRACTOR Glen Lindemann PHONE: Business Home 440-519-1723

ADDRESS 7390 Hillside Ln. Solon OH. 44139

LOCATION Bay Harbour Rd. 1100 TR Bay Harbour on (L) first island Cove Ln.

SUBDIVISION HARBOUR BLOCK / SECTION 5 LOT 14 LOT AREA 27,127 FT² SITE CLASS. PS DESIGN FLOW 480 L.T.A.R. .3

Septic Tank: 1000 Gallons; STB 794 Date 2/1/02
Pump Tank: 1000 Gallons; PT 27 Date 3/3/02
Pump Make: MYERS Model WE-50 Serial No.
Nitrification Field: No Fields 1 Square Feet 540 Linear Feet 270
No Lines 4@67' Trench Width 2' Max Trench Bottom Depth 30" Gravel Depth No

[X] New System [ ] Repair System Type: I, II, III, (IV), V, VI
System Description: LP - 16" PPBRS
Repair System Description: SAME
Maintenance Agreement Required: [X] Yes [ ] No

[X] House/Mod. Home No. Bedrooms 4
[ ] Mobile Home No. Bathrooms 4
[ ] Business No. Employees
[ ] Other


[ ] Slab [ ] Crawl Space [X] Basement w/plumbing [ ] Basement wo/plumbing

Water Supply: [ ] Individual [ ] Public [X] Community


Comments:/Conditions: MAINTENANCE CONTRACT REQUIRED

Comments:/Conditions: 5 lines - 39, 49, 50, 60, 70 = 293
5B/52 Panels with Hood & Tanks - Pressure - 5" Lateral = 7.5 Headers.

INITIAL SITE SKETCH (1" = 50')

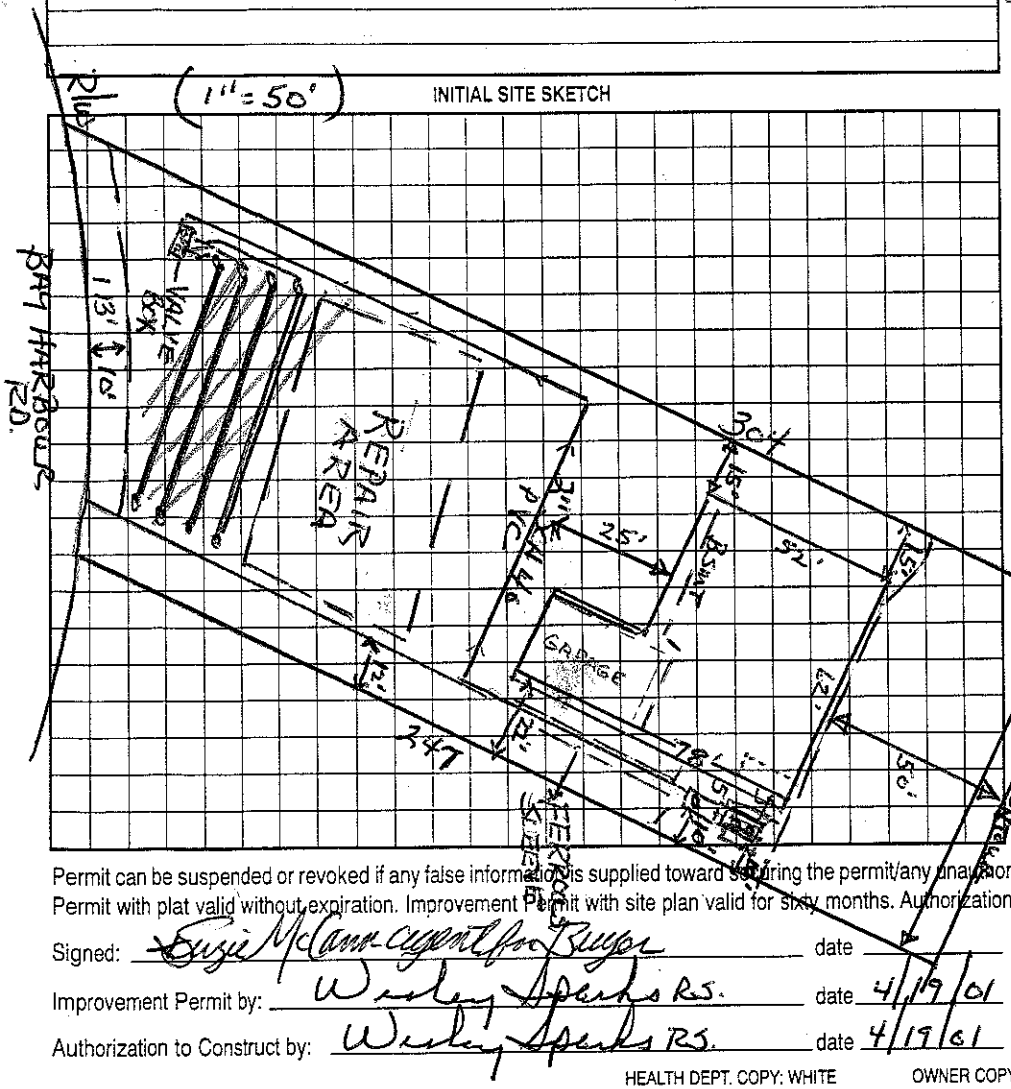

AS BUILT SKETCH

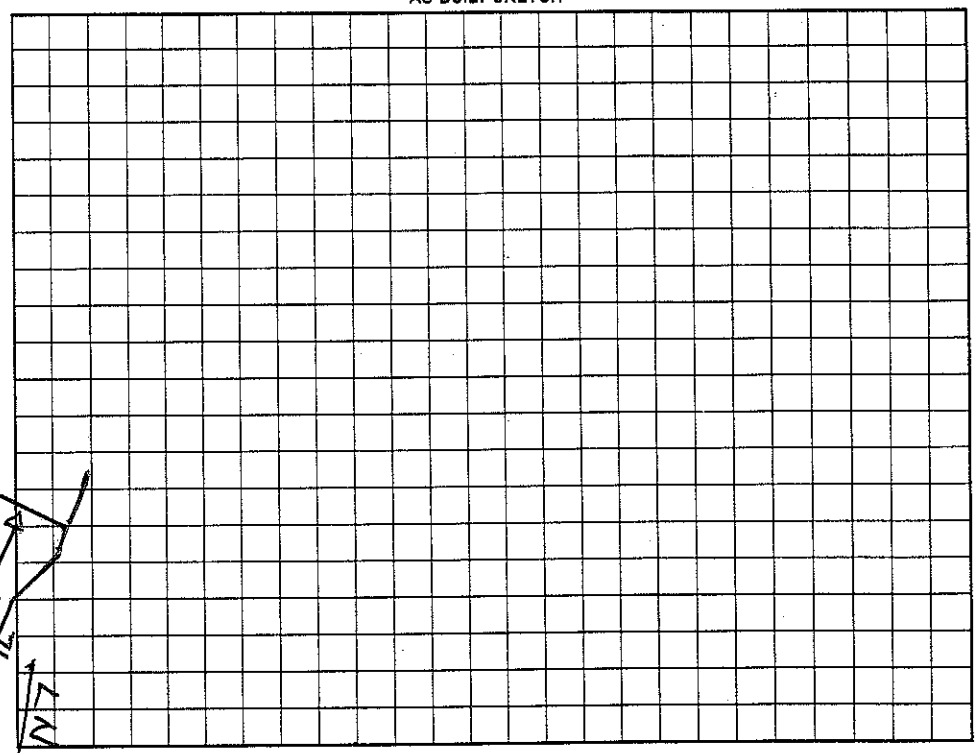

Permit can be suspended or revoked if any false information is supplied toward securing the permit/any unauthorized changes are made to the site/any unauthorized changes are made in the installation of the system. Improvement Permit with plat valid without expiration. Improvement Permit with site plan valid for sixty months. Authorization to Construct is valid for a period equal to that of Improvement Permit – not to exceed sixty months.

Signed: ~~Suzie McCann~~ Suzie McCann-agent for Buyer date

Improvement Permit by: Wesley Sparks RS. date 4/19/01

Authorization to Construct by: Wesley Sparks RS. date 4/19/01

Installed by: Grant Dunning

Operation Permit by: [signature] RS date 6/4/02

Existing System Inspection by: date

HEALTH DEPT. COPY: WHITE OWNER COPY (FINAL): YELLOW OWNER COPY (INITIAL): PINK