REDELL COUNTY HEALTH DEPARTMENT

STATESVILLE 704-878-5305 MOORESVILLE 704-664-5281

IMPROVEMENT PERMIT / AUTHORIZATION TO CONSTRUCT / OPERATION PERMIT / EXISTING SYSTEM INSPECTION

375,00 Tyler

PERMIT# 109937 PIN# 4625385872 Ron DATE 11-22-2002

OWNER OR CONTRACTOR Stonegate Luxury Homes PHONE: Business 400-1235 Home

ADDRESS P.O. Box 1597 Cornelius, NC 28031 (114 ISLAND COVE LN)

LOCATION Brawley School Rd TR Bay Harbour TR Island Cove Ln on Rt.

SUBDIVISION Harbour BLOCK / SECTION 5 LOT 7 LOT AREA SITE CLASS. PS DESIGN FLOW 480 gpd L.T.A.R. .3

Septic Tank: ~~1000~~ 1500 Gallons; STB 338 Date 10-6-03

Pump Tank: ~~1000~~ 1500 Gallons; PT 338 Date 7-28-03

Pump Make: Gould's Model WE0712 HC Serial No. F0348813

Nitrification Field: No Fields 1 Square Feet 840' Linear Feet 280'

No Lines 4@70' Trench Width 36"-24" Max Trench Bottom Depth 30" Gravel Depth 1/4

☒ New System ☐ Repair System Type: I II III IV V VI

System Description: Pump-LP- Panel Block

Repair System Description: Same

Maintenance Agreement Required: ☒ Yes ☐ No

☒ House/Mod. Home No. Bedrooms 4

☐ Mobile Home No. Bathrooms 4.5

☐ Business No. Employees

☐ Other

☐ Slab ☐ Crawl Space ☒ Basement w/plumbing ☐ Basement wo/plumbing

Water Supply: ☐ Individual ☒ Public ☐ Community


Comments:/Conditions: Keep Septic System at least 10' from PL a 50' from lake.

(5@56'x2') (5/32)


Comments:/Conditions: * Use In line filter in PT.

** Keep waterline at least 10' from Septic System. Preheal tanks 9/9/03

Scale 1:50 INITIAL SITE SKETCH

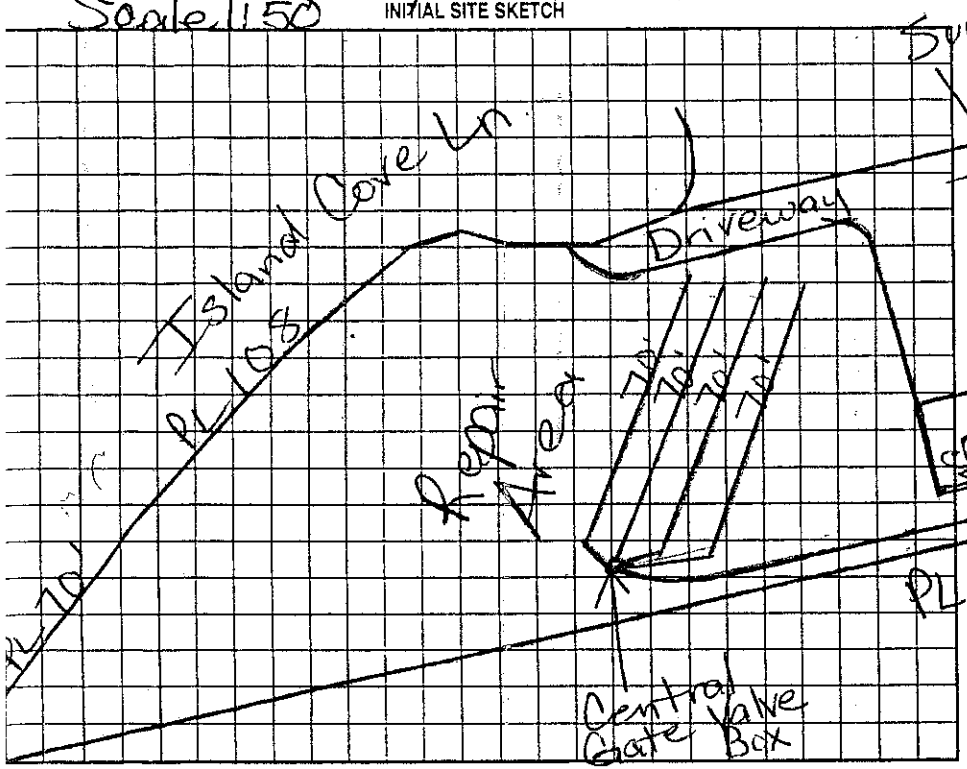

AS BUILT SKETCH TYPE 4

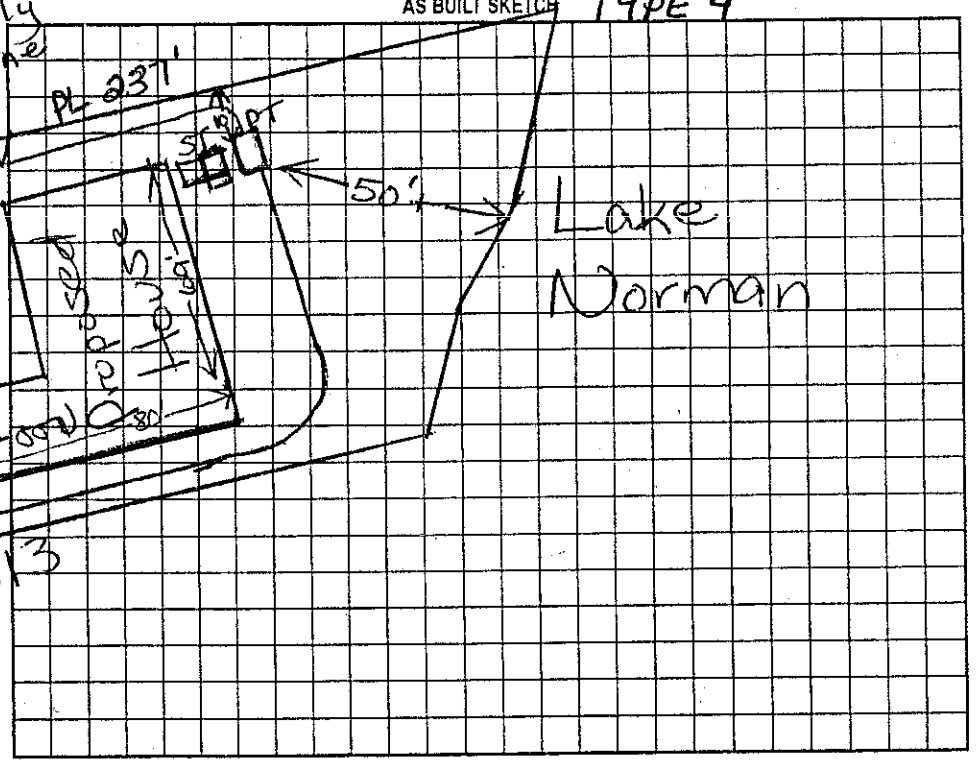

Permit can be suspended or revoked if any false information is supplied toward securing the permit/any unauthorized changes are made to the site/any unauthorized changes are made in the installation of the system. Improvement Permit with plat valid without expiration. Improvement Permit with site plan valid for sixty months. Authorization to Construct is valid for a period equal to that of Improvement Permit – not to exceed sixty months.

Signed: date 12-1-02 Installed by: Steve Jordon

Improvement Permit by: Maria H. Dotson RS date 11/22/2002 Operation Permit by: Wesley Sparks RS. date 10/31/03

Authorization to Construct by: Maria H. Dotson RS date 11/22/2002 Existing System Inspection by: date

HEALTH DEPT. COPY: WHITE OWNER COPY (FINAL): YELLOW OWNER COPY (INITIAL): PINK