IREDELL COUNTY HEALTH DEPARTMENT

STATESVILLE 704-878-5305 50.00 Paid MOORESVILLE 704-664-5281

IMPROVEMENT PERMIT / AUTHORIZATION TO CONSTRUCT / OPERATION PERMIT / EXISTING SYSTEM INSPECTION

PERMIT# 24357 / 24358 / 24354 PIN# part of 2CA3 4625-38-8726 DATE 9/20/2001

OWNER OR CONTRACTOR CRI / Jimmy & Prissy Johnson PHONE: Business 309-6101 Home

ADDRESS 112 Carsons Place Mooresville, NC 28117

LOCATION Brawley School Rd TR Bay Harbour TL Island Cove at end

SUBDIVISION The Harbour BLOCK / SECTION 5 LOT 5&6 LOT AREA SITE CLASS. PS DESIGN FLOW 720 gpd L.T.A.R. .3

Septic Tank: 1500 Gallons: STB 312 Date 9-26-00
Pump Tank: 1500 Gallons: PT 27 Date 1-23-01
Pump Make: Goulds Model WE.20124 Serial No. 5029863 01
Nitrification Field: No Fields 1 Square Feet 1200' Linear Feet 460'
No Lines 5 @ 80' Trench Width 24-36" Max Trench Bottom Depth 30" Gravel Depth

X New System ☐ Repair System Type: I, II, III, IV, V, VI
System Description: Offsite Pump-LP-Panel Blk STE 54
Repair System Description: Pump-LP Panel Blk
Maintenance Agreement Required: X Yes ☐ No


X House/Mod. Home ☐ Mobile Home ☐ Business ☐ Other
No. Bedrooms 6 No. Bathrooms 6.5 No. Employees
☐ Slab ☐ Crawl Space X Basement w/plumbing ☐ Basement wo/plumbing

Water Supply: ☐ Individual X Public X Community


Comments:/Conditions: Keep Septic System at least 10' from PL & 50' from lake. Okay to do in 4@80' lines if it fits

Comments:/Conditions: Use 5/32a" hole, 3' Pres. head lines Checked

INITIAL SITE SKETCH

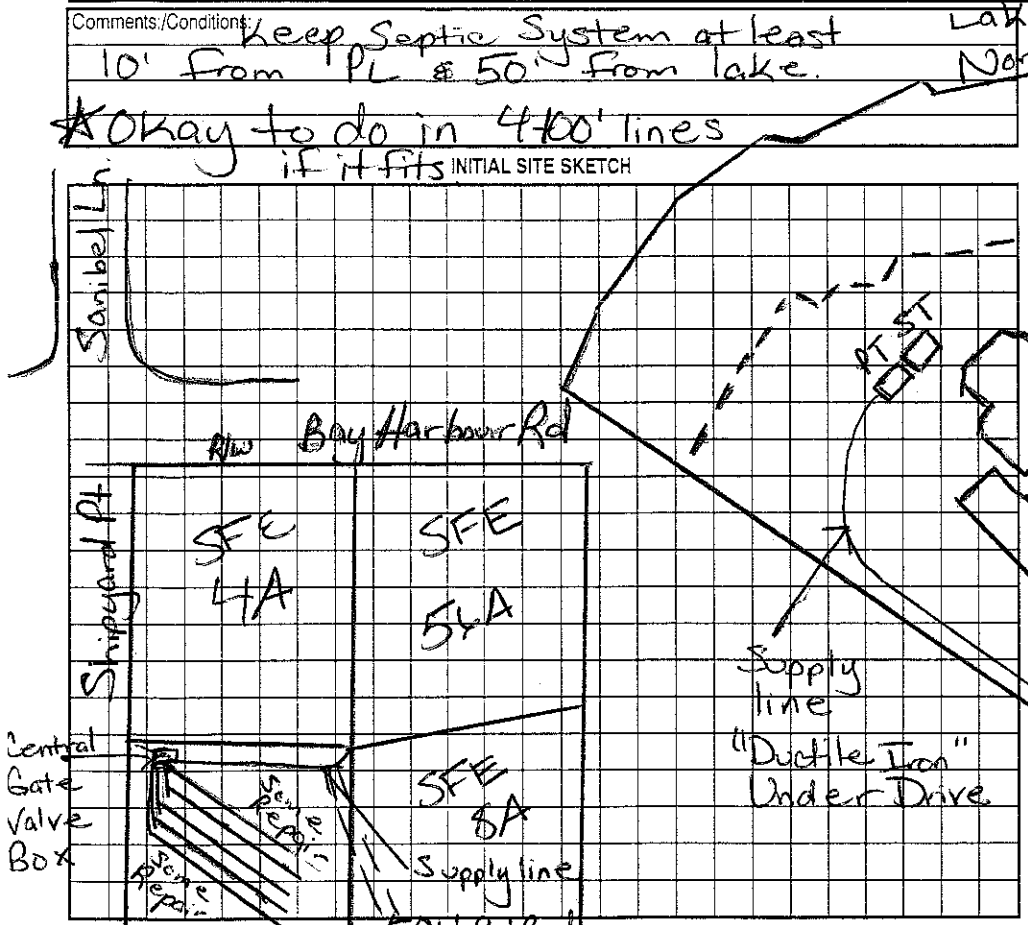

AS BUILT ~~SKETCH~~ Scale 1:60'

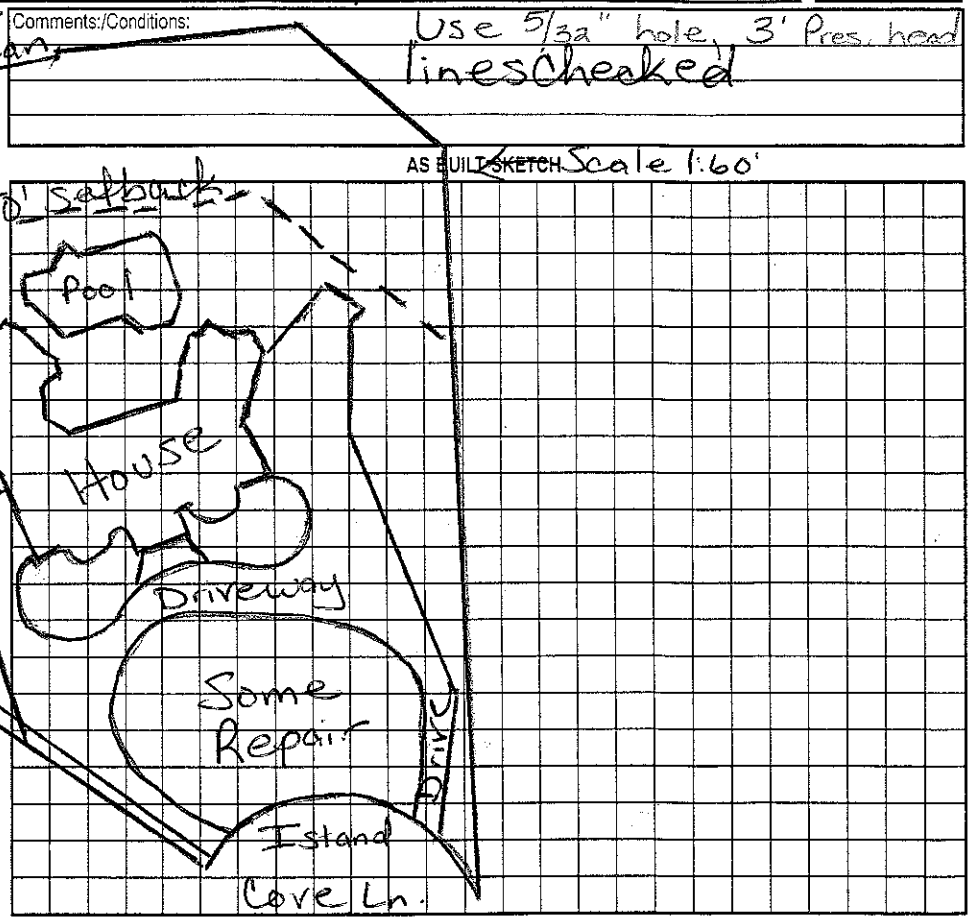

Permit can be suspended or revoked if any false information is supplied toward securing the permit/any unauthorized changes are made to the site/any unauthorized changes are made in the installation of the system. Improvement Permit with plat valid without expiration. Improvement Permit with site plan valid for sixty months. Authorization to Construct is valid for a period equal to that of Improvement Permit – not to exceed sixty months.

Signed: [signature] date 9/25/01

Improvement Permit by: Maria H. Dotson RS date

Authorization to Construct by: Maria H. Dotson RS date

Installed by: Larry Hinkle

Operation Permit by: Maria Dotson RS date 10/26/2001

Existing System Inspection by: date

HEALTH DEPT. COPY: WHITE OWNER COPY (FINAL): YELLOW OWNER COPY (INITIAL): PINK