(9.30 - 10.00)

IREDELL COUNTY HEALTH DEPARTMENT Const. Auth. STATESVILLE 704-878-5305 MOORESVILLE 704-664-5281

IMPROVEMENT PERMIT / ~~CERTIFICATE OF COMPLETION~~ / OPERATION PERMIT / EXISTING SYSTEM INSPECTION

PROPERTY DESCRIPTION NO. 24356 - 79187 DATE Sept. 4, 96 TAX MAP NO. part of 2CA3 Watershed: ☑ ~~Yes~~ ☐ No

OWNER OR CONTRACTOR Crescent Resources elec // Chuck & Sandra Helton PHONE: Business _____ Home _____

ADDRESS PO Box 1003, Charlotte

LOCATION Brawley Sch Rd. TR Bay Harbour TL Island Cove Ln. at end

SUBDIVISION The Harbour BLOCK / SECTION 5 LOT 4 LOT AREA ~27,000ft² + 17,000 SITE CLASS. PS per 1996 DESIGN FLOW 460gpd L.T.A.R. 2.03

Septic Tank: 1000 Gallons; STB 312 Date 10/13/99
Pump Tank: 1000 Gallons; PT 27 Date 5/8/99
Pump Make: MYERS Model ME 100S-21 Serial No. 25325 D022
Nitrification Field: No Fields 1 Square Feet 1200 Linear Feet 400
No Lines 5@80' Trench Width 36" Max Trench Bottom Depth ~30" Gravel Depth NA

☑ New System ☐ Repair System Type: I, II, (III) IV, V, VI
System Description: pumped pressure - chambered 4A
Repair System Description: LP Panel Block 4A
Maintenance Agreement Required: ☐ Yes ☑ No


☑ House/Mod. Home No. Bedrooms 4
☐ Mobile Home No. Bathrooms 4
☐ Business No. Employees _____
☐ Other _____
☐ Slab ☐ Crawl Space ☑ Basement w/plumbing ☐ Basement wo/plumbing

Water Supply:
☐ Individual
☐ Community
☑ Public

Comments: 1-27-99 Reviewed site & floorplan - Appears in compliance w/ IP. DLA

Comments: TANKS, PUMP-FLOATS - [redacted] 1/28/00 - AWS

INITIAL SITE SKETCH

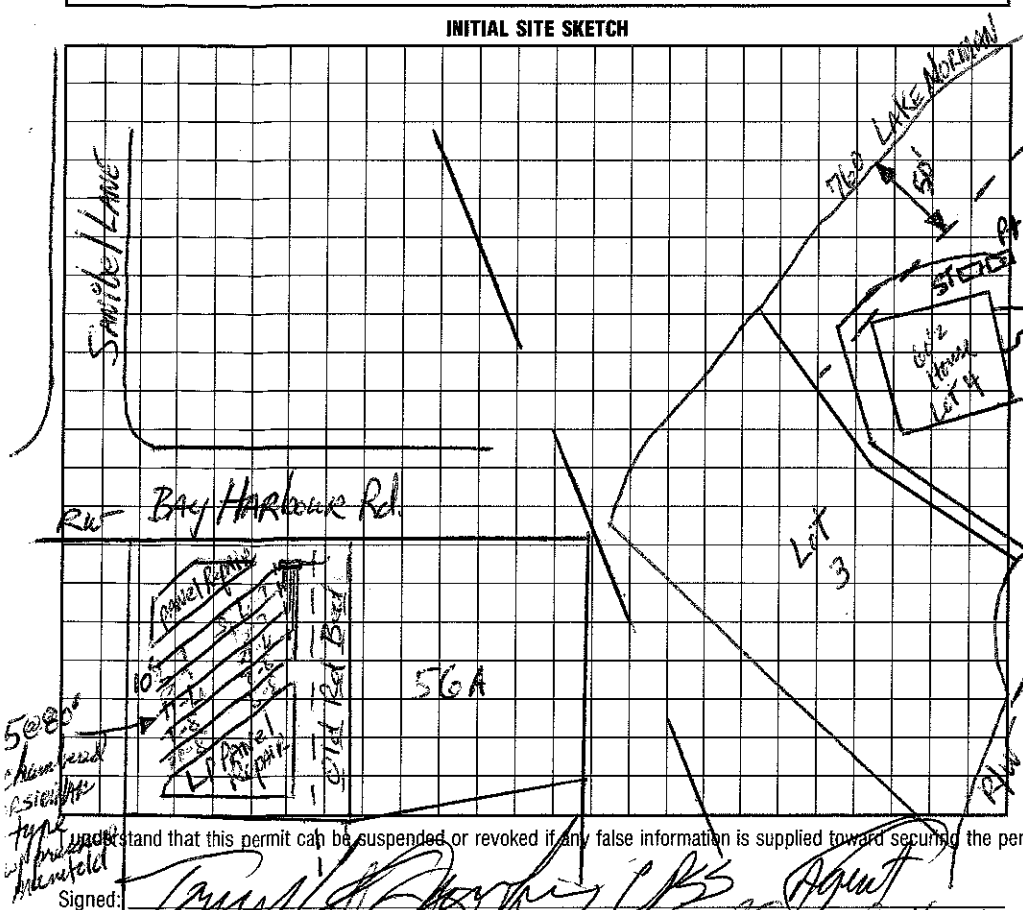

AS BUILT SKETCH

I understand that this permit can be suspended or revoked if any false information is supplied toward securing the permit/any unauthorized changes are made to the site/any unauthorized changes are made in the installation of the system.

Signed: _____ Agent

Improvement Permit by: _____ RS date 9-4-96

~~Existing System~~ Constructed Inspection by: _____ RS date 1-27-99

Installed by: Ordison Const. Co.

Certificate of Completion by: Wesley Sparks RS. date 5/26/00

Operation Permit by: Wesley Sparks RS. date 5/26/00

HEALTH DEPT. COPY: White INSPECTION COPY (FINAL): GREEN OWNER COPY (FINAL): YELLOW INSPECTION COPY (INITIAL): PINK OWNER COPY (INITIAL): GOLD

REVISED 4/00