IREDELL COUNTY HEALTH DEPARTMENT

STATESVILLE 704-878-5305 50.00 Paid MOORESVILLE 704-664-5281

IMPROVEMENT PERMIT / AUTHORIZATION TO CONSTRUCT / OPERATION PERMIT / EXISTING SYSTEM INSPECTION

PERMIT# 065693 PIN# 4625 44 1684 pt 4625 39 0543 DATE 1/28/02

OWNER OR CONTRACTOR BRIAN LITTLE PHONE: Business 987-9599 Home

ADDRESS ~~P O BOX~~ 20921 STERLING VBAY LN. CORNELIUS NC 28031 135 Tranquil Cove Rd

LOCATION BRAWLEY SCHOOL - TR BAY HARBOUR - TR SHIPYARD - TL CEDAR BLUFF - TL TRANQUIL - ON LT AT END

SUBDIVISION ~~HON~~ HARBOUR BLOCK / SECTION 6 LOT 49 LOT AREA 48792 SITE CLASS PS DESIGN FLOW 600GPD L.T.A.R. .36 GPD/FT2

Septic Tank: ~~1000~~ 1500 Gallons; STB 112 Date 4/9/02
Pump Tank: 1500 Gallons; PT 338 Date 7/9/02
Pump Make: MYERS Model WE-50 Serial No. N/A
Nitrification Field: No Fields 1 Square Feet 1500 Linear Feet 500
No Lines 5@100' Trench Width 36" Max Trench Bottom Depth 36" Gravel Depth N/A

☑ New System ☐ Repair System Type: I, II, (III), IV, V, VI
System Description: PUMP 2506 REDUCTION
Repair System Description: LP PANEL
Maintenance Agreement Required: ☐ Yes ☑ No

☑ House/Mod. Home No. Bedrooms 5
☐ Mobile Home No. Bathrooms 2.5
☐ Business No. Employees
☐ Other


☐ Slab ☑ Crawl Space ☐ Basement w/plumbing ☐ Basement wo/plumbing

Water Supply: ☐ Individual ☐ Public ☑ Community


Comments/Conditions: 1) SUPPLY LINE UNDER DRIVE SLEEVED OR TO BE 36" DEEP.

Comments/Conditions: EZ LAY INSTALLED.

INITIAL SITE SKETCH 1" = 50'

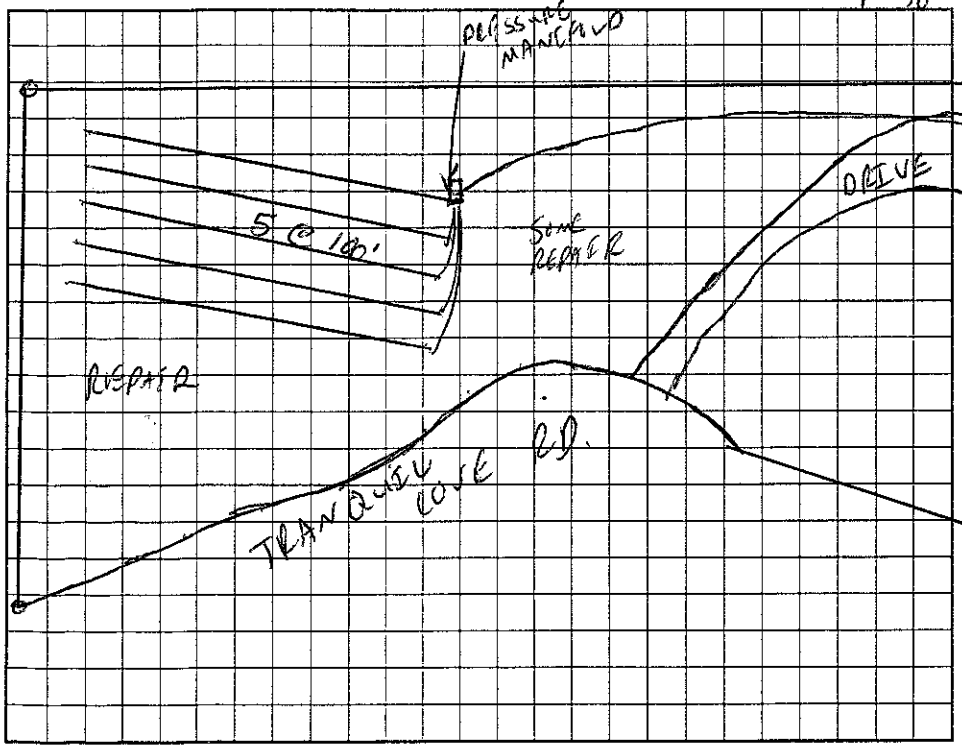

AS BUILT SKETCH

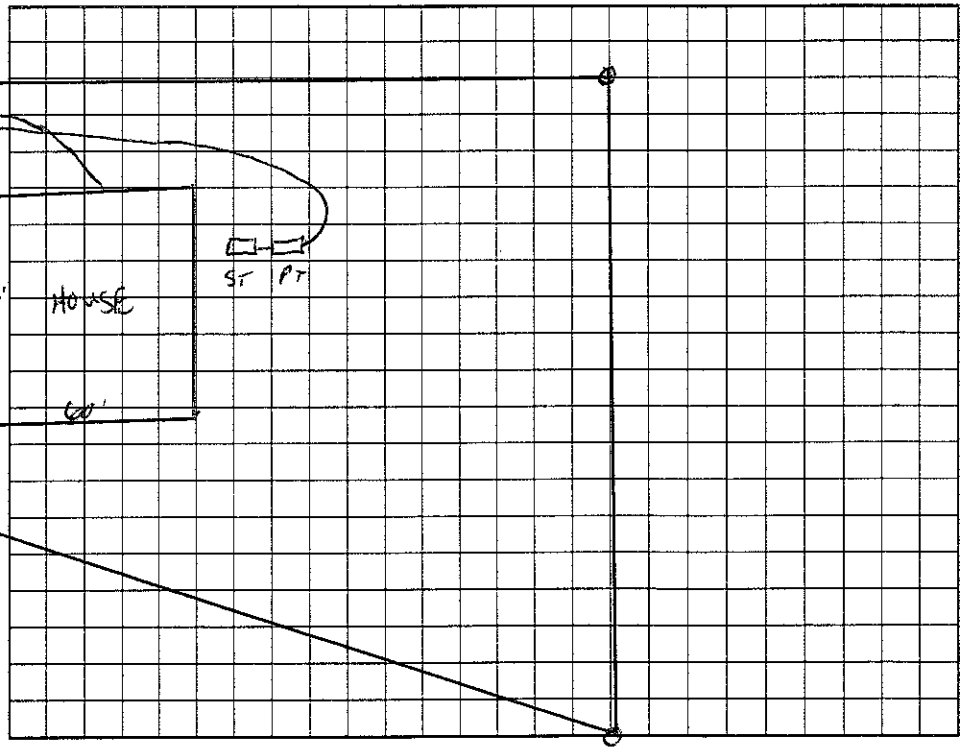

Permit can be suspended or revoked if any false information is supplied toward securing the permit/any unauthorized changes are made to the site/any unauthorized changes are made in the installation of the system. Improvement Permit with plat valid without expiration. Improvement Permit with site plan valid for sixty months. Authorization to Construct is valid for a period equal to that of Improvement Permit – not to exceed sixty months.

Signed: [signature] date 2/14/02 Installed by: WT Norwood.

Improvement Permit by: [signature] RS date 1/28/02 Operation Permit by: Wesley Sparks R.S. date 10/18/02

Authorization to Construct by: [signature] RS date 1/28/02 Existing System Inspection by: date

HEALTH DEPT. COPY: WHITE OWNER COPY (FINAL): YELLOW OWNER COPY (INITIAL): PINK