IREDELL COUNTY HEALTH DEPARTMENT Const. Auth. STATESVILLE 704-878-5305 MOORESVILLE 704-664-5281

IMPROVEMENT PERMIT / ~~CERTIFICATE OF COMPLETION~~ / OPERATION PERMIT / EXISTING SYSTEM INSPECTION

PROPERTY DESCRIPTION NO. 065643 DATE May 23, 197 TAX MAP NO. 4625941684 (pt) Watershed: ☐ Yes ☐ No

OWNER OR CONTRACTOR Crescent Resources Inc. / REGAL Custom Homes PHONE: Business ~~Home~~ 4625-39-2936

ADDRESS P.O. Box 1003 Charlotte

LOCATION Brawley Sch Rd. TR Bay Harbour TR Shipyard Pt. Rd. on Right at jct w/ Cades Cove Ln.

SUBDIVISION The Harbour BLOCK / SECTION 6 LOT 5 LOT AREA ± 20,000 sf SITE CLASS. #5 DESIGN FLOW 480 gpd L.T.A.R. .3

Septic Tank: 1000 Gallons; STB 312 Date 12/5/95
Pump Tank: _____ Gallons; PT _____ Date _____
Pump Make: _____ Model _____ Serial No. _____
Nitrification Field: No Fields 1 Square Feet 1200 Linear Feet 400
No Lines 4@100' Trench Width 36" Max Trench Bottom Depth 36" Gravel Depth N/A

☑ New System ☐ Repair System Type: I, II, (III) IV, V, VI
System Description: gravity chambered
Repair System Description: grav./pumped, panel block
Maintenance Agreement Required: ☐ Yes ☑ No

☑ House/Mod. Home No. Bedrooms 4
☐ Mobile Home No. Bathrooms 4
☐ Business No. Employees _____
☐ Other _____

☐ Slab ☑ Crawl Space ☐ Basement w/plumbing ☐ Basement wo/plumbing


Water Supply:
☐ Individual
☑ Community
☐ Public

Comments:

Comments:

1"=50'

INITIAL SITE SKETCH

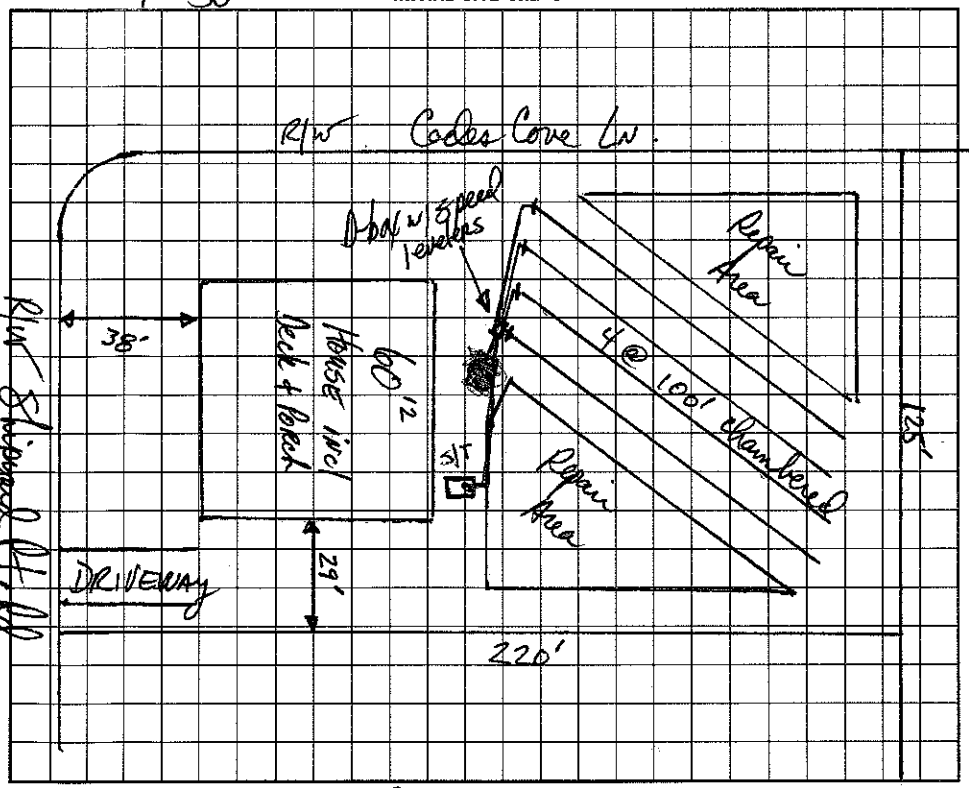

AS BUILT SKETCH

I understand that this ~~permit~~ can be suspended or revoked if any false information is supplied toward securing the permit/any unauthorized changes are made to the site/any unauthorized changes are made in the installation of the system. Improvement Permit is valid for 60 months from date of issuance.

Signed: _____

Improvement Permit by: _____ date 5-23-97

~~Existing System Inspection by~~ CONSTRUCTION AUTHORIZATION: Wesley Sparks RS. date 8/9/99

Installed by: Orbison Const. Co.

Certificate of Completion by: Wesley Sparks RS. date 2/28/00

Operation Permit by: _____ date _____

HEALTH DEPT. COPY: WHITE INSPECTION COPY (FINAL): GREEN OWNER COPY (FINAL): YELLOW INSPECTION COPY (INITIAL): PINK OWNER COPY (INITIAL): GOLD