IREDELL COUNTY HEALTH DEPARTMENT

Expansion of 08

STATESVILLE 704-878-5305 MOORESVILLE 704-664-5281

IMPROVEMENT PERMIT / AUTHORIZATION TO CONSTRUCT / OPERATION PERMIT / EXISTING SYSTEM INSPECTION

PERMIT# 151717 PIN# 4625393952.000 DATE 7/24/08

OWNER OR APPLICANT Barry & Julianne McConahey PHONE: Business 704 975-0858 Home 704 658-6932

ADDRESS 114 Shipyard Pt Rd. Mooresville NC 28117

LOCATION Brawley Sch Rd. TR The Harbour at The Point TR Shipyard Pt on rt

SUBDIVISION The Harbour BLOCK / SECTION 6 LOT 4 LOT AREA .58 SITE CLASS. P5 DESIGN FLOW 480 L.T.A.R. .3

Septic Tank: 1000 NEW Gallons: STB 794 Date 10-26-07
Pump Tank: _____ Gallons: PT _____ Date _____
Pump Make: _____ Model _____ Serial No. _____
Nitrification Field: No Fields 1 Square Feet Exis 1200' Linear Feet Exis 400'
No Lines Exis 4 Trench Width 36" Max Trench Bottom Depth 36" Gravel Depth N/A

☐ New System ☐ Repair ☑ Expansion System Type: I (II) III IV V VI
System Description: Install New Septic Tank
Repair System Description: LEPPERS
Maintenance Agreement Required: ☐ Yes ☒ No

☑ House/Mod. Home No. Bedrooms 4
☐ Mobile Home No. Persons ___
☐ Business No. Employees ___
☑ Other 8'x48' addition


Water Supply: ☐ Individual ☑ Public ☑ Community MCU

☑ Gravity ☐ Pressure ☐ Slab ☐ Crawl Space ☐ Basement w/plumbing ☐ Basement wo/plumbing


Comments/Conditions: Existing Septic Tank may be usable if it can be moved to new location safely. If not crush Exis tank in place and install new 1000 gallon tank. Reroute outlet pipe to Exis DB w/ Flow levelers to save room for possible future Deck.

Comments/Conditions: Plans for 8'x48' addition to house. Not changing number of bedrooms (Min 5' from addition) (See Exis permit Crescent Inc/Regal Custom Homes 2/25/00)

INITIAL SITE SKETCH

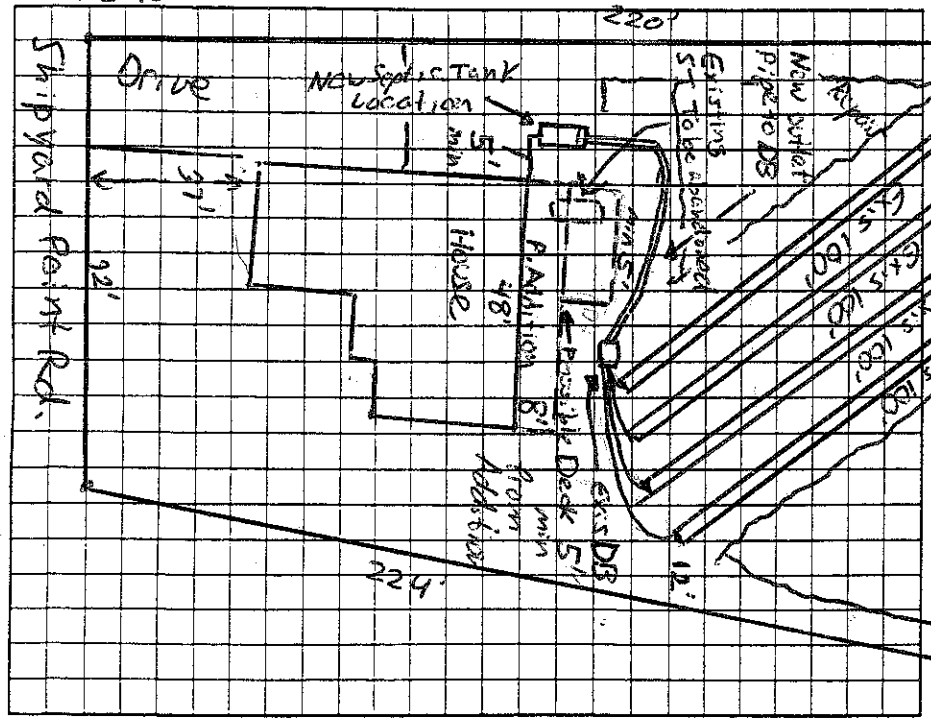

AS BUILT SKETCH

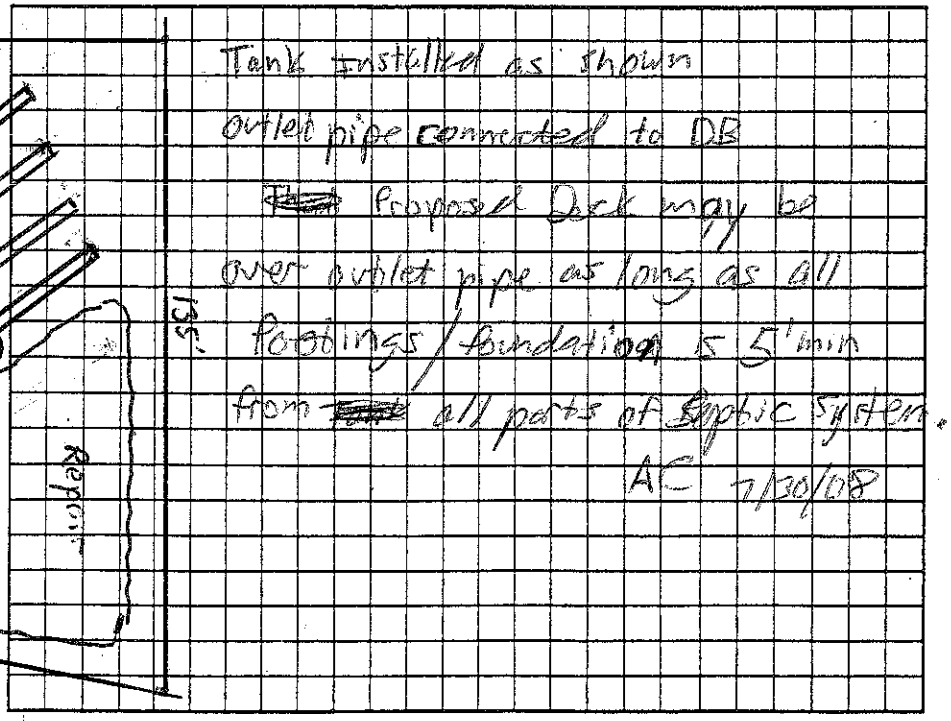

Permit can be suspended or revoked if any false information is supplied toward securing the permit/any unauthorized changes are made to the site/any unauthorized changes are made in the installation of the system. Improvement Permit with plat valid without expiration ☐ Improvement Permit with site plan valid for sixty months ☑ Authorization to Construct is valid for a period equal to that of Improvement Permit – not to exceed sixty months.

Signed: Julianne McConahey date 7/25/08 Installed by: Tim Ammonds

Improvement Permit by: Anthony Coker Jr RS. date 7/24/08 Operation Permit by: Anthony Coker Jr. RS. date 7/30/08

Authorization to Construct by: Anthony Coker Jr RS. date 7/24/08 Existing System Inspection by: _____ date _____

HEALTH DEPT. COPY: WHITE OWNER COPY (FINAL): YELLOW OWNER COPY (INITIAL): PINK