IREDELL COUNTY HEALTH DEPARTMENT

Statesville Office (704) 878-5305 Mooresville Office (704) 660-3625 PERMIT # 181743

IMPROVEMENT PERMIT / AUTHORIZATION TO CONSTRUCT / OPERATION PERMIT / EXISTING SYSTEM

PIN # 4625-39-3952

APPLICANT: Barry McConaghey APPLICANT ADDRESS: 114 Shipyard Pointe Rd Mooresville NC 28117

SITE ADDRESS: 114 Shipyard Pointe Mooresville NC 28117 PHONE: 704-975-0858 ALT. PHONE:

SITE DIRECTIONS: Brawley Sch Rd, TR on Bay Harbour, TR on Shipyard Pointe, House on R


SUBDIVISION: The Harbour SECTION: 6 LOT # 4 LOT AREA: 0.58 ac DESIGN FLOW: 600 L.T.A.R.: 0.3

Septic Tank	1500 (gal)	~~SPT~~ 70-143-15D-C3	Date -	☐ New System ☐ Repair ☑ Expansion	System Type: I II (III) IV V VI	☑ Residence	No. Bedrooms	5	Water Supply
Pump Tank	(gal)	PT	Date	System Description: Gravity 25% Reduction		☐ Business	No. Persons	10	☐ Private
Pump Make	Model		Serial #	Repair System Description: LP PPBPS		☐ Other	No. Employees		☐ Public
# Nitrification Fields	1 # Lines	3	Linear Ft: 116'	Maintenance Agreement Required: ☐ YES ☑ NO		☐ Slab	☑ Crawl Space		☑ Community
Trench Width	36" Max. Trench Bottom Depth	36"	Gravel Depth N/A	☑ GRAVITY ☐ PRESSURE		☐ Basement w/plumbing		☐ Basement w/o plumbing	


Comments / Conditions: ~~*~~ EXISTING ST TO BE PUMPED, CRUSHED, AND BACKFILLED OR REMOVED, 15' OF 1st EXISTING LINE CLOSEST TO DECK TO BE REMOVED OR ABANDONED AND NEW END CAP PLACED AT NEW END, EARTHEN DAM SHOULD BE CREATED BETWEEN NEW END AND OLD, D-BOX TO BE ABANDONED ~~OR~~

Poly Lok filter Installed
Orange Infiltrator Tanks set
70-143-15D-C3
New Lines Installed as Shown

INITIAL SITE SKETCH

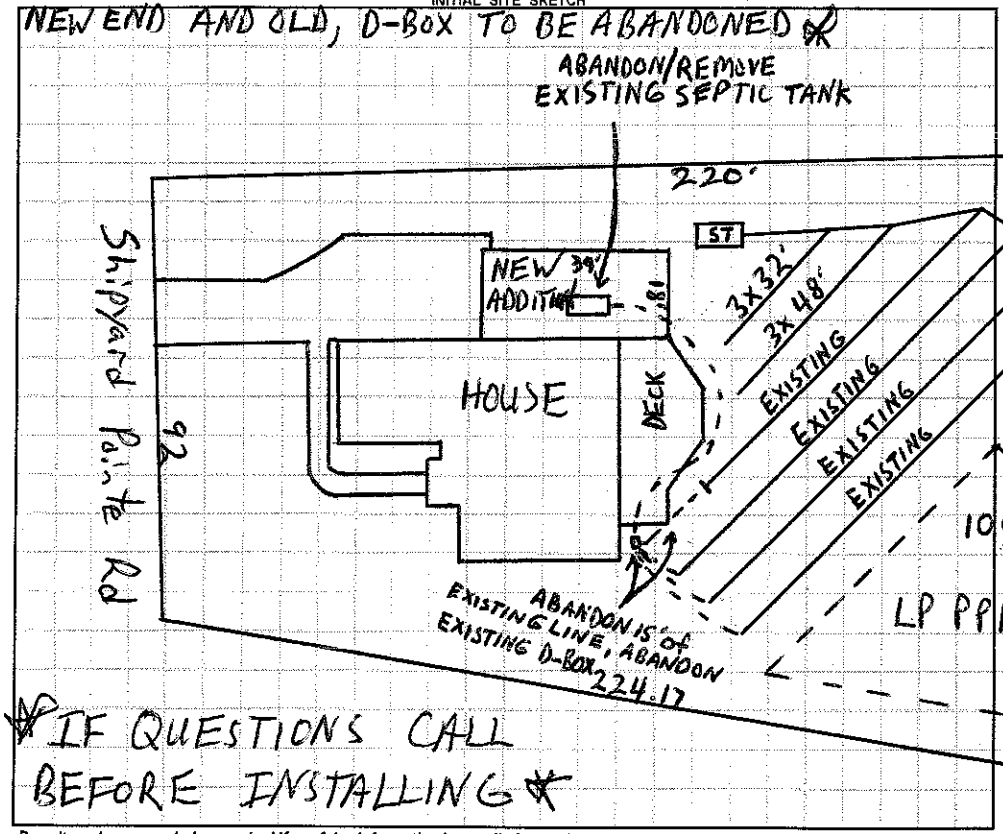

AS BUILT SKETCH

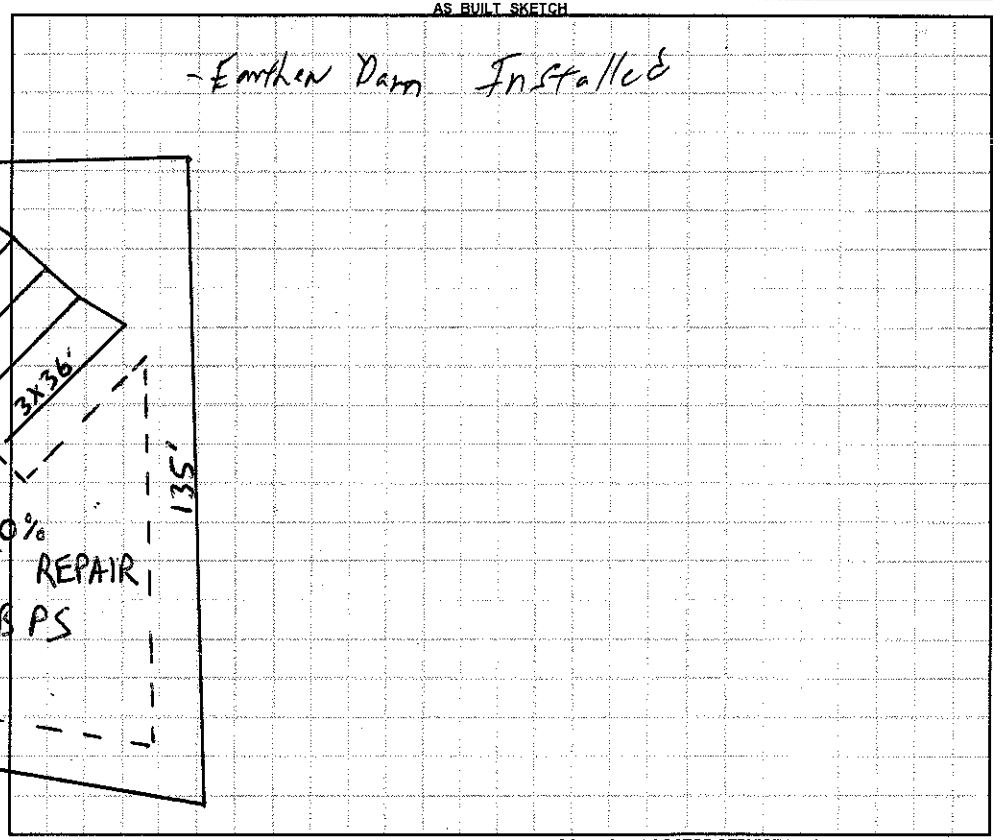

Permit can be suspended or revoked if any false information is supplied toward securing the permit / any unauthorized changes are made to the site / any unauthorized changes are made in the installation of the system. **CONTACT A LOCATOR SERVICE PRIOR TO ANY EXCAVATION**

☐ **IMPROVEMENT PERMIT** *with plat valid without expiration.* ☑ **IMPROVEMENT PERMIT** *with site plan valid for 60 mos.* ☑ **AUTHORIZATION TO CONSTRUCT** *valid for period equal to IMPROVEMENT PERMIT--not to exceed 60 mo.*

Owner / Applicant Signature: Julianne McConaghey Date: 12-3-13 Installed by: Richard Abernathy

IMPROVEMENT PERMIT by: [signature] Date: 12-2-13 OPERATION PERMIT by: William O. Johnson, REHS Date: 1/16/2014

AUTHORIZATION TO CONSTRUCT by: [signature] Date: 12-2-13 Existing System Inspected by: Date:

Health Dept. Copy - WHITE Applicant (Final Approval) - YELLOW Applicant (Conditional Approval) - PINK