IREDELL COUNTY HEALTH DEPARTMENT

STATESVILLE 704-878-5305 MOORESVILLE 704-664-5281

IMPROVEMENT PERMIT / AUTHORIZATION TO CONSTRUCT / OPERATION PERMIT / EXISTING SYSTEM INSPECTION

PERMIT# 065635 PIN# 4625 94 1684 DATE 8/5/98

OWNER OR CONTRACTOR Regal Custom Homes PHONE: Business 509-9100 Home

ADDRESS 111145 Mt Harvard Park Charlotte NC 28269

LOCATION 1100 TR Bay Harbour on (R) at Shipyard Point intersection

SUBDIVISION Harbour BLOCK / SECTION 6 LOT 3 LOT AREA 26632 FT² SITE CLASS. PS DESIGN FLOW 480 L.T.A.R. .3

Septic Tank: 1000 Gallons; STB 794 Date 12/8/98

Pump Tank: 1000 Gallons; PT 27 Date 3/8/99

Pump Make: HYDROMATIC Model SK50-M1 Serial No. 3199

Nitrification Field: No Fields 1 Square Feet 1200 Linear Feet 400

No Lines 5 Trench Width 36" Max Trench Bottom Depth 36" Gravel Depth SAND

☒ New System ☐ Repair System Type: I, II, III, IV, V, VI

System Description: PressMan – Ch Plastic

Repair System Description: 16" PPBS

Maintenance Agreement Required: ☒ Yes ☐ No

☒ House/Mod. Home ☐ Mobile Home ☐ Business ☐ Other

No. Bedrooms 4 No. Bathrooms 4 No. Employees


☐ Slab ☒ Crawl Space ☐ Basement w/plumbing ☐ Basement wo/plumbing

Water Supply: ☐ Individual ☐ Public ☒ Community


Comments:/Conditions:

Comments:/Conditions:

INITIAL SITE SKETCH

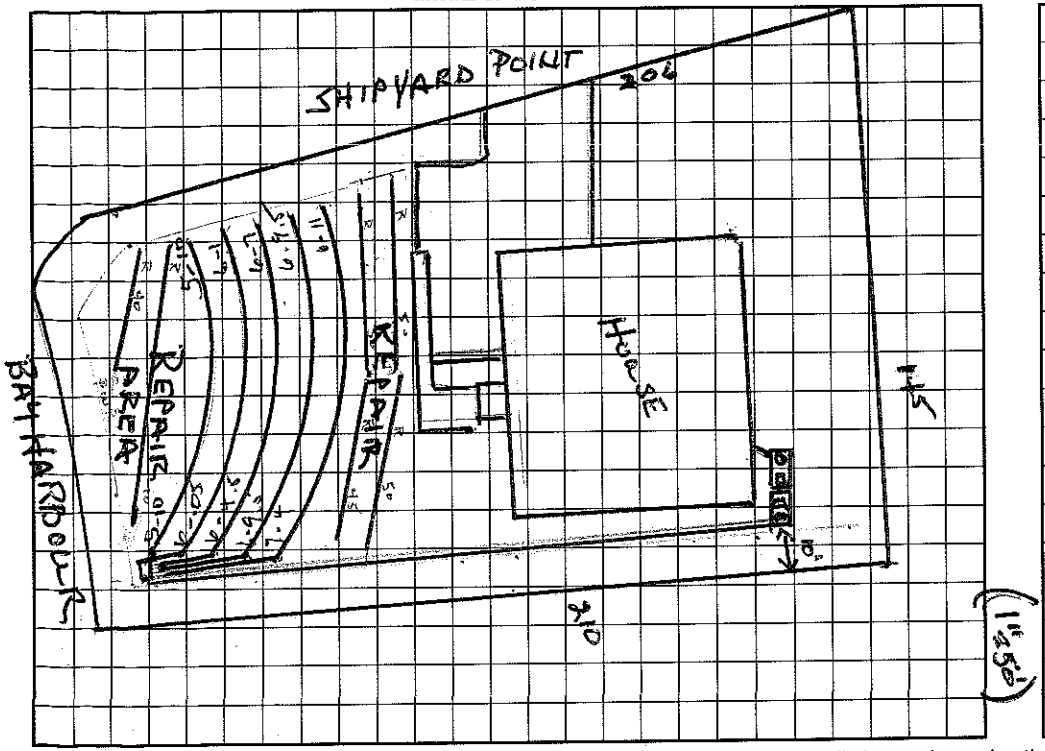

AS BUILT SKETCH

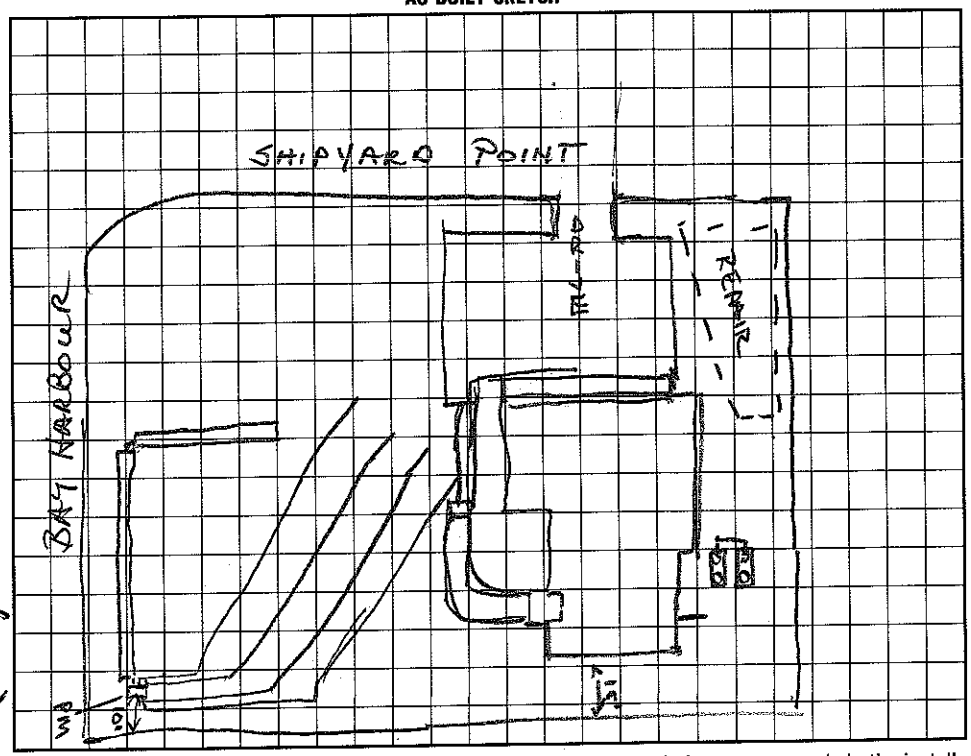

I understand that this permit can be suspended or revoked if any false information is supplied toward securing the permit/any unauthorized changes are made to the site/any unauthorized changes are made in the installation of the system. Improvement Permit with plat valid without expiration. Improvement Permit with site plan valid for sixty months. Authorization to Construct is valid for a period equal to that of Improvement Permit – not to exceed sixty months.

Signed: ✗ Joseph R Tuttle date 8/6/98

Improvement Permit by: Wesley Sparks R.S. date 4/6/98

Authorization to Construct by: Wesley Sparks RS date 4/6/98

Installed by: Osbison Const.

Operation Permit by: date

Existing System Inspection by: date

HEALTH DEPT. COPY: WHITE INSPECTION COPY (FINAL): GREEN OWNER COPY (FINAL): YELLOW INSPECTION COPY (INITIAL): PINK OWNER COPY (INITIAL): GOLD