IREDELL COUNTY HEALTH DEPARTMENT

STATESVILLE 704-878-5305 50.00 Paid MOORESVILLE 704-664-5281

IMPROVEMENT PERMIT / AUTHORIZATION TO CONSTRUCT / OPERATION PERMIT / EXISTING SYSTEM INSPECTION

PERMIT# 10772 PIN# 4625-39-5221 DATE 3/24/04

OWNER OR CONTRACTOR Barbara Kosior PHONE: Business Home 704 663-1015

ADDRESS 117 Canvas Back

LOCATION BSR, TR Bay Harbor, TL Island Cove, on Corner

SUBDIVISION Harbour BLOCK / SECTION 5 LOT 1 LOT AREA 5104sFt2 SITE CLASS. PS DESIGN FLOW 480 L.T.A.R. 0.3

Septic Tank: 1000 Gallons; STB 312 Date 10/9/04

Pump Tank: 1000 Gallons; PT 27 Date 10/8/04

Pump Make: Zoeller Model WE0-3121HHU Serial No.

Nitrification Field: No Fields ___ Square Feet 1200 Linear Feet 400

No Lines 3o-4 Trench Width 36" Max Trench Bottom Depth 36" Gravel Depth —

☒ New System ☐ Repair System Type: I, II, (III), IV, V, VI

System Description: PM 2590 Readiset

Repair System Description: Paul Black

Maintenance Agreement Required: ☐ Yes ☒ No

☒ House/Mod. Home ☐ Mobile Home ☐ Business ☐ Other

No. Bedrooms 4 No. Bathrooms 4 No. Employees ___

☐ Slab ☐ Crawl Space ☒ Basement w/plumbing ☐ Basement wo/plumbing


Water Supply: ☐ Individual ☐ Public ☒ Community

Comments:/Conditions:


1"=50'

Comments:/Conditions: Pressure Bulb elevation installed

INITIAL SITE SKETCH

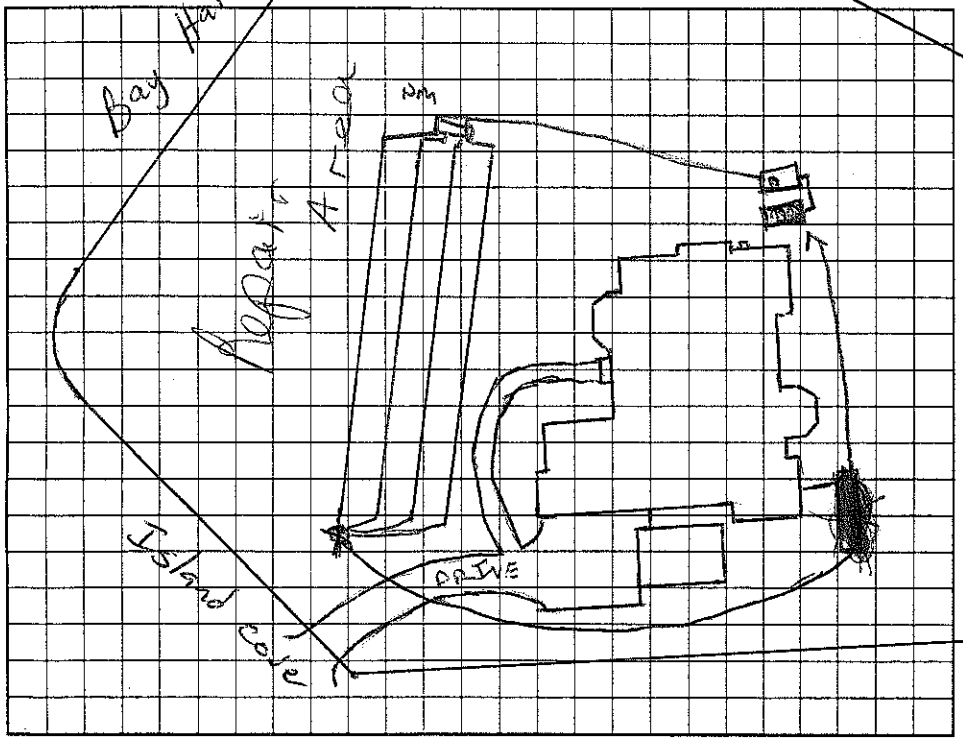

AS BUILT SKETCH

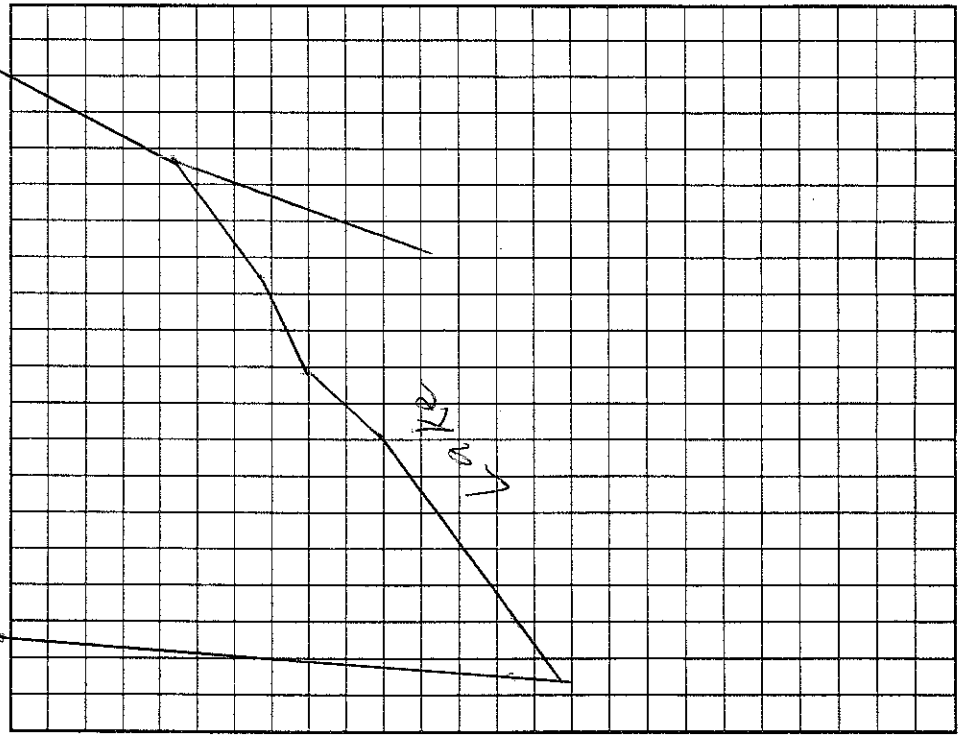

Permit can be suspended or revoked if any false information is supplied toward securing the permit/any unauthorized changes are made to the site/any unauthorized changes are made in the installation of the system. Improvement Permit with plat valid without expiration. Improvement Permit with site plan valid for sixty months. Authorization to Construct is valid for a period equal to that of Improvement Permit – not to exceed sixty months.

Signed: [signature] date 3/25/04 Installed by: Vincent Dunning

Improvement Permit by: [signature] RS date 3/24/04 Operation Permit by: Wesley Sparks RS date 1/21/05

Authorization to Construct by: [signature] RS date 3/24/04 Existing System Inspection by: ___ date ___

HEALTH DEPT. COPY: WHITE OWNER COPY (FINAL): YELLOW OWNER COPY (INITIAL): PINK