IREDELL COUNTY HEALTH DEPARTMENT Const-Auth · STATESVILLE 704-878-5305 MOORESVILLE 704-664-5281

IMPROVEMENT PERMIT / ~~CERTIFICATE OF COMPLETION~~ / OPERATION PERMIT / EXISTING SYSTEM INSPECTION

PROPERTY DESCRIPTION NO. 23376 DATE June 12, 196 TAX MAP NO. part of 4625 394790 Watershed: ☑ Yes ☐ No

OWNER OR CONTRACTOR Crescent Resources Inc (BRUILLEIN CONST) PHONE: Business / Home

ADDRESS PO Box 1003, Charlotte

LOCATION Brawley School Rd. TR Bay Harbour Rd. on left @ jct w/ Sanibel Lane

SUBDIVISION The Harbour BLOCK / SECTION III LOT 59 LOT AREA > 20,000 ft² SITE CLASS. PS pre 1956 DESIGN FLOW 480 gpd L.T.A.R. .13

Septic Tank: 1000 Gallons; STB 794 Date 11/6/99
Pump Tank: 1000 Gallons; PT 27 Date 11/22/99
Pump Make: HYDRO Model SK50A1 Serial No. 11/99
Nitrification Field: No. Fields 1 Square Feet 540 Linear Feet 270
No Lines @ 5 Trench Width 24" Max Trench Bottom Depth 30"

☑ New System ☐ Repair System Type: I, II, III, (IV), V, VI
System Description: LP PPBPS
Repair System Description: Same
Maintenance Agreement Required: ☑ Yes ☐ No
Gravel Depth NA

~~☐ House/Mod. Home~~ No. Bedrooms 4
☐ Mobile Home No. Bathrooms 4
☐ Business No. Employees
☐ Other
☐ Slab ~~☑ Crawl Space~~ ☐ Basement w/plumbing ☐ Basement wo/plumbing


Water Supply:
☐ Individual
☐ Community
~~☑ Public~~

Comments:

Comments:

1" = 50'

INITIAL SITE SKETCH

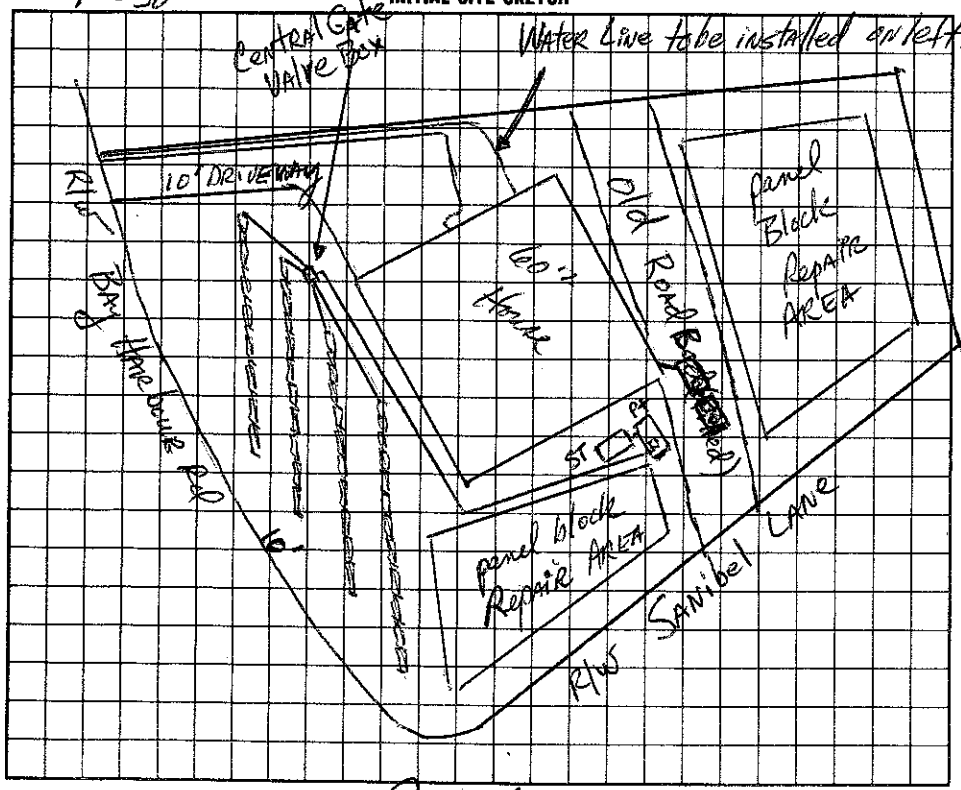

AS BUILT SKETCH

I understand that this ~~permit can be suspended or~~ revoked if any false information is supplied toward securing the permit/any unauthorized changes are made to the site/any unauthorized changes are made in the installation of the system.

Signed: [signature]

Improvement Permit by: Wesley Sparks RS date 6-12-96

~~Existing System Inspection by:~~ Const. Auth. Wesley Sparks RS date 5/12/99

Installed by: Cust D yammin's

Certificate of Completion by: Wesley Sparks RS. date 2/21/00

Operation Permit by: Wesley Sparks RS date 2/21/00

HEALTH DEPT. COPY: WHITE INSPECTION COPY (FINAL): GREEN OWNER COPY (FINAL): YELLOW INSPECTION COPY (INITIAL): PINK OWNER COPY (INITIAL): GOLD