Paid 50.00 Redraw 1:30

IREDELL COUNTY HEALTH DEPARTMENT

STATESVILLE 704-878-5305 MOORESVILLE 704-664-5281

IMPROVEMENT PERMIT / AUTHORIZATION TO CONSTRUCT / OPERATION PERMIT / EXISTING SYSTEM INSPECTION

PERMIT# 24355 PIN# ~~Pt. 2 ...~~ 4625-39-7040 DATE 12/7/00

OWNER OR CONTRACTOR Adams Egloff Avant PHONE: Business 336-760-1840 Home

ADDRESS 150 Charlois Blvd. Ste 224 Winston-Salem, NC. 27103

LOCATION 1100 TR Bay Harbour TL Island Cove on (L)

SUBDIVISION HARBOUR BLOCK / SECTION 5 LOT 3 LOT AREA > 20,000 FT SITE CLASS. PS DESIGN FLOW 480 L.T.A.R. .3

Septic Tank: 1000 Gallons; STB 794 Date 10/28/00

Pump Tank: 1000 Gallons; PT 27 Date 6/29/01

Pump Make: Gould Model WEC-511H Serial No. 7/20/01

Nitrification Field: No Fields 1 Square Feet 810 * Linear Feet 270

No Lines 3 Trench Width 3' Max Trench Bottom Depth 3' ~~Gravel Depth~~ SAND.

[X] New System ☐ Repair System Type: I, II, III, (IV), V, VI

System Description: Low Pressure - 16" PPBS

Repair System Description: SAME

Maintenance Agreement Required: [X] Yes ☐ No

[X] House/Mod. Home No. Bedrooms 4

☐ Mobile Home No. Bathrooms 4

☐ Business No. Employees

☐ Other

☐ Slab ☐ Crawl Space [X] PARTIAL Basement w/plumbing ☐ Basement wo/plumbing

Water Supply:
☐ Individual
☐ Public
[X] Community


Comments:/Conditions:

1:30


Comments:/Conditions:

138 Hse to Front R
128 to 1st Line from "
119 to 2nd
110 to 3rd

INITIAL SITE SKETCH

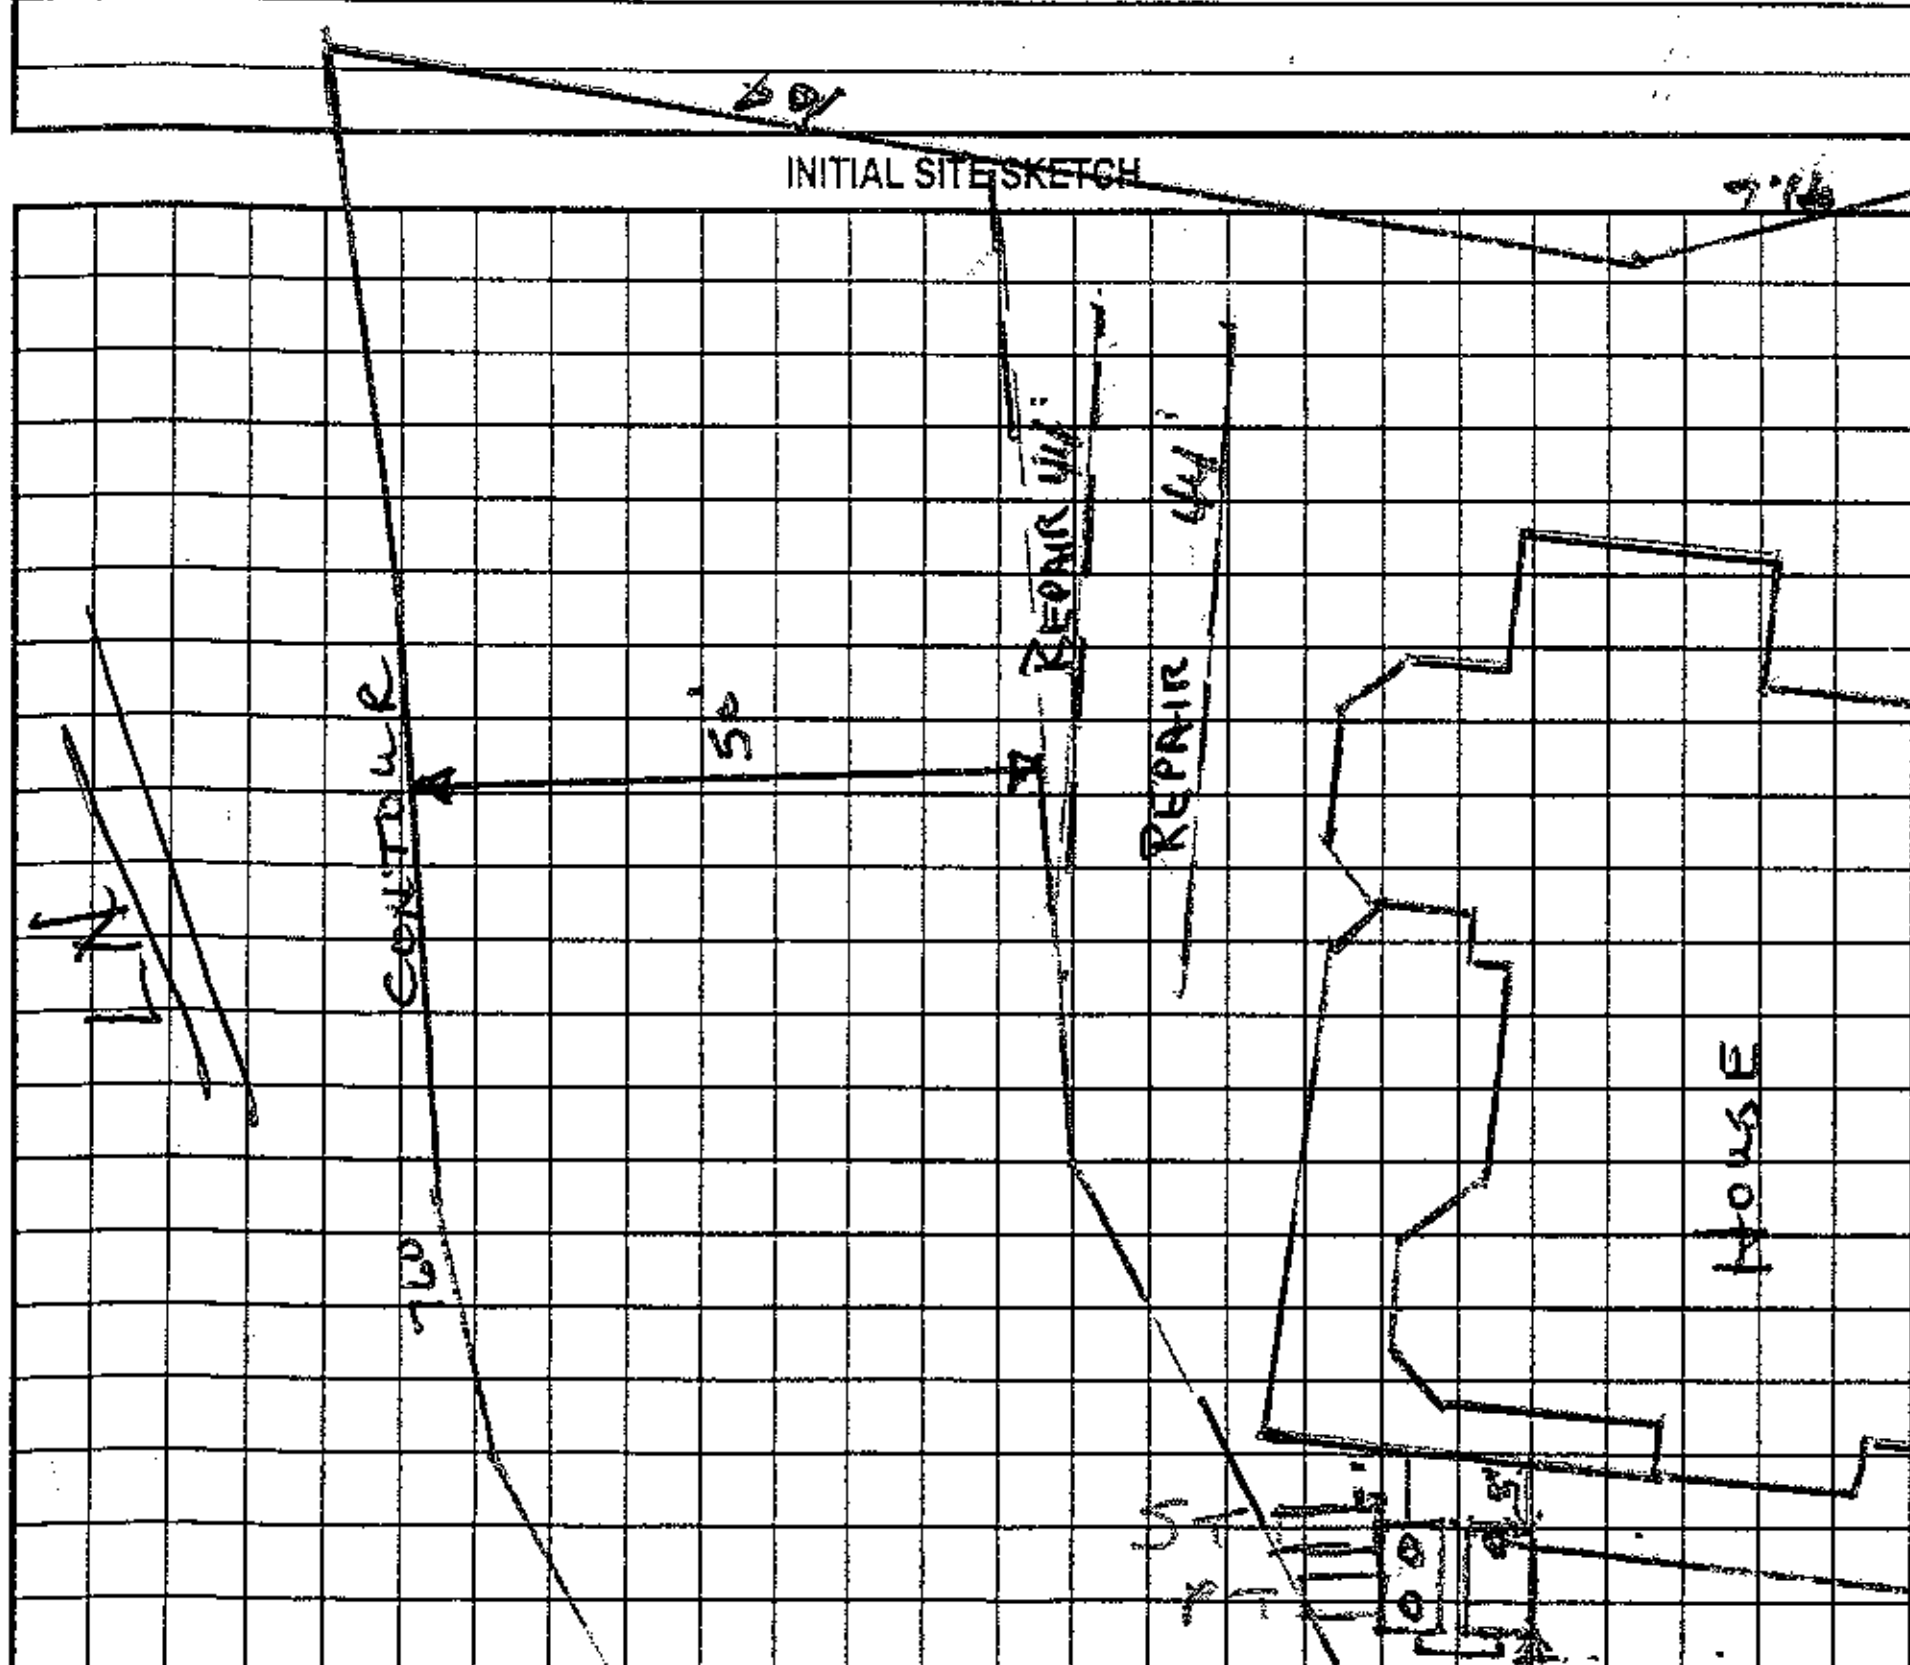

AS BUILT SKETCH

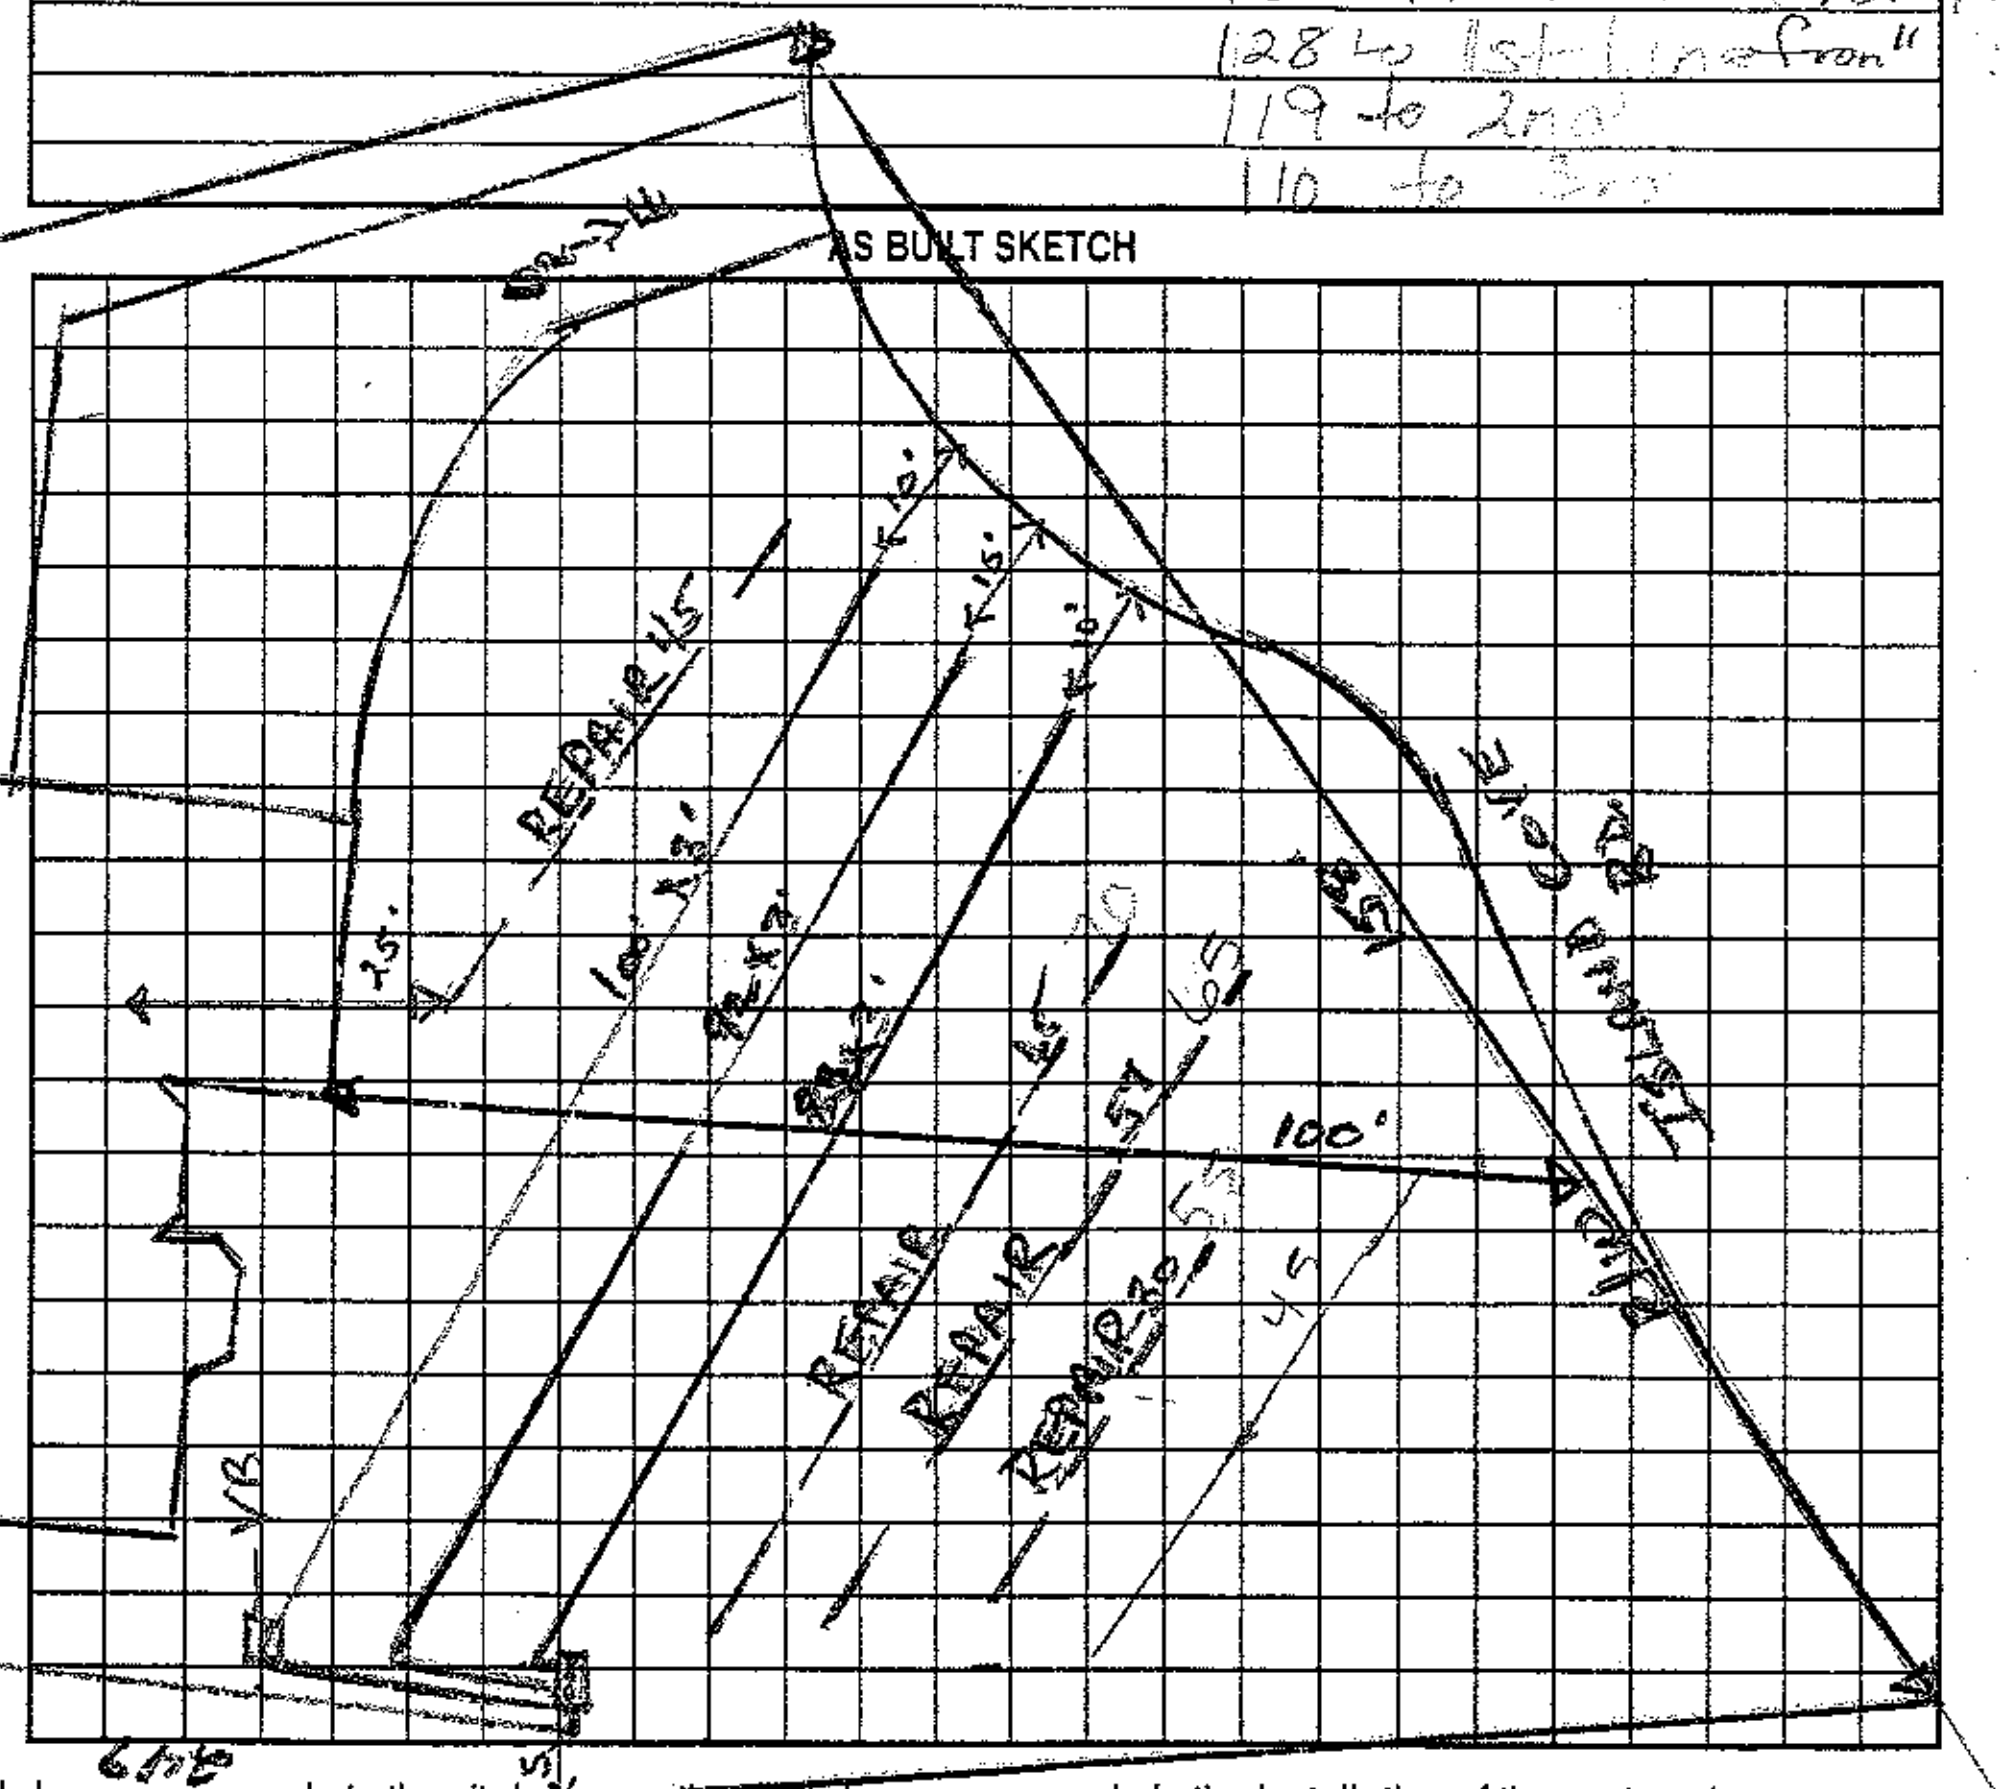

Permit can be suspended or revoked if any false information is supplied toward securing the permit/any unauthorized changes are made to the site/any unauthorized changes are made in the installation of the system. Improvement Permit with plat valid without expiration, Improvement Permit with site plan valid for sixty months. Authorization to Construct is valid for a period equal to that of Improvement Permit – not to exceed sixty months.

Signed: * [signature] date 12/19/00 Installed by: Orbison Const. Co.

Improvement Permit by: Wesley Sparks RS. date 12/7/00 Operation Permit by: [signature] RSI date 8/14/01

Authorization to Construct by: Wesley Sparks RS. date 12/7/00 Existing System Inspection by: date

HEALTH DEPT. COPY: WHITE OWNER COPY (FINAL): YELLOW OWNER COPY (INITIAL): PINK