3-4pm

IREDELL COUNTY HEALTH DEPARTMENT Const. Auth.

STATESVILLE 704-878-5305 MOORESVILLE 704-664-5281

IMPROVEMENT PERMIT / ~~CERTIFICATE OF COMPLETION~~ / OPERATION PERMIT / EXISTING SYSTEM INSPECTION

PROPERTY DESCRIPTION NO. 23379 DATE June 17 '96 TAX MAP NO. part of 2CA3 4625 39 7397 Watershed: ☑ Yes ☐ No

OWNER OR CONTRACTOR Crescent Resources Inc (McCRANIE BUILDERS) PHONE: Business _____ Home _____

ADDRESS PO Box 1003 Charlotte

LOCATION Beverly Beh Rd. TR Bay Harbour Rd. TL Sanibel Ln. on Right

SUBDIVISION The Harbour BLOCK / SECTION III LOT 68 LOT AREA > 20,000 ft² SITE CLASS. PS per 1996 DESIGN FLOW 480gpd L.T.A.R. .3

Septic Tank: 1000 Gallons; STB 794 Date 7-30-96

Pump Tank: 1000 Gallons; PT 27 Date 9-19-96

Pump Make: Hydromatic Model SHEF10A2 Serial No. 9198

Nitrification Field: No Fields 1 Square Feet 1200 Linear Feet 400

No Lines 4@100 Trench Width 36" Max Trench Bottom Depth 36"

☐ New System ☐ Repair System Type: I, II, III, IV, V, VI

System Description: pumped-to-chambered SFE D

Repair System Description: LPP panel block SFE D

Maintenance Agreement Required: ☐ Yes ☑ No

Gravel Depth N/A

☑ House/Mod. Home No. Bedrooms 4

☐ Mobile Home No. Bathrooms 4

☐ Business No. Employees _____

☐ Other _____


☐ Slab ☐ Crawl Space ☑ Basement w/plumbing ☐ Basement wo/plumbing

Water Supply:
☐ Individual
☐ Community
☑ Public


Comments: Inspection ports where installed

Comments: Tanks & lines checked 10/23/98 MD

INITIAL SITE SKETCH

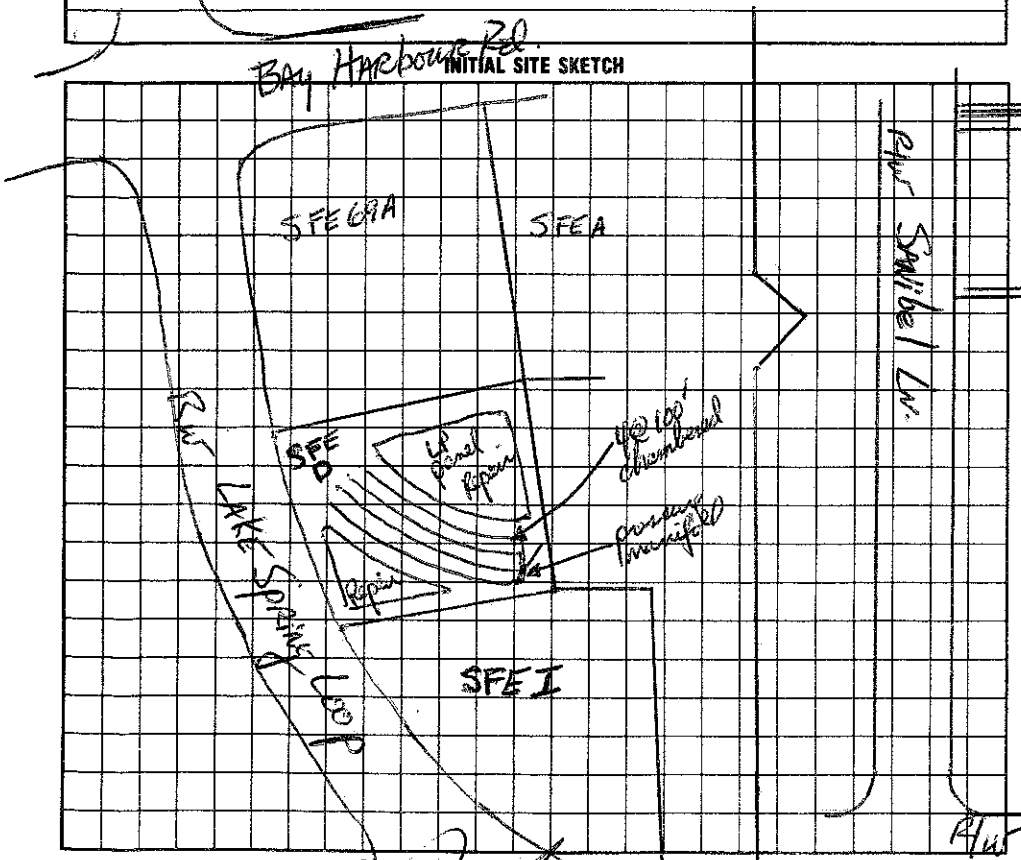

AS BUILT SKETCH

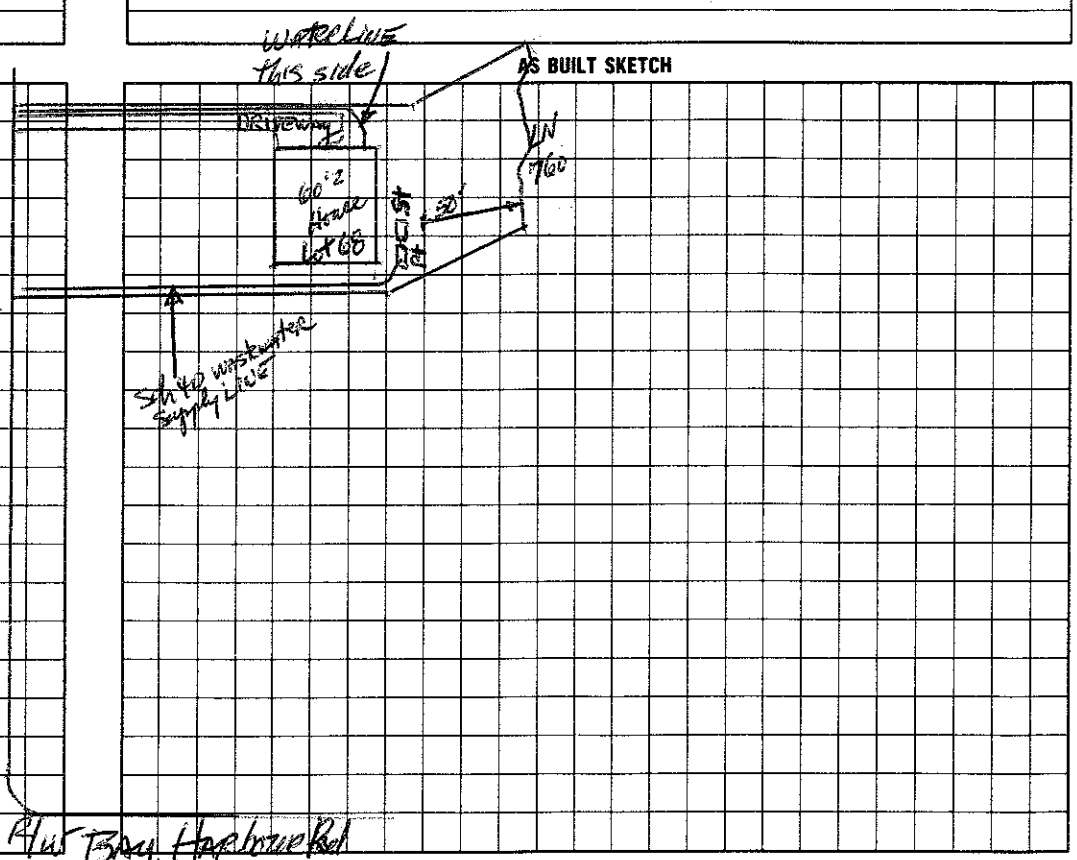

I understand that ~~this~~ permit can be ~~suspended or~~ revoked if any false information is supplied toward securing the permit/any unauthorized changes are made to the site/any unauthorized changes are made in the installation of the system.

Signed: _____

Improvement Permit by: _____ date 6-17-96

~~Construction~~ Authorization by: _____ date 2/16/98

Installed by: Curt Denning

Certificate of Completion by: _____ date _____

Operation Permit by: Wesley Sparks R.S. date 1/15/98

HEALTH DEPT. COPY: WHITE INSPECTION COPY (FINAL): GREEN OWNER COPY (FINAL): YELLOW INSPECTION COPY (INITIAL): PINK OWNER COPY (INITIAL): GOLD