IREDELL COUNTY HEALTH DEPARTMENT

Const. Auth STATESVILLE 704-878-5305 MOORESVILLE 704-664-5281

IMPROVEMENT PERMIT / ~~CERTIFICATE OF COMPLETION~~ / OPERATION PERMIT / EXISTING SYSTEM INSPECTION

PROPERTY DESCRIPTION NO. 23380 DATE June 18, 96 TAX MAP NO. part of 2CA3 4625 39 7428 Watershed: ☑ Yes ☐ No

OWNER OR CONTRACTOR Crescent Resources Inc. PHONE: Business _____ Home _____

ADDRESS PO Box 1003 Charlotte

LOCATION Brawley Sch Rd TR Bay Harbour TL Sanibel Lane 2nd lot on right

SUBDIVISION The Harbour BLOCK / SECTION III LOT 69 LOT AREA ≥20,000 ft² SITE CLASS. PSys.1956 DESIGN FLOW 480 gpd L.T.A.R. .3

Septic Tank: 1000 Gallons; STB 312 Date 5-7-00

Pump Tank: 1000 Gallons; PT 27 Date 11-16-99

Pump Make: Myers Model ME 100 Serial No. 8

Nitrification Field: No. Fields 1 Square Feet 1200 Linear Feet 400

No Lines 4@100' Trench Width 36" Max Trench Bottom Depth 36" Gravel Depth N/A

☐ New System ☐ Repair System Type: I, II, III, IV, V, VI

System Description: pumped-to-chambered SFE E

Repair System Description: LP panel block SFE E

Maintenance Agreement Required: ☐ Yes ☑ No

☑ House/Mod. Home No. Bedrooms 4

☐ Mobile Home No. Bathrooms 4

☐ Business No. Employees ____

☐ Other ____

☐ Slab ☐ Crawl Space ☑ Basement w/plumbing ☐ Basement wo/plumbing


Water Supply: ☐ Individual ☐ Community ☑ Public

Comments: Drainfield to be installed in septic field easement SFE


4-4-00 Reviewed revised site plan, appears in compliance w/ I.P.

Comments: Riser & filter installed Tanks & lines checked. 10/17/2000 Installed E-Z Flow.

INITIAL SITE SKETCH

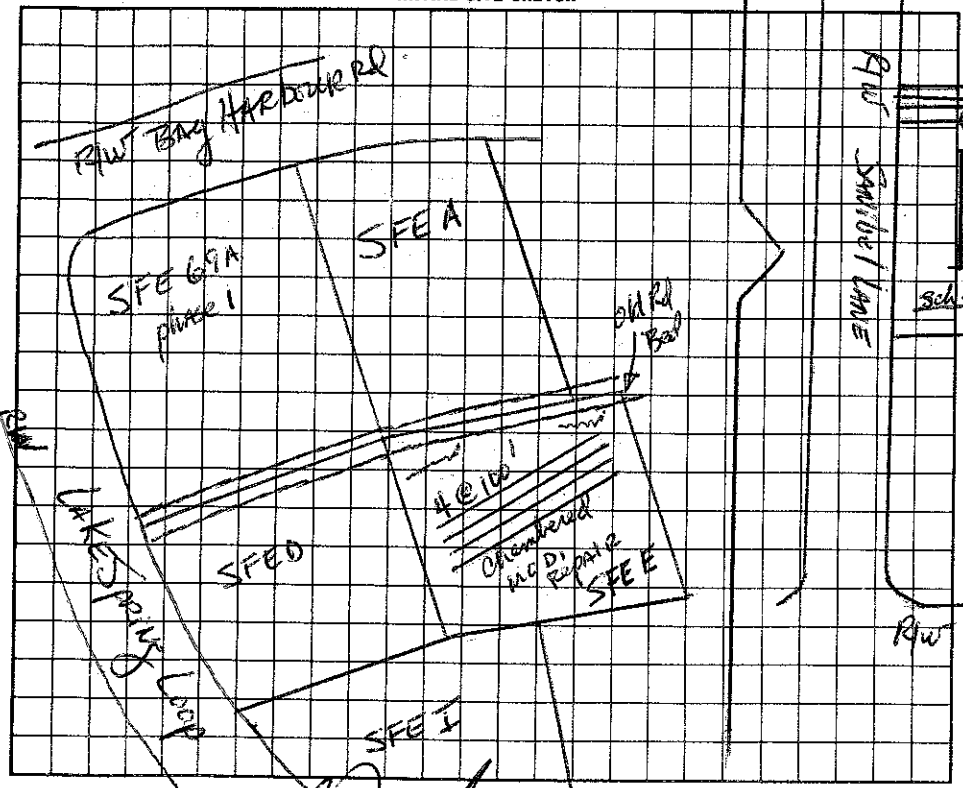

AS BUILT SKETCH

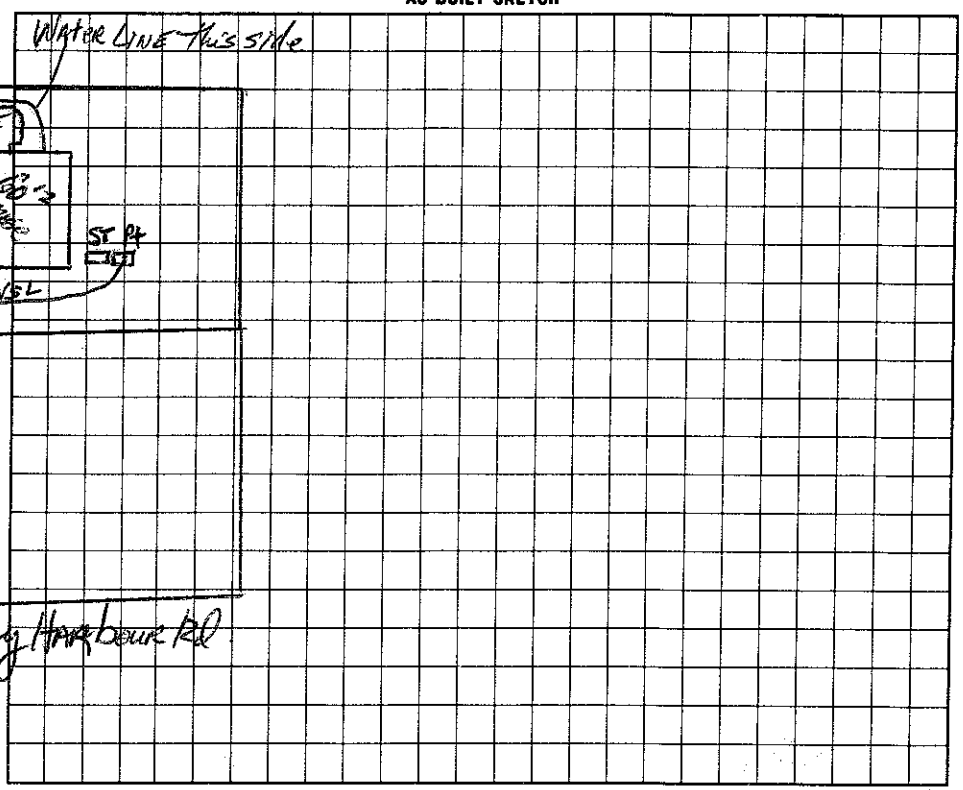

I understand that this permit can be suspended or revoked if any false information is supplied toward securing the permit/any unauthorized changes are made to the site/any unauthorized changes are made in the installation of the system.

Signed: _____

Improvement Permit by: _____ date 6-18-96

CONSTRUCTION AUTHORIZATION _____ date 4-4-00

Installed by: R & H

Certificate of Completion by: _____ date 12/13/2000

Operation Permit by: _____ date 12/13/2000

HEALTH DEPT. COPY: WHITE INSPECTION COPY (FINAL): GREEN OWNER COPY (FINAL): YELLOW INSPECTION COPY (INITIAL): PINK OWNER COPY (INITIAL): GOLD