IREDELL COUNTY HEALTH DEPARTMENT

Authorization to Construct

STATESVILLE 704-878-5305 MOORESVILLE 704-664-526

IMPROVEMENT PERMIT / ~~CERTIFICATE OF COMPLETION~~ / OPERATION PERMIT / EXISTING SYSTEM INSPECTION

PROPERTY DESCRIPTION NO. 069629 DATE 10/22/97 TAX MAP NO. 4625 39 7799 Watershed: X Yes ☐ No

OWNER OR CONTRACTOR Sammy Bullock PHONE: Business 365-9916 Home

ADDRESS 4525 Morrison Blvd. Charlotte, NC. 28211

LOCATION Bay Harbour on (L) just. Lake Spring Loop

SUBDIVISION Harbour BLOCK / SECTION III LOT 58 LOT AREA .64Ac SITE CLASS. 25 DESIGN FLOW 480 L.T.A.R. .3

Septic Tank: 1000 Gallons; STB 794 Date 12/18/97

Pump Tank: _____ Gallons; PT _____ Date _____

Pump Make: _____ Model _____ Serial No. _____

Nitrification Field: No Fields 1 Square Feet * 1200 Linear Feet 400 *

No Lines 4 Trench Width 36" Max Trench Bottom Depth 36" Gravel Depth SAND.

X New System ☐ Repair System Type: I, II, III, IV, V, VI

System Description: GRAV ~~PRESSURE~~ CHAMBS.

Repair System Description: IN REAR / SAME

Maintenance Agreement Required: ☐ Yes X No

X House/Mod. Home No. Bedrooms 4

☐ Mobile Home No. Bathrooms 2.5

☐ Business No. Employees _____

☐ Other _____


☐ Slab X Crawl Space ☐ Basement w/plumbing ☐ Basement wo/plumbing

Water Supply: ☐ Individual X Community ☐ Public


Comments: Sagtean — Gravity - Chem. Plastic

Comments:

INITIAL SITE SKETCH

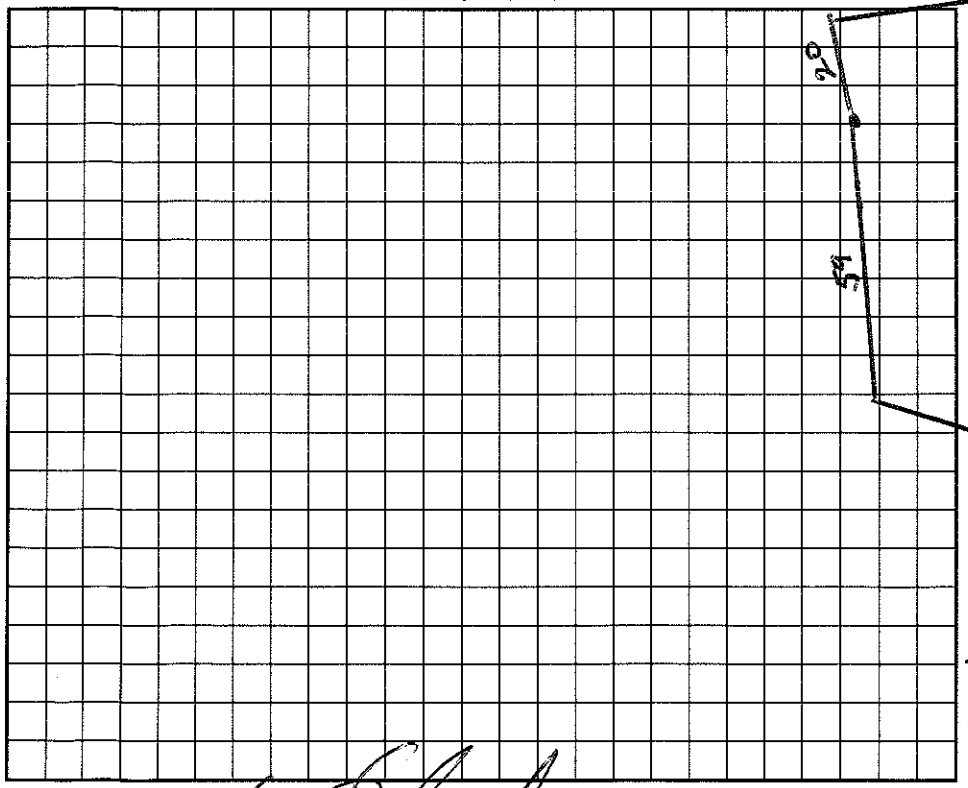

AS BUILT SKETCH

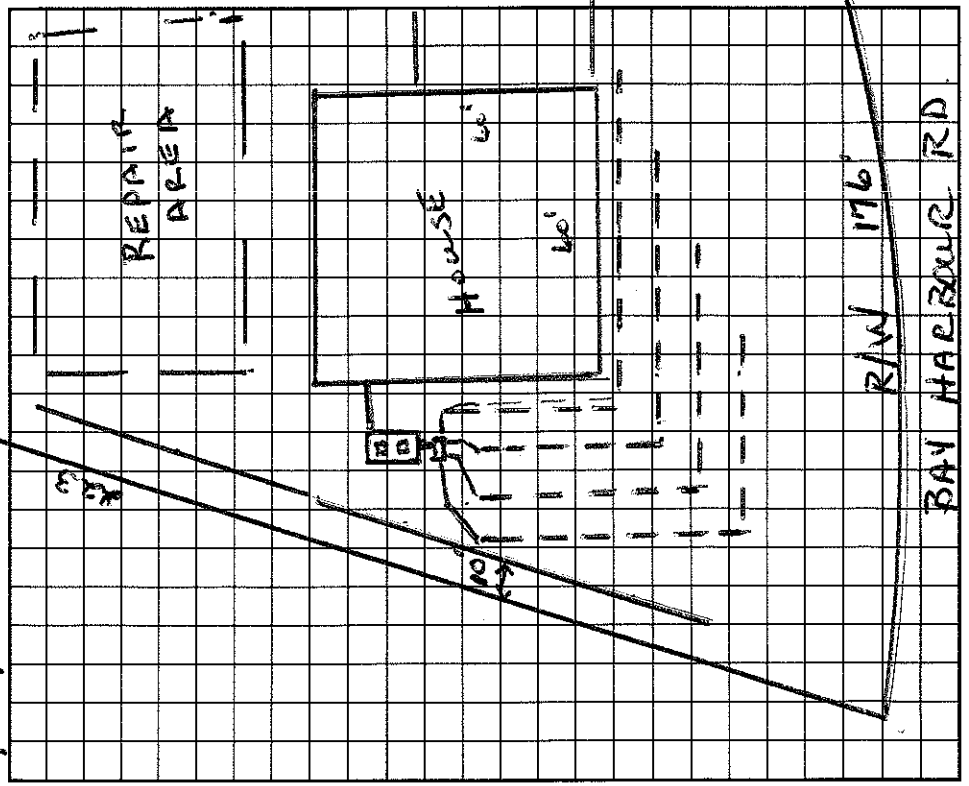

I understand that this permit can be suspended or revoked if any false information is supplied toward securing the permit/any unauthorized changes are made to the site/any unauthorized changes are made in the installation of the system. Improvement Permit is valid for 60 months from date of issuance.

Signed: *

Improvement Permit by: Wesley Speaks RS. date 10/22/97

~~Existing System Inspection~~ by: Wesley Speaks RS. date 10/22/97

Installed by: MacLeod Const Co

Certificate of Completion by: Wesley Speaks RS. date 4/28/98

Operation Permit by: Wesley Speaks RS. date 4/28/98

HEALTH DEPT. COPY: WHITE INSPECTION COPY (FINAL): GREEN OWNER COPY (FINAL): YELLOW INSPECTION COPY (INITIAL): PINK OWNER COPY (INITIAL): GOLD