(Southern Chase Homes)

IREDELL COUNTY HEALTH DEPARTMENT

Const. Auth. STATESVILLE 704-878-5305 MOORESVILLE 704-664-5281

IMPROVEMENT PERMIT / ~~CERTIFICATE OF COMPLETION~~ / OPERATION PERMIT / EXISTING SYSTEM INSPECTION

PROPERTY DESCRIPTION NO. 23378 80442 DATE June 13, '96 TAX MAP NO. ~~part of 2643~~ 4625398371 Watershed: ☑ Yes ☐ No

OWNER OR CONTRACTOR Crescent Resources Dev // William Kelly Moore PHONE: Business _____ Home _____

ADDRESS P.O. Box 1003, Charlotte

LOCATION Brawley Sch Rd. TR Bay Harbour Rd. TL Sanibel Lane at END on Right

SUBDIVISION The Harbour BLOCK / SECTION III LOT 67 LOT AREA ± 26,000 ft² SITE CLASS. B pre. 1978 DESIGN FLOW 480gpd L.T.A.R. ±3

Septic Tank: 1000 Gallons; STB 825 Date 12-3-99

Pump Tank: 1000 Gallons; PT 302 Date 11-18-99

Pump Make: _____ Model _____ Serial No. _____

Nitrification Field: No Fields 1 Square Feet 540 Linear Feet 270

No Lines 5 Trench Width 24" Max Trench Bottom Depth 30" Gravel Depth NA

☑ New System ☐ Repair System Type: I. II. III. (IV) V. VI

System Description: LP PPBPS

Repair System Description: LP PPBPS SFE "B" offsite

Maintenance Agreement Required: ☑ Yes ☐ No

☑ House/Mod. Home No. Bedrooms 4

☐ Mobile Home No. Bathrooms 4

☐ Business No. Employees _____

☐ Other _____

☐ Slab ☑ Crawl Space ☑ Basement w/plumbing ☐ Basement wo/plumbing

Water Supply: ☐ Individual ☐ Community ☑ Public

Comments: 3-24-99 - Reviewed house and site plan; appears substantially in compliance w/IP. Keep driveway close to left side/line and sidewalk within 10' of front of house. Jeff


Comments: PARTIAL

Riser installed on tanks


TANKS & LINES ~~installed~~ INSPECTED

12/5/2000 MH

INITIAL SITE SKETCH 1"=50'

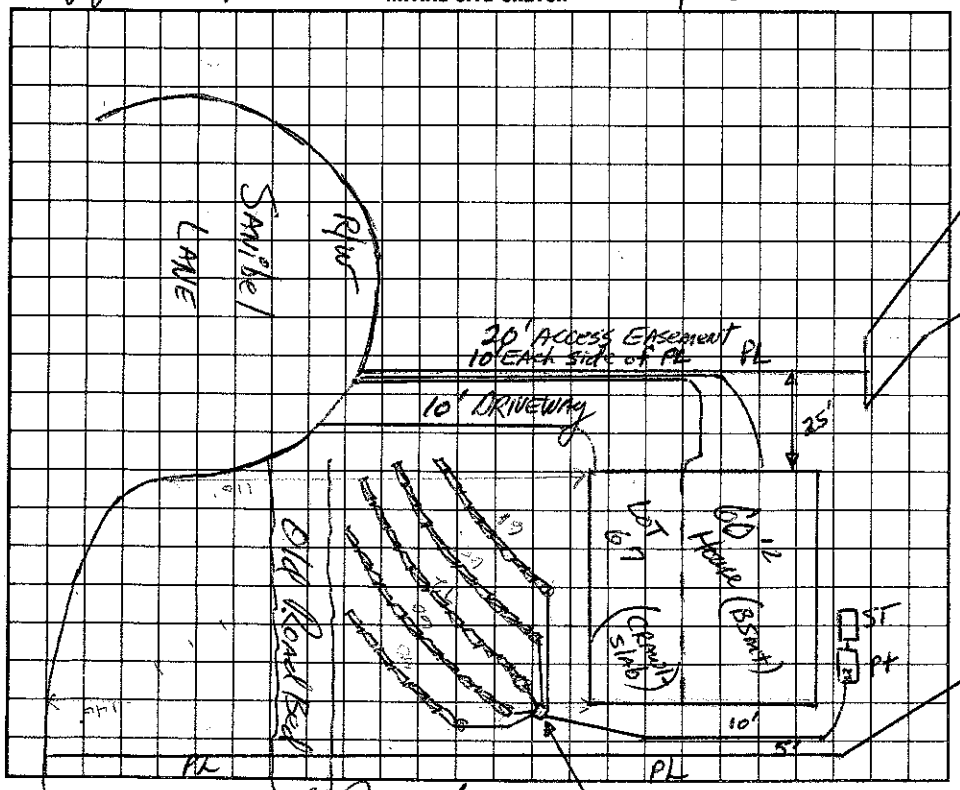

AS BUILT SKETCH

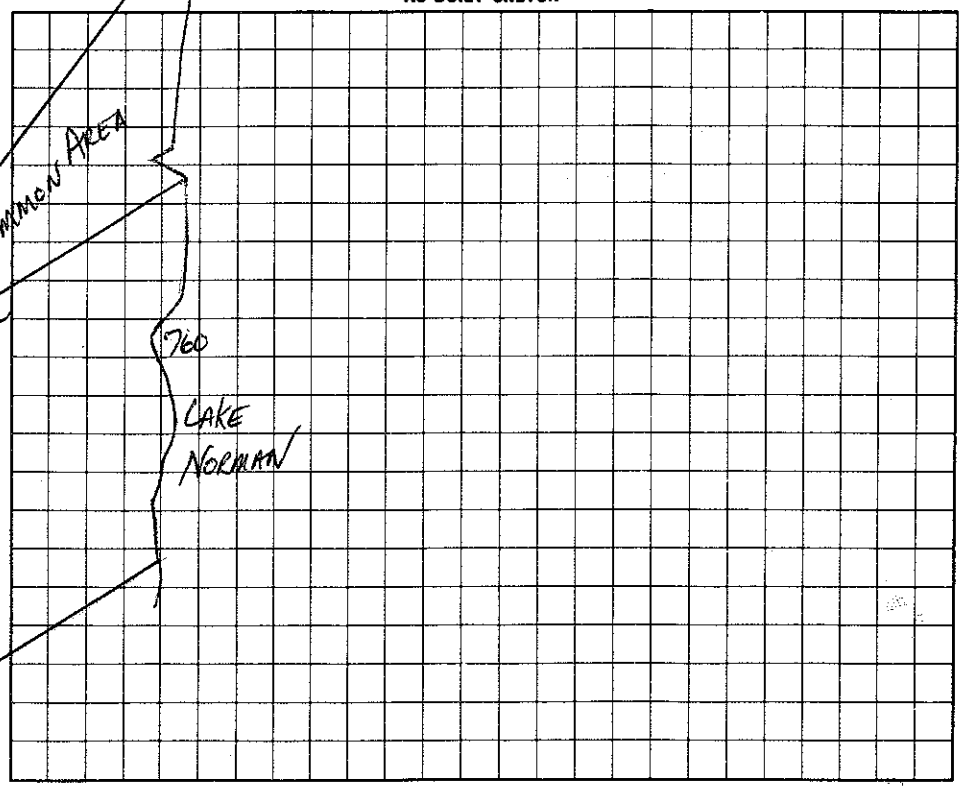

I understand that this permit can be suspended or revoked if any false information is supplied toward securing the permit/any unauthorized changes are made to the site/any unauthorized changes are made in the installation of the system.

Signed: _____ Control Gate Valve Box

Improvement Permit by: _____ date 6-13-96

Existing System Inspection by: _____ date 3-24-99

Authorization

Installed by: C & W Grading Co.

Certificate of Completion by: Wesley Sparkman date 7/5/00

Operation Permit by: Wesley Sparkman date 7/5/00

HEALTH DEPT. COPY: WHITE INSPECTION COPY (FINAL): GREEN OWNER COPY (FINAL): YELLOW INSPECTION COPY (INITIAL): PINK OWNER COPY (INITIAL): GOLD