# IREDELL COUNTY HEALTH DEPARTMENT

STATESVILLE 704-878-5305 MOORESVILLE 704-664-5281

## IMPROVEMENT PERMIT / AUTHORIZATION TO CONSTRUCT / OPERATION PERMIT / EXISTING SYSTEM INSPECTION

PERMIT # 10440 PIN # 4625 40 6421 DATE December 16, 2010

OWNER or APPLICANT Randy Stutts / ES Johnson Builders PHONE: Business 704-987-7950 Home: 704-201-2158

OWNER or APPLICANT ADDRESS 125 Thurston Way

LOCATION / DIRECTIONS Brawley Sch. Rd. TR Lightship TR Thurston on left

SUBDIVISION The Point BLOCK / SECTION 8 LOT # 827 LOT AREA .893Ac. DESIGN FLOW 480gpd L.T.A.R. .3gpd/ft²

Septic Tank 1500 Gallons: STB 338 Date 3-18-11

Pump Tank 1500 Gallons: PT 477 Date 3-13-11

Pump Make Gould Model WE05T2H40 Serial #

Nitrification Field No Fields 1 No Lines 4 Linear Feet 270

Trench Width 36" Max. Trench Bottom Depth 36" Gravel Depth NA

☒ New System ☐ Repair ☐ Expansion System Type I II III (IV) V VI

System Description: LPPPBPS

Repair System Description: LP PPBPS

Maintenance Agreement Required ☒ YES ☐ NO

☐ GRAVITY ☒ PRESSURE

☒ Residence No. Bedrooms 4

☐ Business No. Persons 8

☐ Other No. Employees

☐ Slab ☒ Crawl Space

☐ Basement w/plumbing ☐ Basement w/o plumbing

Water Supply: ☐ Private ☐ Public ☒ Community

Comments / Conditions

- Do not drive over septic area. Access by driveway only during construction


Comments / Conditions

Drilled 5/32" holes

5/9/11 Checked tanks & lines

3/15/12 Set 2ft pressure, checked alarm & float.

INITIAL SITE SKETCH

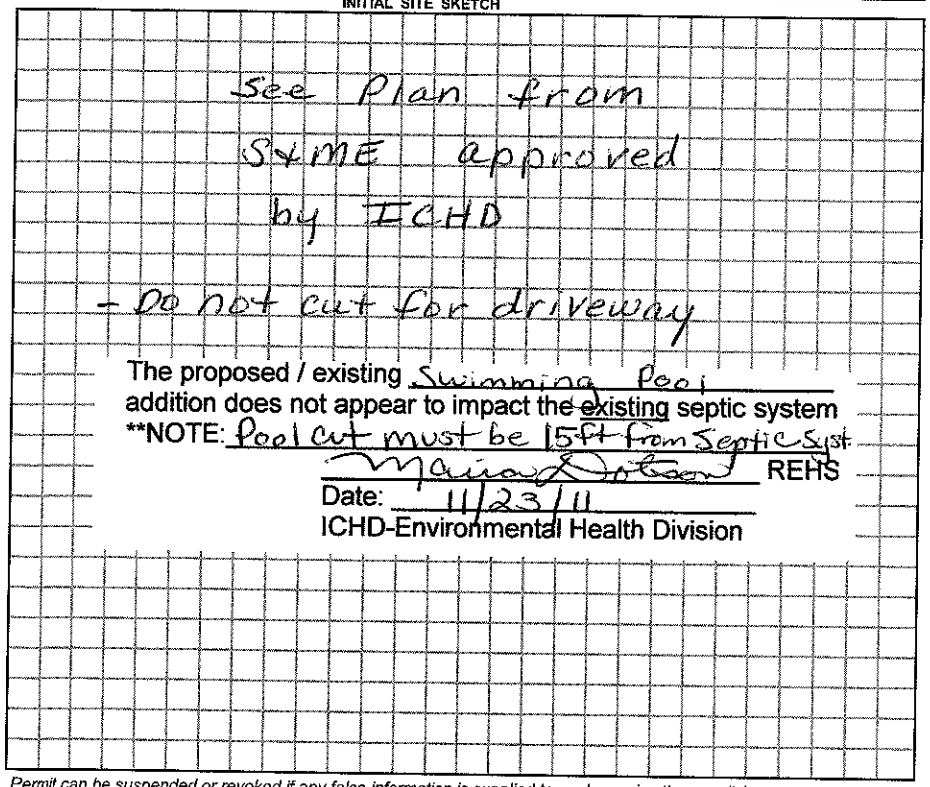


The proposed / existing Swimming Pool addition does not appear to impact the ~~existing~~ septic system


**NOTE: Pool cut must be 15ft from Septic Syst

Maria Dotson REHS

Date: 11/23/11

ICHD-Environmental Health Division

AS BUILT SKETCH

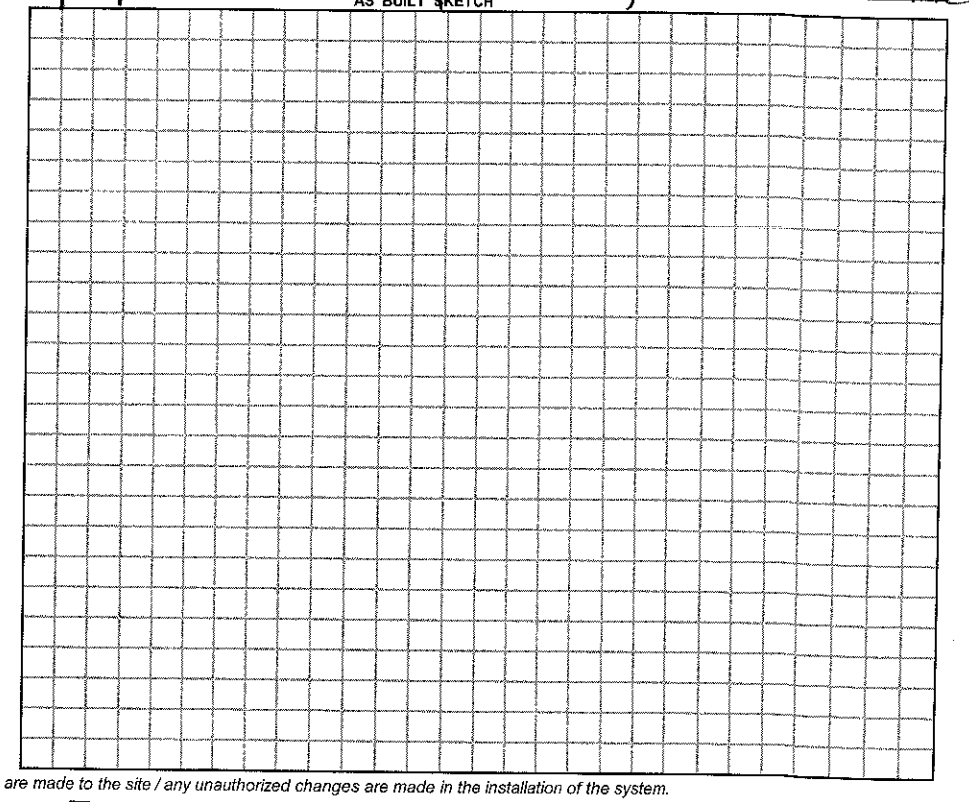

*Permit can be suspended or revoked if any false information is supplied toward securing the permit / any unauthorized changes are made to the site / any unauthorized changes are made in the installation of the system.*

☐ *IMPROVEMENT PERMIT w / plat valid without expiration.* ☒ *IMPROVEMENT PERMIT w / site plan valid for 60 mos.*

☐ *AUTHORIZATION TO CONSTRUCT valid for period equal to IMPROVEMENT PERMIT-not to exceed 60 mo.*

Owner / Applicant Signature: Date 12-16-10

Improvement Permit by: Judy Melville Date 12-16-10

Authorzation to Construct by: Judy Melville Date 12-16-10

***YOU SHOULD CONTACT A LOCATOR SERVICE PRIOR TO ANY EXCAVATION.***

Installed by: Willie Christenburg

Operation Permit by: Maria Dotson RS Date: 3/15/12

Existing System Inspected by: Date:

WHITE COPY Environmental Health YELLOW COPY (Final) Owner / Applicant PINK COPY (Initial) Owner / Applicant