3109

IREDELL COUNTY HEALTH DEPARTMENT

STATESVILLE 704-878-5305 MOORESVILLE 704-664-5281

IMPROVEMENT PERMIT / AUTHORIZATION TO CONSTRUCT / OPERATION PERMIT / EXISTING SYSTEM INSPECTION

PERMIT# 138689 PIN# 4625406615 DATE 1-10-07

OWNER OR APPLICANT ~~Ethel Custom Homes~~ / Robert Boykin PHONE: Business 704 987-5022 Home

ADDRESS PO Box 2393 Davidson NC 28036

LOCATION Brawley School Rd TR Lightship Dr. to end TR Thurston Ct.

SUBDIVISION The Point BLOCK / SECTION 8 LOT 826 LOT AREA 87,303 Ft² SITE CLASS PS DESIGN FLOW 480 L.T.A.R. .3

Septic Tank: 1000+ Gallons; ST# 338 Date 8-29-08

Pump Tank: 1000 Gallons; PT 283 Date 6-23-08

Pump Make: Goulds Model WE=0312 Serial No.

Nitrification Field: No Fields 1 Square Feet 1200' Linear Feet 400'

No Lines 5@80' Trench Width 36" Max Trench Bottom Depth 36"

X New System ☐ Repair ☐ Expansion System Type: I II III IV V VI

System Description: Pump-Rm - 25% Reduction

Repair System Description: Same

Maintenance Agreement Required: ☐ Yes X No

Gravel Depth N/A ☐ Gravity X Pressure

X House/Mod. Home ☐ Mobile Home ☐ Business ☐ Other

No. Bedrooms 4 No. Persons No. Employees

Water Supply: ☐ Individual X Public X Community

☐ Slab ☐ Crawl Space X Basement w/plumbing ☐ Basement wo/plumbing


Comments/Conditions: Lake Norman

Comments:/Conditions: Lake Norman 10/3/08 Check tanks


Note: Replaces prior permit issued 10-17-06; Tank location moved. 10/3/08 Checked lines Rick H

Scale 1:50

INITIAL SITE SKETCH

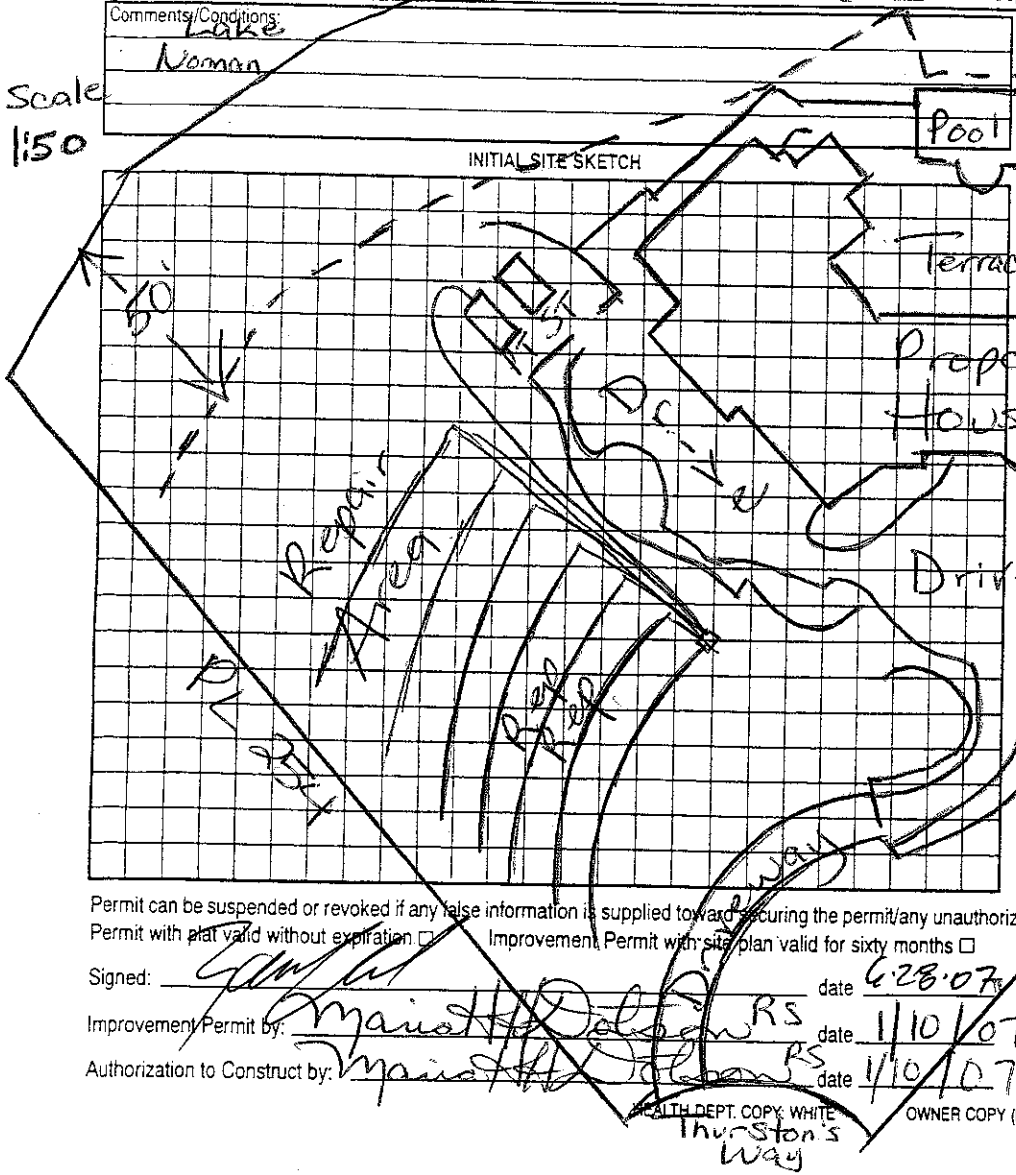

AS BUILT SKETCH

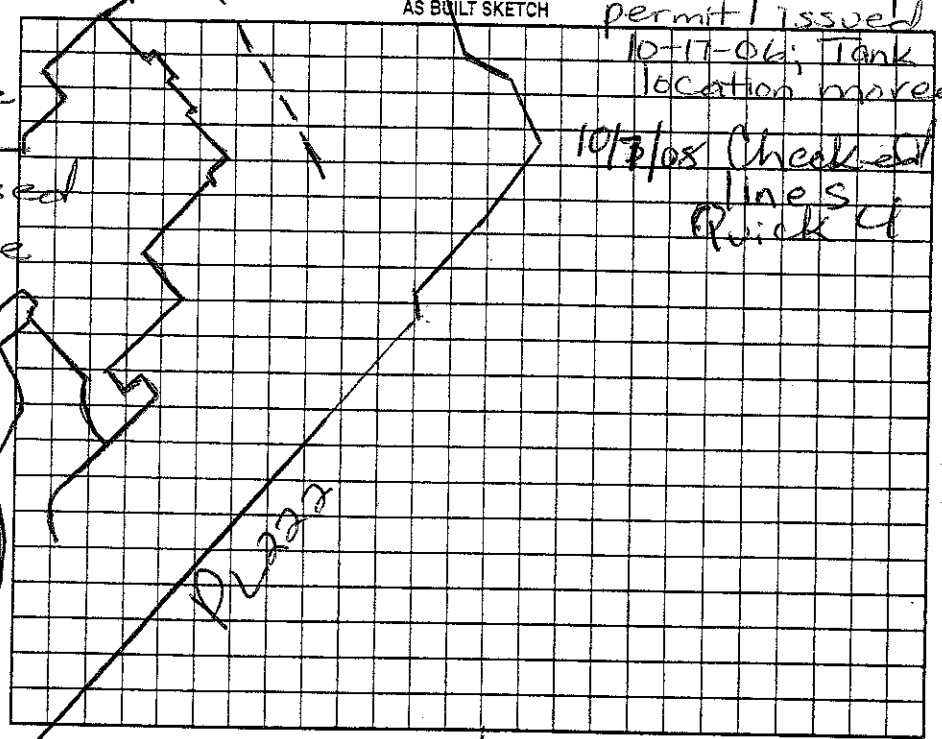

Permit can be suspended or revoked if any false information is supplied toward securing the permit/any unauthorized changes are made to the site/any unauthorized changes are made in the installation of the system. Improvement Permit with plat valid without expiration ☐ Improvement Permit with site plan valid for sixty months ☐ Authorization to Construct is valid for a period equal to that of Improvement Permit – not to exceed sixty months.

Signed: date 6-28-07

Improvement Permit by: Maria H. Dalton RS date 1/10/07

Authorization to Construct by: Maria H. Dalton RS date 1/10/07

Installed by:

Operation Permit by: Wesley Sparks RS. date 12/22/08

Existing System Inspection by: date

HEALTH DEPT. COPY: WHITE OWNER COPY (FINAL): YELLOW OWNER COPY (INITIAL): PINK