122412

# IREDELL COUNTY HEALTH DEPARTMENT

STATESVILLE 704-878-5305 50.00 fa.d MOORESVILLE 704-664-5281

## IMPROVEMENT PERMIT / AUTHORIZATION TO CONSTRUCT / OPERATION PERMIT / EXISTING SYSTEM INSPECTION

PERMIT# 101232 PIN# ~~4625-94-1681.829~~ 4625-40-8120 DATE 6/22/04

OWNER OR CONTRACTOR O M Holmes Const. PHONE: Business 704-895-9000 Home

ADDRESS 18518 Statesville Rd. Cornelius, NC. 28031

LOCATION 1100 TR Lightship Dr. TL Swayne St. TR Thurston Ct. on (L)

SUBDIVISION Point BLOCK / SECTION E LOT 829 LOT AREA 42,885 SITE CLASS. PS DESIGN FLOW 480 L.T.A.R. .3

Septic Tank: 1500 Gallons; STB 338 Date 8-1-04
Pump Tank: 1000 Gallons; PT 477 Date 8-1-04
Pump Make: Goulds Model WED312M1 Serial No.
Nitrification Field: No Fields 1 Square Feet 1200 Linear Feet 400
No Lines 4@100 Trench Width 3 Max Trench Bottom Depth 3 Gravel Depth No

[X] New System [ ] Repair System Type: I, II, (III) IV, V, VI
System Description: PreMan - Type 3
Repair System Description: Pressurized - 16" PP3RS
Maintenance Agreement Required: [ ] Yes [X] No


[X] House/Mod. Home No. Bedrooms 4
[ ] Mobile Home No. Bathrooms 4.5
[ ] Business No. Employees
[ ] Other
[ ] Slab [ ] Crawl Space [X] Basement w/plumbing [ ] Basement wo/plumbing

Water Supply: [ ] Individual [ ] Public [X] Community CL+T


Comments:/Conditions:

Comments:/Conditions: Checked tanks & lines 9/3/04
Pressure Checked 2/17/05

INITIAL SITE SKETCH

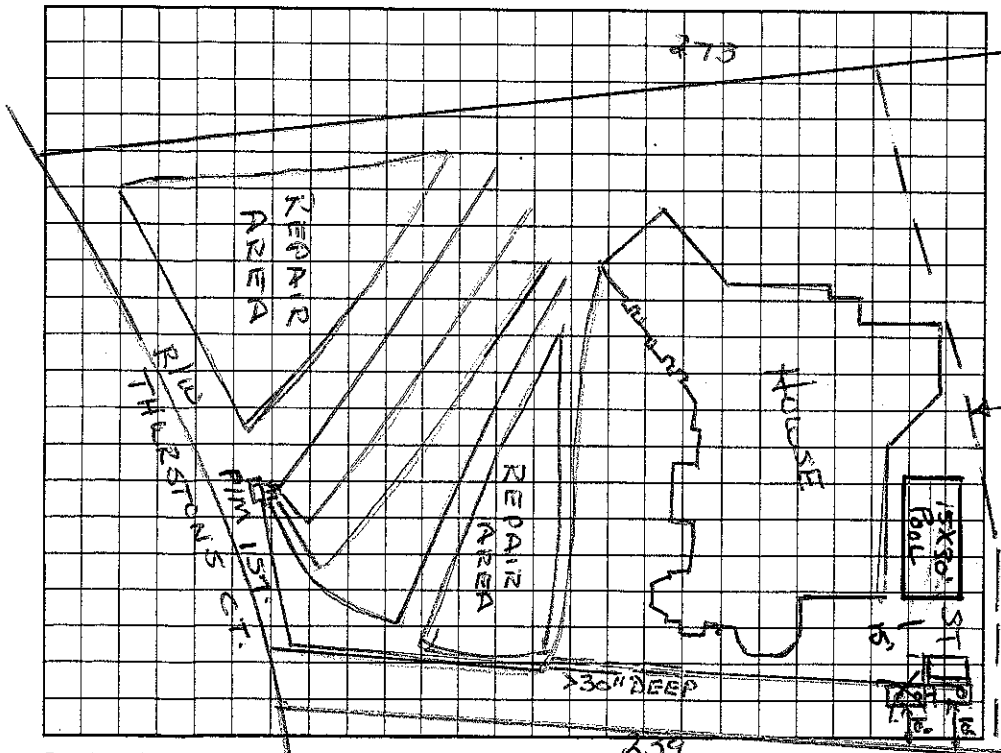


AS BUILT SKETCH

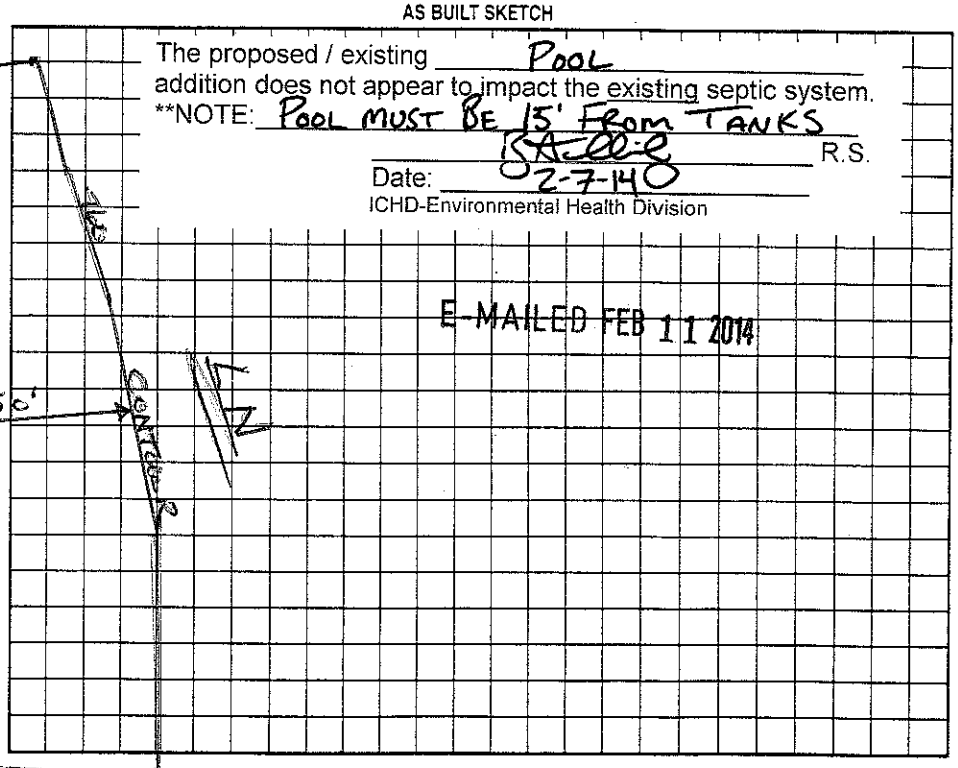


The proposed / existing Pool addition does not appear to impact the existing septic system.
**NOTE: Pool must be 15' from tanks
15A-18.8 R.S.
Date: 2-7-14
ICHD-Environmental Health Division

E-MAILED FEB 11 2014

Permit can be suspended or revoked if any false information is supplied toward securing the permit/any unauthorized changes are made to the site/any unauthorized changes are made in the installation of the system. Improvement Permit with plat valid without expiration. Improvement Permit with site plan valid for sixty months. Authorization to Construct is valid for a period equal to that of Improvement Permit – not to exceed sixty months.

Signed: O M Holmes date 6-28-04
Improvement Permit by: Wesley Sparks R.S. date 6/22/04
Authorization to Construct by: Wesley Sparks R.S. date 6/22/04

Installed by: R & H Dotson
Operation Permit by: Maria H Dotson date 3-05
Existing System Inspection by: date

HEALTH DEPT. COPY: WHITE OWNER COPY (FINAL): YELLOW OWNER COPY (INITIAL): PINK