IREDELL COUNTY HEALTH DEPARTMENT

Const. Auth. STATESVILLE 704-878-5305 MOORESVILLE 704-664-5281

IMPROVEMENT PERMIT / ~~CERTIFICATE OF COMPLETION~~ / OPERATION PERMIT / EXISTING SYSTEM INSPECTION

PROPERTY DESCRIPTION NO. 25776 DATE May 20, '97 TAX MAP NO. ~~part of 2CA3~~ 4625-46-6789 Watershed: ☑ Yes ☐ No

OWNER OR CONTRACTOR Crescent Resources Inc. // Jim Feldman PHONE: Business _____ Home _____

ADDRESS PO Box 1003, Charlotte

LOCATION Brawley Sch Rd. TR Bay Harbour TL Lake Mist AT END

SUBDIVISION The Harbour BLOCK / SECTION 4 LOT 19, 19A LOT AREA ~1Ac SITE CLASS. PS DESIGN FLOW 480gpd L.T.A.R. .3

Septic Tank: 1000 Gallons; STB 794 Date 3/24/00

Pump Tank: 1000 Gallons; PT 27 Date 4/18/00

Pump Make: SHEF LOCAT Model HYDROMATIC Serial No. 1/00

Nitrification Field: No Fields 1 Square Feet 1200 Linear Feet 400

No Lines 5@80' Trench Width 36" Max Trench Bottom Depth 36" Gravel Depth N/A

☑ New System ☐ Repair System Type: I, II, III, IV, V, VI

System Description: 9m chambers

Repair System Description: Same

Maintenance Agreement Required: ☐ Yes ☑ No

☑ House/Mod. Home No. Bedrooms 4

☐ Mobile Home No. Bathrooms 4

☐ Business No. Employees ____

☐ Other ____


☐ Slab ☐ Crawl Space ☑ Basement w/plumbing ☐ Basement wo/plumbing

Water Supply: ☐ Individual ☑ Community ☐ Public


Comments: 11-30-99 Reviewed house & site plan; appears in compliance w/ IP. JRH

Comments: Tank location change OK'd to avoid driveway AWS

INITIAL SITE SKETCH

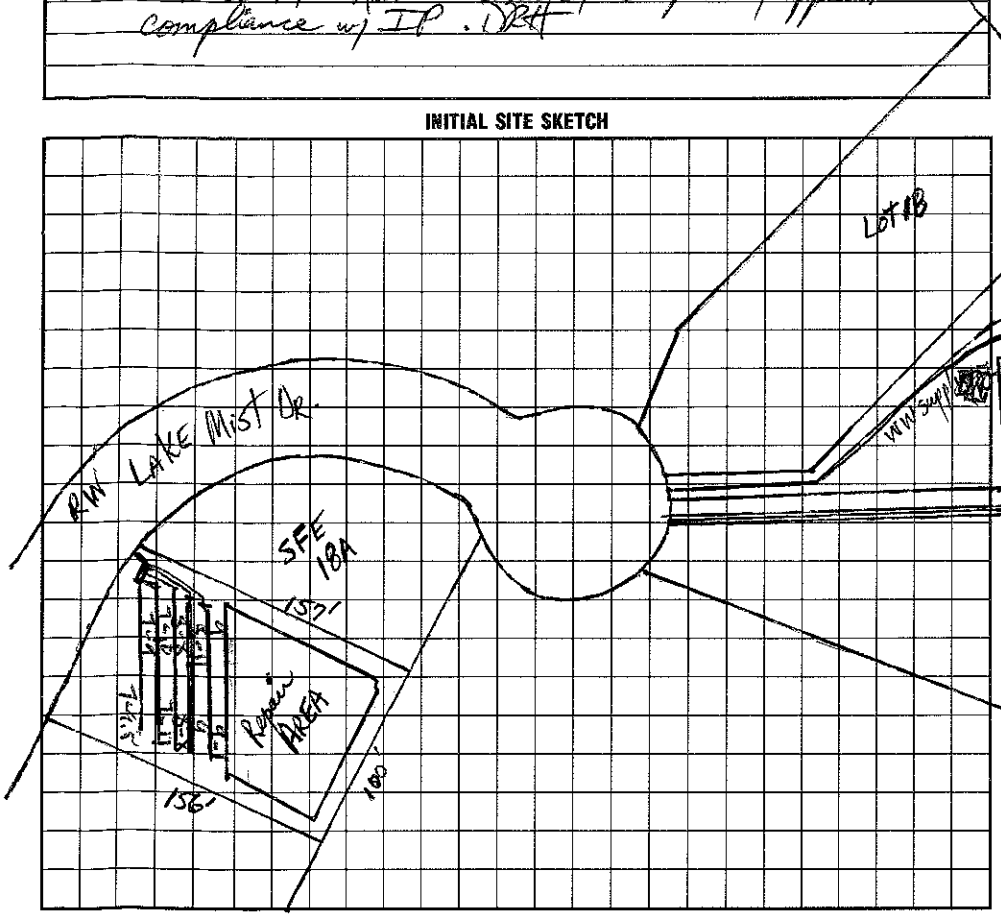

AS BUILT SKETCH

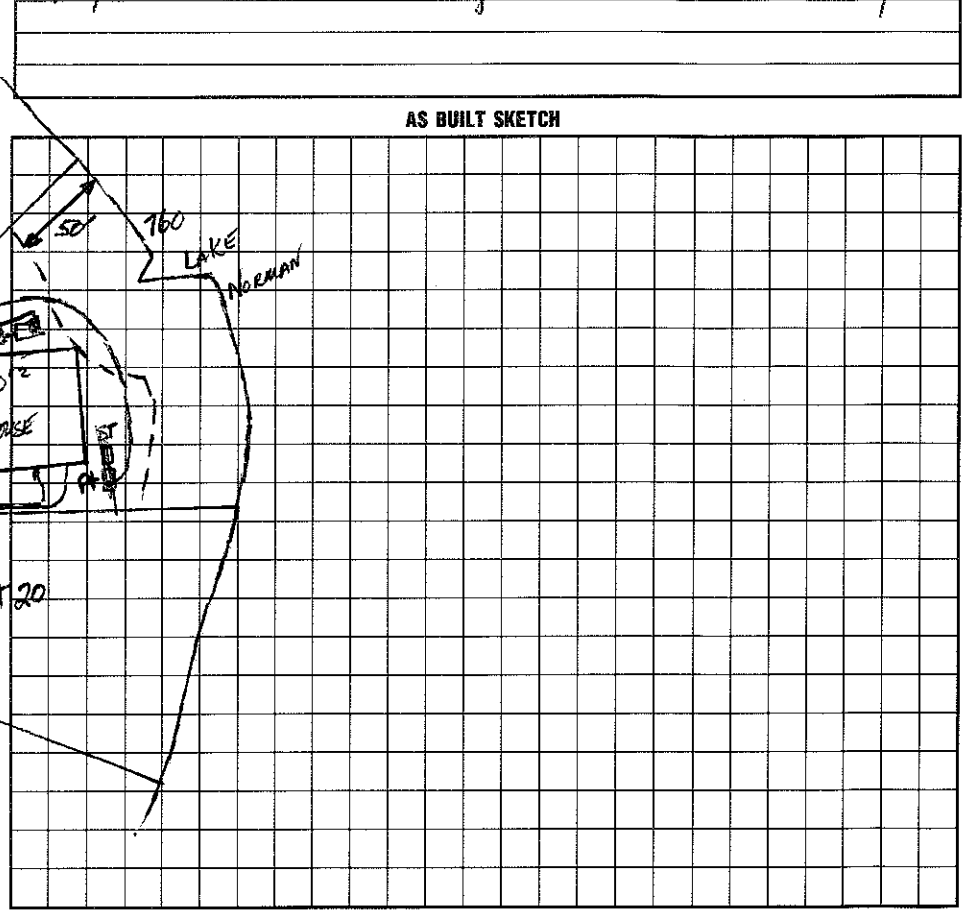

I understand that this permit can be suspended or revoked if any false information is supplied toward securing the permit/any unauthorized changes are made to the site/any unauthorized changes are made in the installation of the system. Improvement Permit is valid for 60 months from date of issuance.

Signed: X

Improvement Permit by: JR Thomson, RS date 5-20-97

~~Construction~~ ~~Existing System Inspection by~~: Mark JR Thomson, RS date 11-30-99

Authorization

Installed by: MacLeod Const. Co.

Certificate of Completion by: Wesley Sparks RS. date 7/10/00

Operation Permit by: Wesley Sparks RS. date 7/10/00

HEALTH DEPT. COPY: WHITE INSPECTION COPY (FINAL): GREEN OWNER COPY (FINAL): YELLOW INSPECTION COPY (INITIAL): PINK OWNER COPY (INITIAL): GOLD