IREDELL COUNTY HEALTH DEPARTMENT Const. Auth. STATESVILLE 704-878-5305 MOORESVILLE 704-664-5281

IMPROVEMENT PERMIT / ~~CERTIFICATE OF COMPLETION~~ / OPERATION PERMIT / EXISTING SYSTEM INSPECTION

PROPERTY DESCRIPTION NO. 25773 DATE May 19, '97 TAX MAP NO. part of 2CA3 4625 46 9662 Watershed: ☑ Yes ☐ No

OWNER OR CONTRACTOR Crescent Resources Inc. John Wieland Homes PHONE: Business _____ Home _____

ADDRESS PO Box 1003, Charlotte


SUBDIVISION The Harbours BLOCK / SECTION 4 LOT 16, 16A LOT AREA ~ 1Ac. SITE CLASS PS DESIGN FLOW 480gpd L.T.A.R. no. 3

Septic Tank: 1000 Gallons; STB 794 Date 4/2/99

Pump Tank: 1000 Gallons; PT 29 Date 4/2/99

Pump Make: ~~HYDROMATIC~~ Model ~~SHEFSOA~~ Serial No. 5/99

Nitrification Field: No Fields 1 Square Feet 1200 Linear Feet 400

No Lines 4@100' Trench Width 36" Trench Bottom Depth 36" Gravel Depth NA

☐ New System ☐ Repair System Type: I, II, (III) IV, V, VI

System Description: pm - chambered on 16A

Repair System Description: LPPBPS on 16A

Maintenance Agreement Required: ☐ Yes ☑ No initial system

☑ House/Mod. Home No. Bedrooms 4

☐ Mobile Home No. Bathrooms 4

☐ Business No. Employees ____

☐ Other ____

☐ Slab ☐ Crawl Space ☑ Basement w/plumbing ☐ Basement wo/plumbing


Water Supply: ☐ Individual ☑ Community ☐ Public

Comments: Remove berm in septic field easement.
* ONE inspection/observation port per LATERAL


Comments:

1" ≈ 100'

INITIAL SITE SKETCH

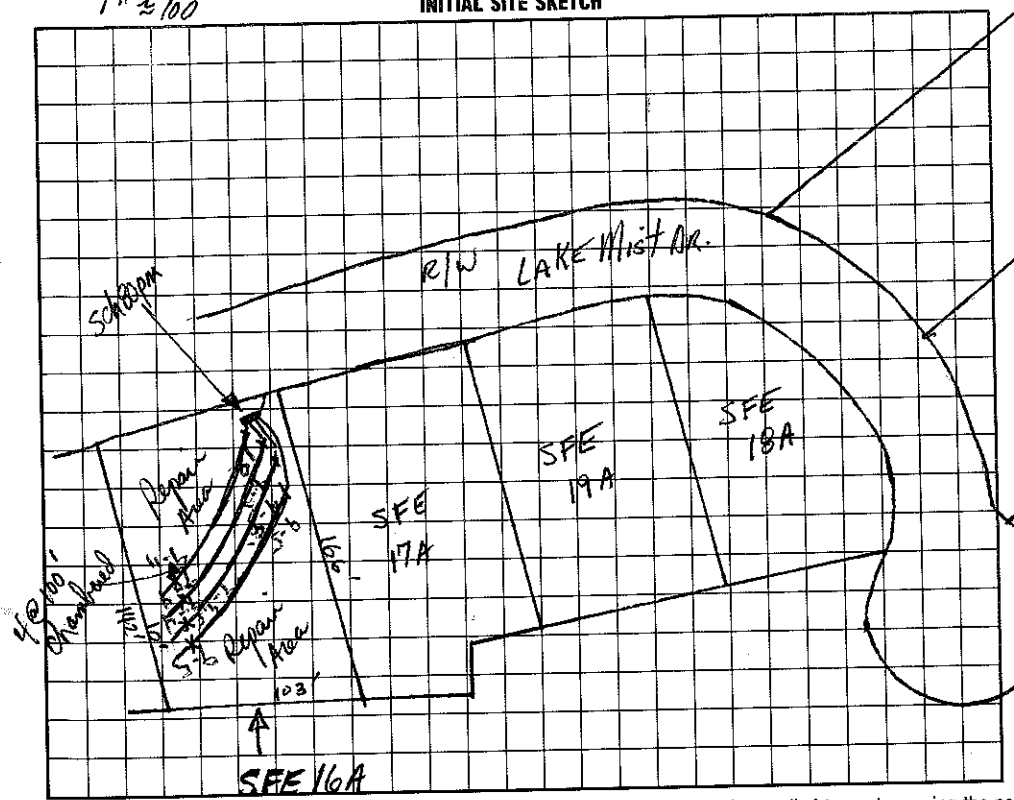

AS BUILT SKETCH

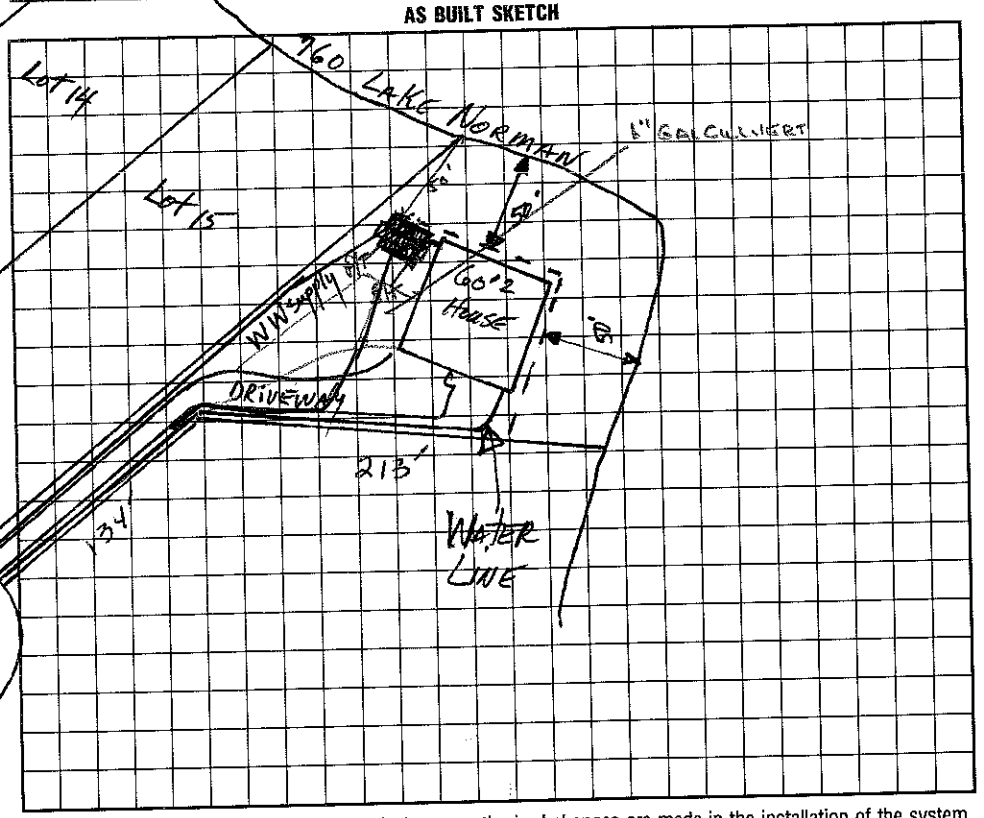

I understand that this permit can be suspended or revoked if any false information is supplied toward securing the permit/any unauthorized changes are made to the site/any unauthorized changes are made in the installation of the system. Improvement Permit is valid for 60 months from date of issuance.

Signed: _____

Improvement Permit by: _____ date 5/19/97

~~Existing System Inspection~~ CONSTRUCTION AUTHORIZATION by: Wesley Sparks RS. date 10/21/98

Installed by: Mashead Const.

Certificate of Completion by: Wesley Sparks RS. date 8/30/99

Operation Permit by: Wesley Sparks RS. date 8/30/99

HEALTH DEPT. COPY: WHITE INSPECTION COPY (FINAL): GREEN OWNER COPY (FINAL): YELLOW INSPECTION COPY (INITIAL): PINK OWNER COPY (INITIAL): GOLD