IREDELL COUNTY HEALTH DEPARTMENT
Const. Auth

STATESVILLE 704-878-5305 MOORESVILLE 704-664-5281

IMPROVEMENT PERMIT / ~~CERTIFICATE OF COMPLETION~~ / OPERATION PERMIT / EXISTING SYSTEM INSPECTION

PROPERTY DESCRIPTION NO. 25779 DATE May 21, '97 TAX MAP NO. part of 2CA3 4625474562 Watershed: ☑ Yes ☐ No

OWNER OR CONTRACTOR ~~Crescent Resources Inc~~ (MI HOMES) PHONE: Business ______ Home ______

ADDRESS PO Box 1003, Charlotte

LOCATION Brawley Sch Rd. TR Bay Harbour TR Lake Mist TR Silver Eagle at end

SUBDIVISION The Harbour BLOCK / SECTION 4 LOT 29, 29A LOT AREA ~1 Ac SITE CLASS. PS DESIGN FLOW 480 gpd L.T.A.R. ~.3

Septic Tank: 1000 Gallons; STB 794 Date 7/98

Pump Tank: 1000 Gallons; PT 27 Date 7/98

Pump Make: Hydromatic Model SHEF 5 Serial No. 7/98

Nitrification Field: No Fields 1 Square Feet 1200 Linear Feet 400

No Lines 4 @ 100' Trench Width 36" Max Trench Bottom Depth 36" Gravel Depth NA

☑ New System ☐ Repair System Type: I, II, (III), IV, V, VI

System Description: PM Chambered on 29A

Repair System Description: LP Panel Block on 29A

Maintenance Agreement Required: ☐ Yes ☑ No

☐ Slab ☐ Crawl Space ☑ Basement w/plumbing ☐ Basement wo/plumbing

☑ House/Mod. Home ☐ Mobile Home ☐ Business ☐ Other

No. Bedrooms 4 No. Bathrooms 4 No. Employees ______


Water Supply: ☐ Individual ☑ Community ☐ Public

Comments: * ONE inspection/observation port per LATERAL

Comments:

1" ≈ 100'

INITIAL SITE SKETCH

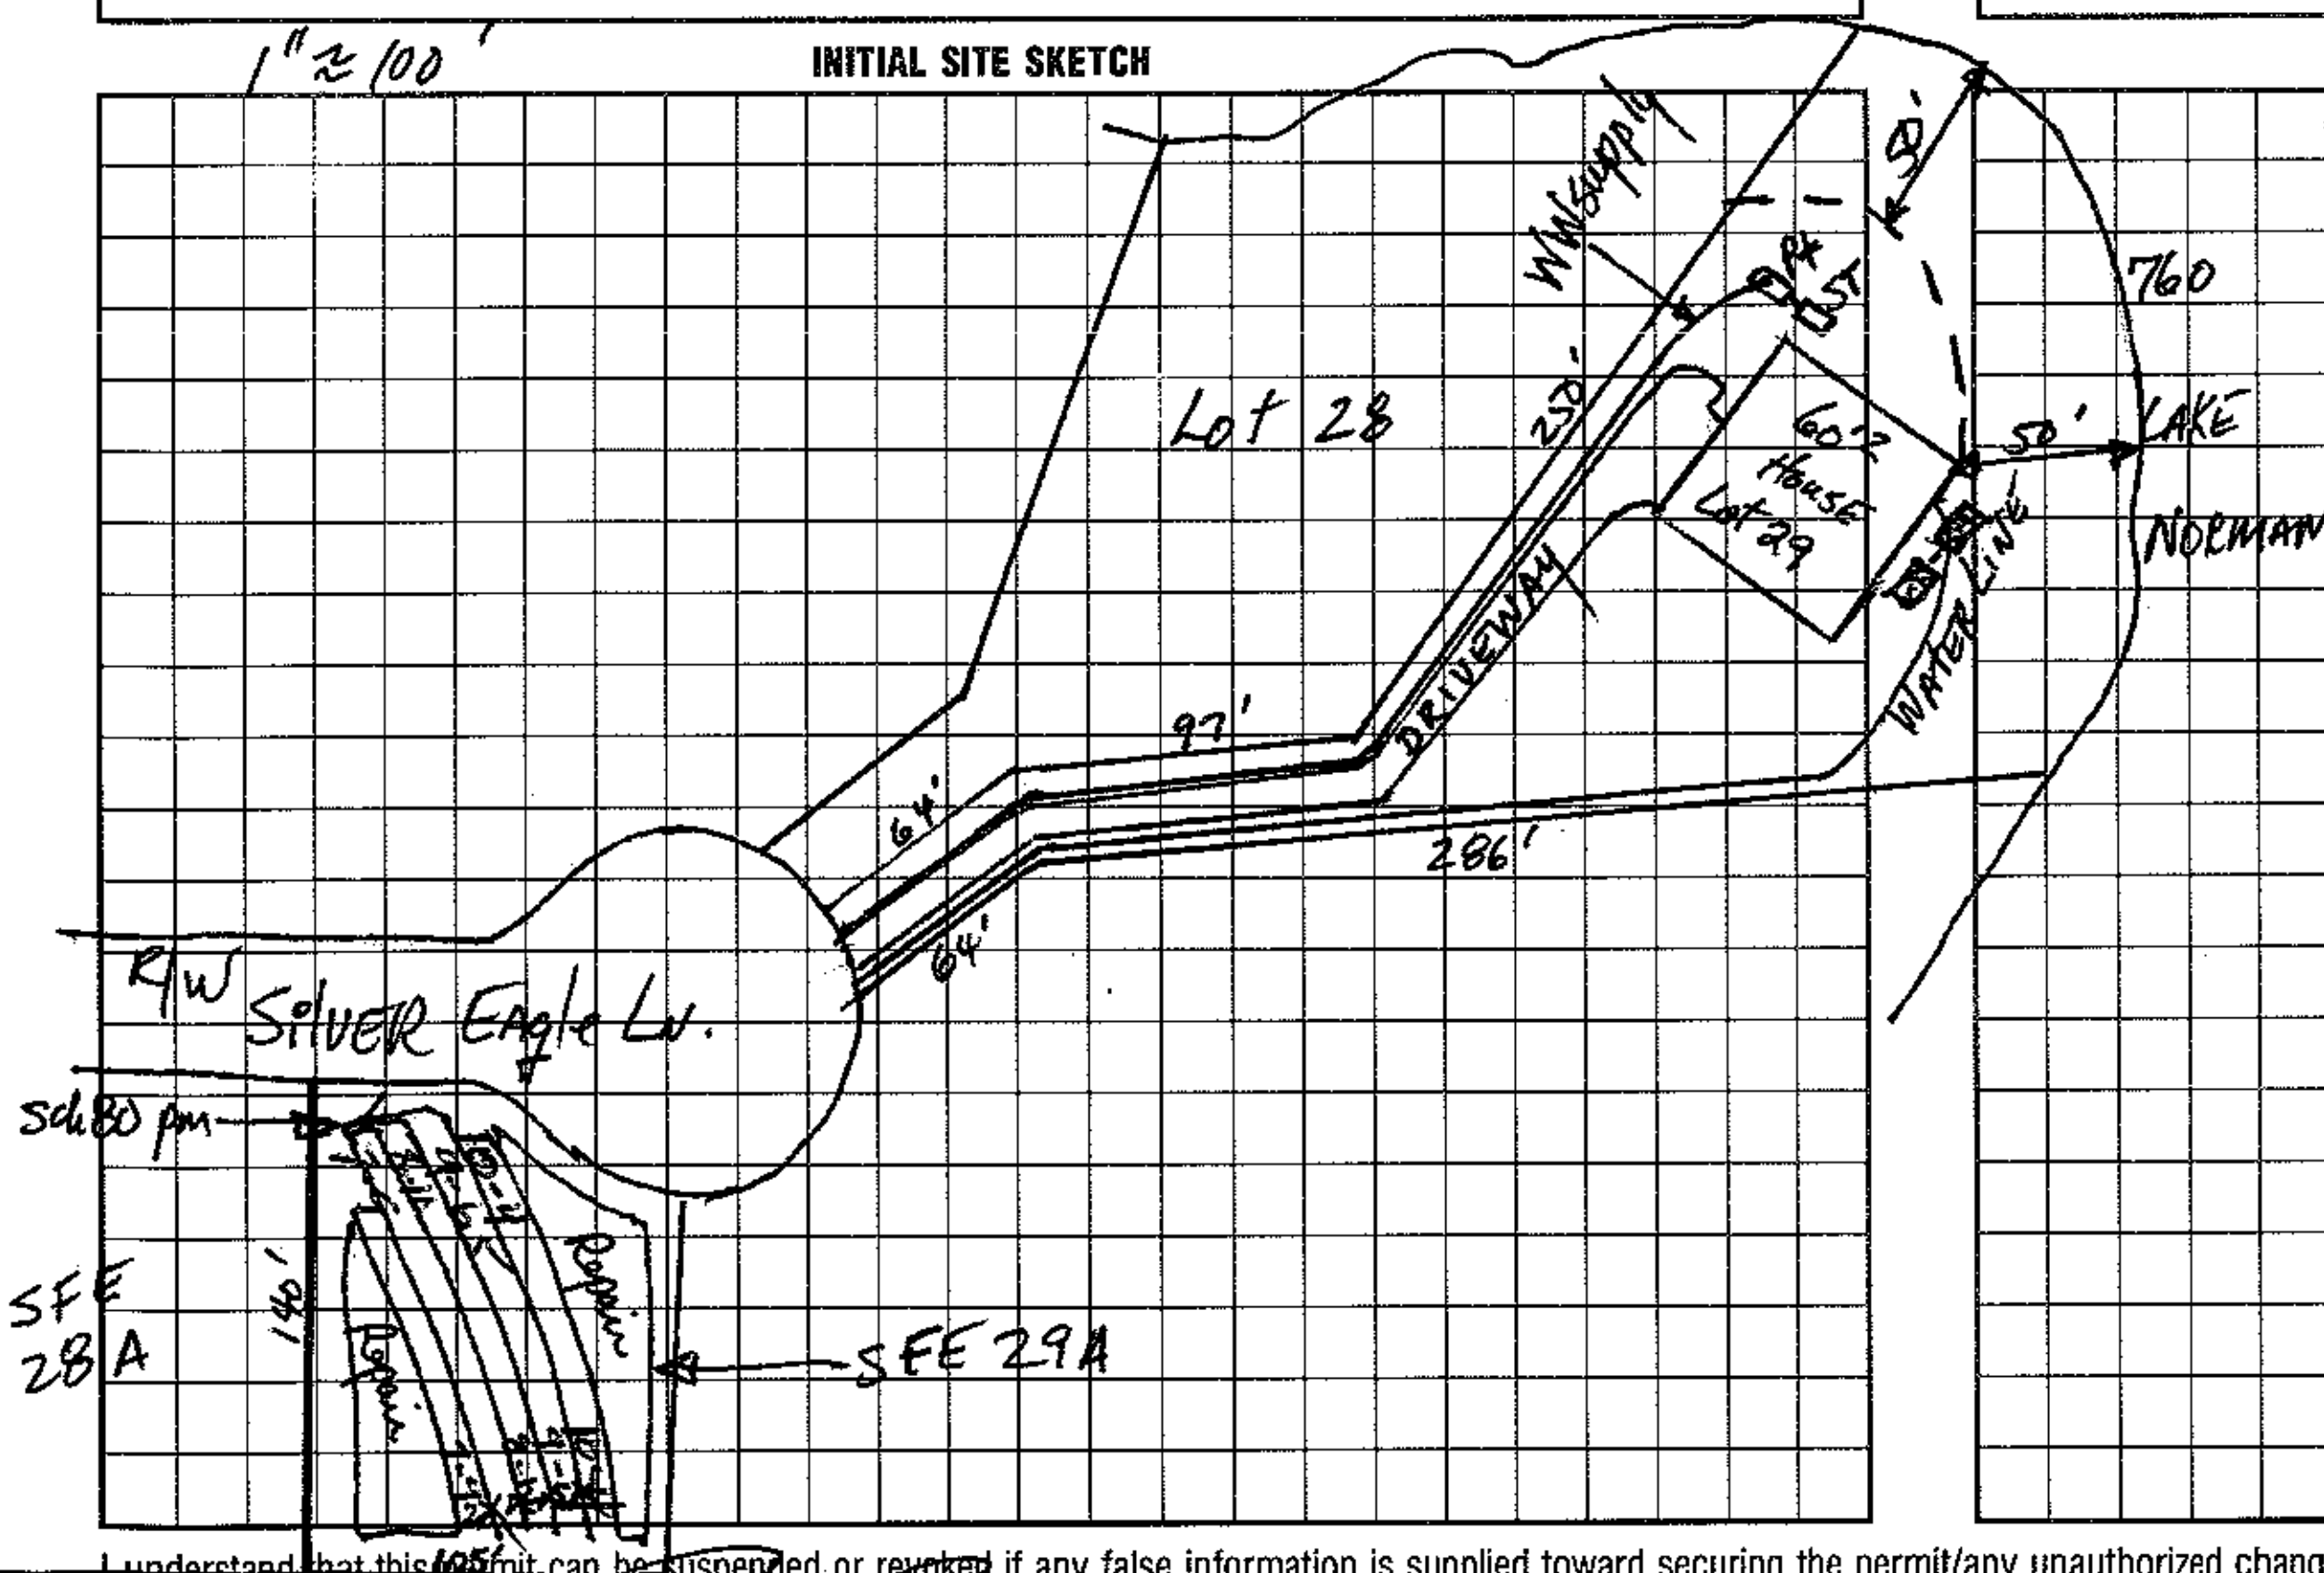

AS BUILT SKETCH

I understand that this permit can be suspended or revoked if any false information is supplied toward securing the permit/any unauthorized changes are made to the site/any unauthorized changes are made in the installation of the system. Improvement Permit is valid for 60 months from date of issuance.

Signed: * [signature]

Improvement Permit by: [signature], RS date 5-21-97

~~Existing System Inspection by:~~ Construction Authorization date ______

Installed by: MacLeod

Certificate of Completion by: ______ date ______

Operation Permit by: Wesley Sparks RS date 10/22/98

HEALTH DEPT. COPY: WHITE INSPECTION COPY (FINAL): GREEN OWNER COPY (FINAL): YELLOW INSPECTION COPY (INITIAL): PINK OWNER COPY (INITIAL): GOLD