IREDELL COUNTY HEALTH DEPARTMENT Const. Auth. STATESVILLE 704-878-5305 MOORESVILLE 704-664-5281

IMPROVEMENT PERMIT / ~~CERTIFICATE OF COMPLETION~~ / OPERATION PERMIT / EXISTING SYSTEM INSPECTION

PROPERTY DESCRIPTION NO. 25778 DATE May 21, '97 TAX MAP NO. part of 9CA3 4625 47 5485 Watershed: ☑ Yes ☐ No

OWNER OR CONTRACTOR Crescent Resources Inc. // M/I Homes PHONE: Business _____ Home _____

ADDRESS PO Box 1003, Charlotte

LOCATION Brawley Sch. Rd. TR Bay Harbour TL Lake Mist TR Silver Eagle At End

SUBDIVISION The Harbour BLOCK / SECTION 4 LOT 28,28A LOT AREA ~1 ac SITE CLASS. #5 DESIGN FLOW 480gpd L.T.A.R. .3

Septic Tank: 1000 Gallons; STB 794 Date 8/4/98

Pump Tank: 1000 Gallons; PT 27 Date 9/28/98

Pump Make: SHEF50A1 Model H-4DRC Serial No. 10198

Nitrification Field: No Fields 1 Square Feet 1200 Linear Feet 400

No Lines 4@100' Trench Width 36" Max Trench Bottom Depth 36" Gravel Depth N/A

☑ New System ☐ Repair System Type: I, II, (III), IV, V, VI

System Description: P.M. Chambered on 28A

Repair System Description: LP Panel Block on 28A

Maintenance Agreement Required: ☐ Yes ☑ No

☑ House/Mod. Home No. Bedrooms 4

☐ Mobile Home No. Bathrooms 4

☐ Business No. Employees _____

☑ Other _____


☐ Slab ☐ Crawl Space ☑ Basement w/plumbing ☐ Basement wo/plumbing

Water Supply:
☐ Individual
☑ Community
☐ Public

Comments:

Comments:

INITIAL SITE SKETCH

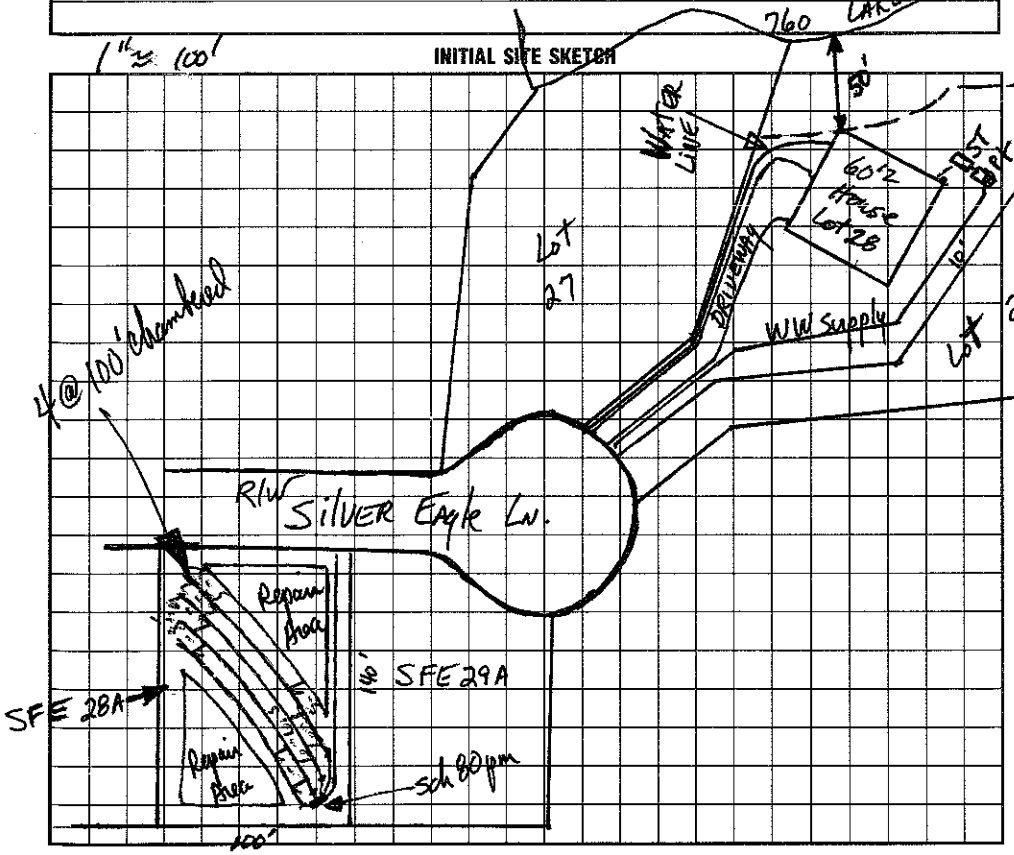

AS BUILT SKETCH

I understand that this permit can be suspended or revoked if any false information is supplied toward securing the permit/any unauthorized changes are made to the site/any unauthorized changes are made in the installation of the system. Improvement Permit is valid for 60 months from date of issuance.

Signed: _____

Improvement Permit by: _____ date 5-21-97

~~Existing System Inspection by~~ Construction Authorization by: _____ date 4-9-98

Installed by: Macleod Const.

Certificate of Completion by: _____ date _____

Operation Permit by: Wesley Sparks RS date 12/21/98

HEALTH DEPT. COPY: WHITE INSPECTION COPY (FINAL): GREEN OWNER COPY (FINAL): YELLOW INSPECTION COPY (INITIAL): PINK OWNER COPY (INITIAL): GOLD